1:30

IREDELL COUNTY HEALTH DEPARTMENT

STATESVILLE 704-878-5305 MOORESVILLE 704-664-5281

IMPROVEMENT PERMIT / AUTHORIZATION TO CONSTRUCT / OPERATION PERMIT / EXISTING SYSTEM INSPECTION

PERMIT # Repair PIN # 4636208775 DATE 10-11-2010

OWNER or APPLICANT Mike & Stefanie Storm PHONE: Business 704 519-7025 Home: 704 658-1130

OWNER or APPLICANT ADDRESS 118 High Sail Ct. Mooresville, NC 28117

LOCATION / DIRECTIONS Brawley School Rd TL Isle of Pines TR ~~High Sail Ct~~ Cove Creek TR High Sail Ct on Rt.

SUBDIVISION North Shore BLOCK / SECTION LOT # 4 LOT AREA .60Ac DESIGN FLOW 480 L.T.A.R. .3

Replace Exist ST

Septic Tank ~~1000~~ Gallons: STB 444 Date 8-11-10

Pump Tank 1500 Gallons: P T Date

Pump Make Model Serial #

Nitrification Field No Fields 1 No Lines 5 Linear Feet 540

Trench Width 36" Max. Trench Bottom Depth 36" Gravel Depth 12"

☐ New System ☒ Repair ☐ Expansion System Type I II III IV V VI

System Description: ST only Gravity – Convent.

Repair System Description: Pump – 50% Reduct.

Maintenance Agreement Required ☐ YES ☒ NO

☒ GRAVITY ☐ PRESSURE

☒ Residence No. Bedrooms 4

☐ Business No. Persons

☐ Other No. Employees

☐ Slab ☐ Crawl Space


☐ Basement w/plumbing ☐ Basement w/o plumbing

Water Supply: ☐ Private ☐ Public ☒ Community


Comments / Conditions: Replace Existing ST with New ST. Install in same place to get fall from ST to Drainfield. *Must keep ST shallow.

Comments / Conditions: Original permit attached Reinstalled 11/8" Fall between ~~House~~ ST & D-box Pipe levell btw House & ST

INITIAL SITE SKETCH

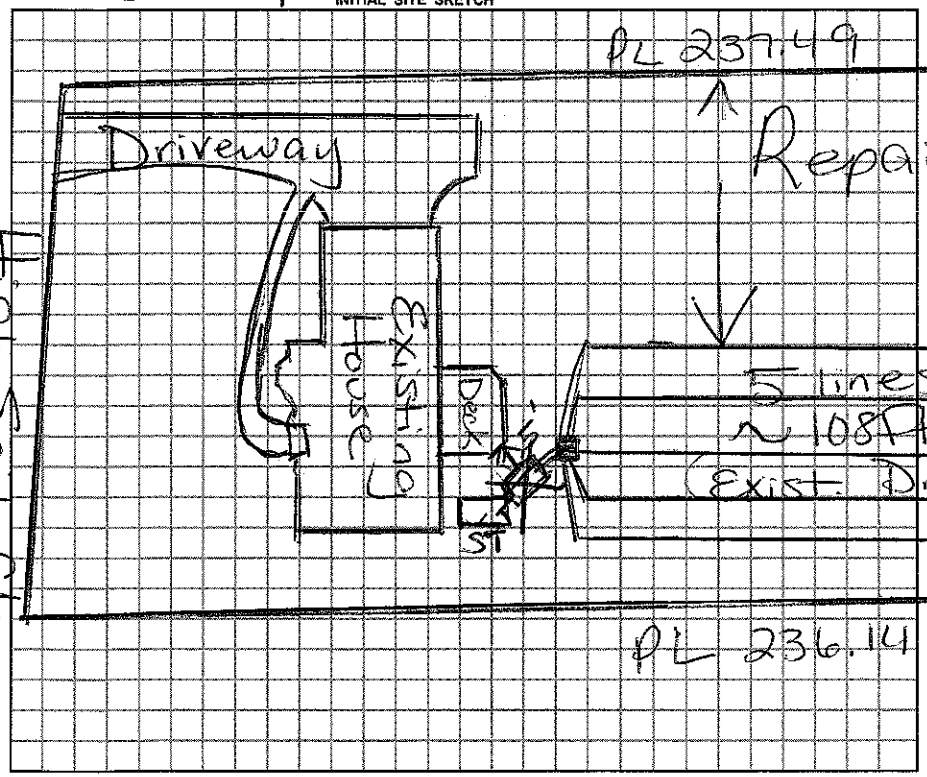

AS BUILT SKETCH

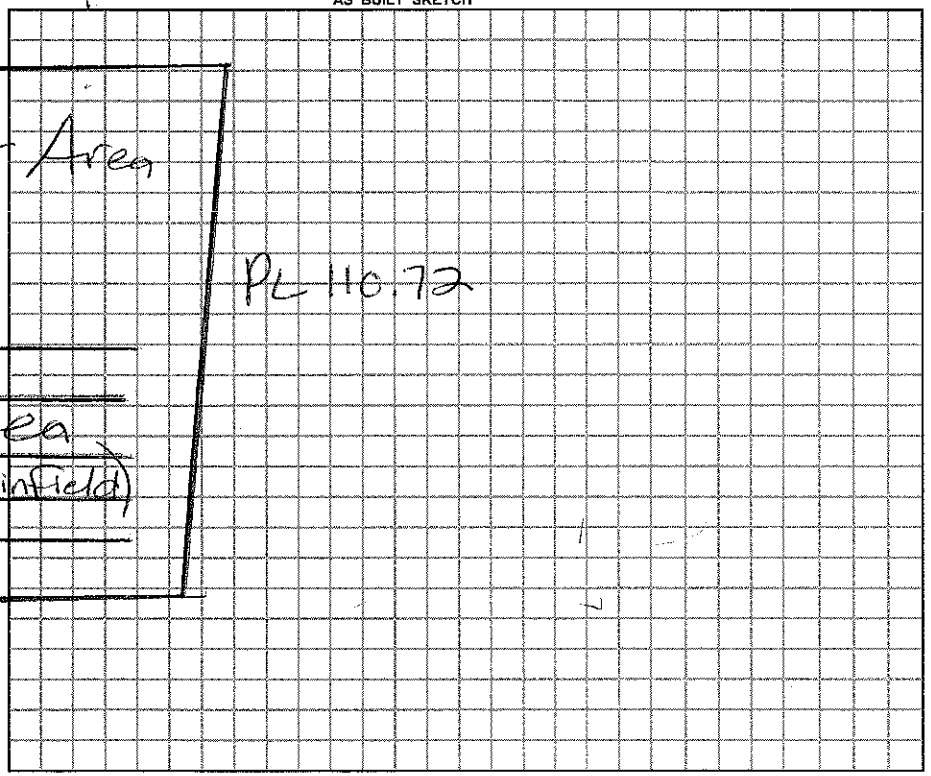

Permit can be suspended or revoked if any false information is supplied toward securing the permit / any unauthorized changes are made to the site / any unauthorized changes are made in the installation of the system.

☐ *IMPROVEMENT PERMIT w / plat valid without expiration.* ☐ *IMPROVEMENT PERMIT w / site plan valid for 60 mos.* ☐ *AUTHORIZATION TO CONSTRUCT valid for period equal to IMPROVEMENT PERMIT-not to exceed 60 mo.*

Owner / Applicant Signature: [signature] Date 10/18/2010 Installed by: 1st Choice Septic

Improvement Permit by: [signature] REHS Date 10/11/2010 Operation Permit by: [signature] REHS Date: 11/15/2010

Authorzation to Construct by: [signature] REHS Date 10/11/2010 Existing System Inspected by: Date:

YOU SHOULD CONTACT A LOCATOR SERVICE PRIOR TO ANY EXCAVATION.

WHITE COPY Environmental Health YELLOW COPY (Final) Owner / Applicant PINK COPY (Initial) Owner / Applicant