Paid 325.00 DT (10:30)

IREDELL COUNTY HEALTH DEPARTMENT

STATESVILLE 704-878-5305 MOORESVILLE 704-664-5281

IMPROVEMENT PERMIT / AUTHORIZATION TO CONSTRUCT / OPERATION PERMIT / EXISTING SYSTEM INSPECTION

PERMIT# 091244 PIN# 4636210429 DATE 8/28/00

OWNER OR CONTRACTOR Jeff Kieffer PHONE: Business (704)663-1953 Home

ADDRESS 191 Cove Crk Rd Mooresville NC 28117

LOCATION Brawley sch. L Isle of Pines, R Cove Crk, 1.2 Rt

SUBDIVISION Northshore BLOCK / SECTION 3 LOT 72 LOT AREA 1.04 SITE CLASS PS DESIGN FLOW 480 L.T.A.R. 0.3

Septic Tank: 1000 Gallons; STB 794 Date 10-30-00

Pump Tank: 1000 Gallons; PT 833 Date 1-20-01

Pump Make: Goulds Model WE10J2H Serial No. 502506790

Nitrification Field: No Fields 1 Square Feet 800 Linear Feet 267

No Lines 4C67 Trench Width 36" Max Trench Bottom Depth 36" Gravel Depth —

☒ New System ☐ Repair System Type: I, II, III, (IV), V, VI

System Description: LPPPBS

Repair System Description: LPP

Maintenance Agreement Required: ☒ Yes ☐ No

☒ House/Mod. Home No. Bedrooms 4

☐ Mobile Home No. Bathrooms 3

☐ Business No. Employees

☐ Other


☐ Slab ☐ Crawl Space ☒ Basement w/plumbing ☐ Basement wo/plumbing

Water Supply: ☐ Individual ☐ Public ☒ Community


Comments:/Conditions:

Comments:/Conditions:

INITIAL SITE SKETCH

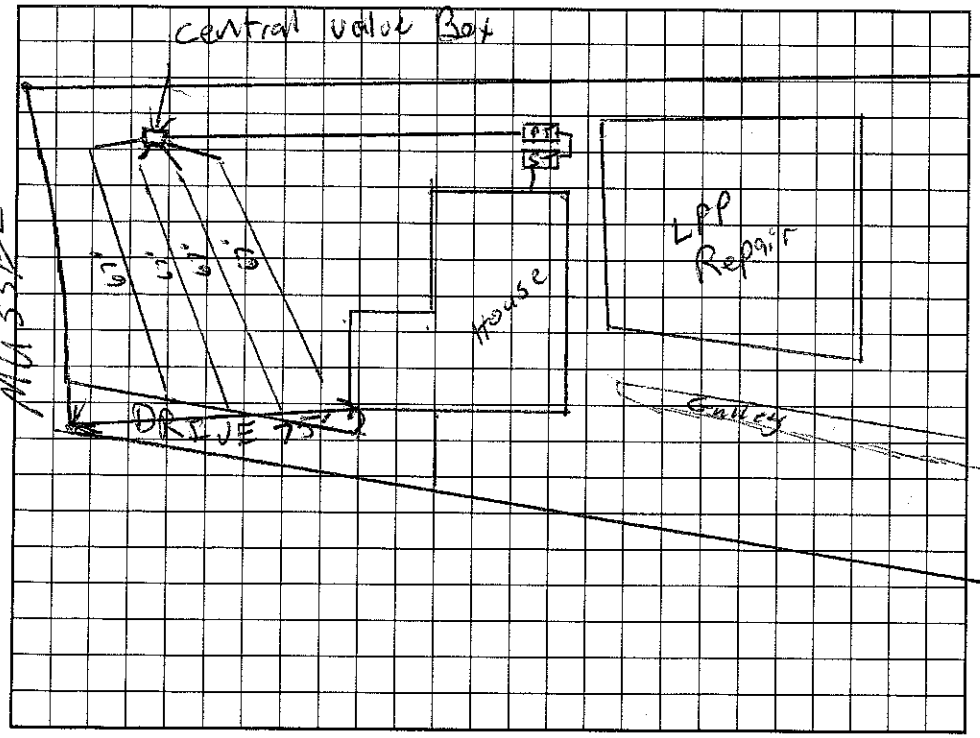

AS BUILT SKETCH

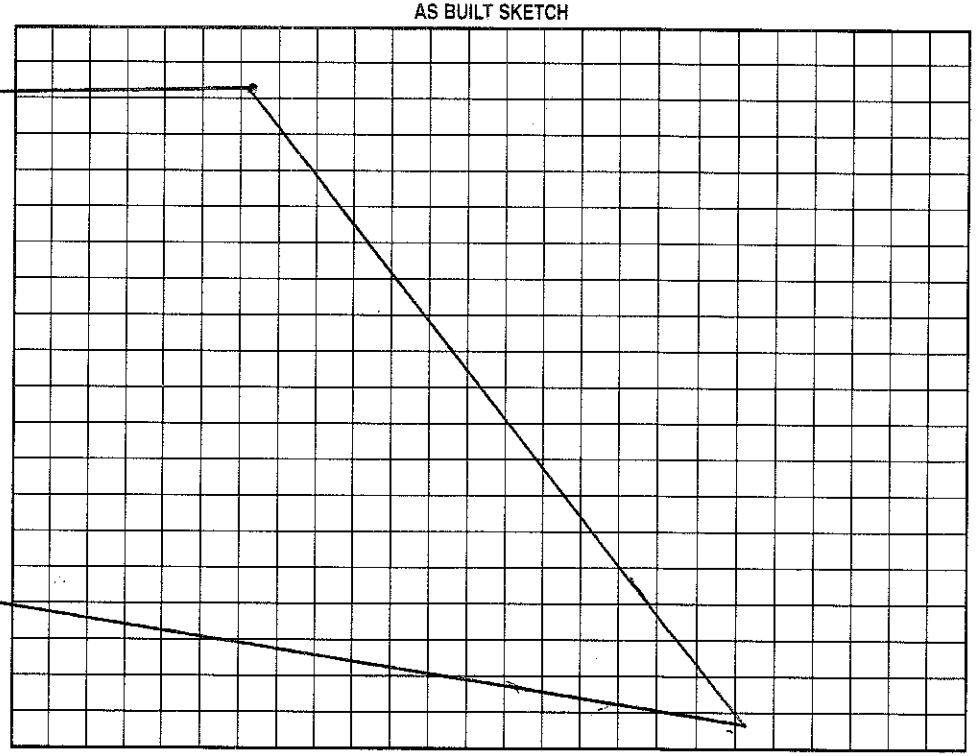

Permit can be suspended or revoked if any false information is supplied toward securing the permit/any unauthorized changes are made to the site/any unauthorized changes are made in the installation of the system. Improvement Permit with plat valid without expiration. Improvement Permit with site plan valid for sixty months. Authorization to Construct is valid for a period equal to that of Improvement Permit – not to exceed sixty months.

Signed: date 8/29/00 Installed by: Reed Eddy

Improvement Permit by: RSI date 8/28/00 Operation Permit by: RSI date 3/19/01

Authorization to Construct by: RSI date 8/28/00 Existing System Inspection by: date

HEALTH DEPT. COPY: WHITE OWNER COPY (FINAL): YELLOW OWNER COPY (INITIAL): PINK