IREDELL COUNTY HEALTH DEPARTMENT

STATESVILLE 704-878-5305 MOORESVILLE 704-664-5281

IMPROVEMENT PERMIT / CERTIFICATE OF COMPLETION / OPERATION PERMIT / EXISTING SYSTEM INSPECTION

PROPERTY DESCRIPTION NO. 18703 DATE 2/24/97 TAX MAP NO. 2FB10 pt of 4636211602 Watershed: ☐ Yes ☐ No

OWNER OR CONTRACTOR HOWARD CULBRETH PHONE: Business 892-6260 Home

ADDRESS 18738 HWY 73 CORNELIUS NC 28031

LOCATION BRAWLEY SCHOOL RD - TL ISLE OF PINES TR MUSSEL CT - 4TH LOT ON RT

SUBDIVISION NORTH SHORE BLOCK / SECTION F LOT 71 LOT AREA 60,251 FT² SITE CLASS. PS DESIGN FLOW 480 GPD L.T.A.R. .3 GPD/FT²

Septic Tank: 1000 Gallons; STB 794 Date 8/5/97

Pump Tank: 1000 Gallons; PT SK 27 Date 7/14/97

Pump Make: HYDROMATIC Model SK50GM1 Serial No. 9-97

Nitrification Field: No Fields 1 Square Feet 1200 Linear Feet 400

No Lines ~~5 @ 80'~~ 4 @ 100' Trench Width 36" Max Trench Bottom Depth 24" Gravel Depth N/A

☑ New System ☐ Repair System Type: I, II, (III), IV, V, VI

System Description: PUMP CHAMBERED OR SIMILAR

Repair System Description: PUMP PANEL

Maintenance Agreement Required: ☐ Yes ☑ No

☑ House/Mod. Home No. Bedrooms 4

☐ Mobile Home No. Bathrooms 4

☐ Business No. Employees

☐ Other


☐ Slab ☑ Crawl Space ☐ Basement w/plumbing ☐ Basement wo/plumbing

Water Supply: ☐ Individual ☑ Community ☐ Public


Comments: 4@100'

Comments:

INITIAL SITE SKETCH

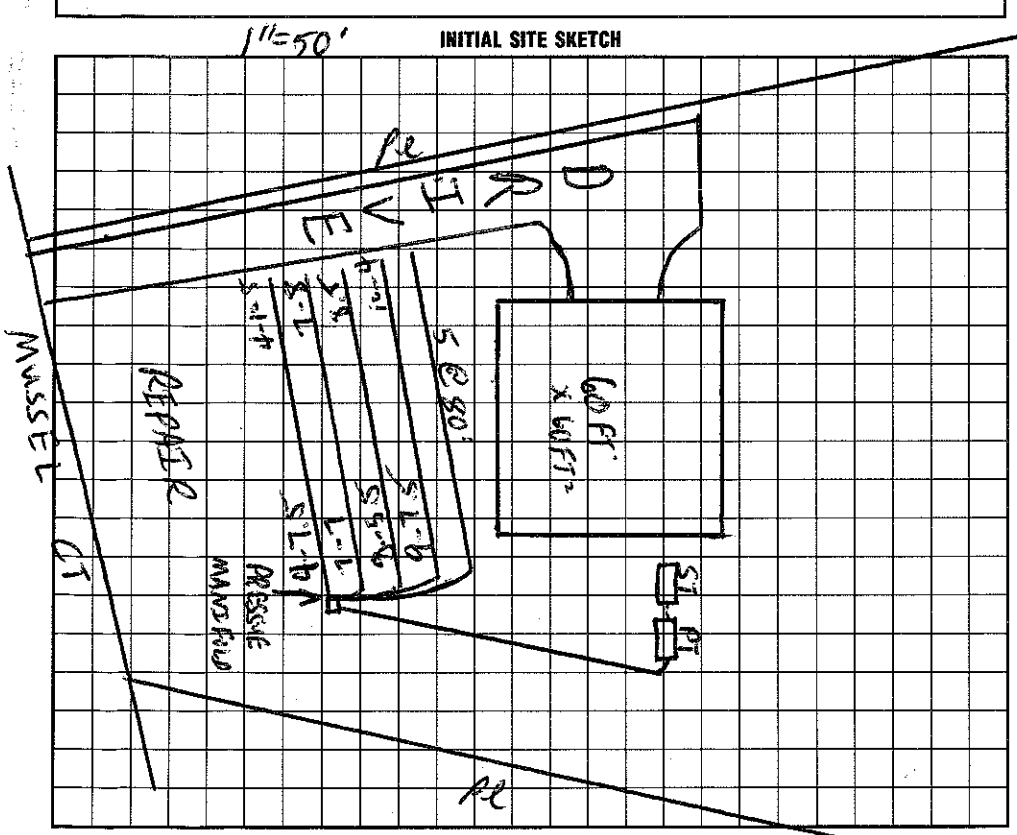

AS BUILT SKETCH

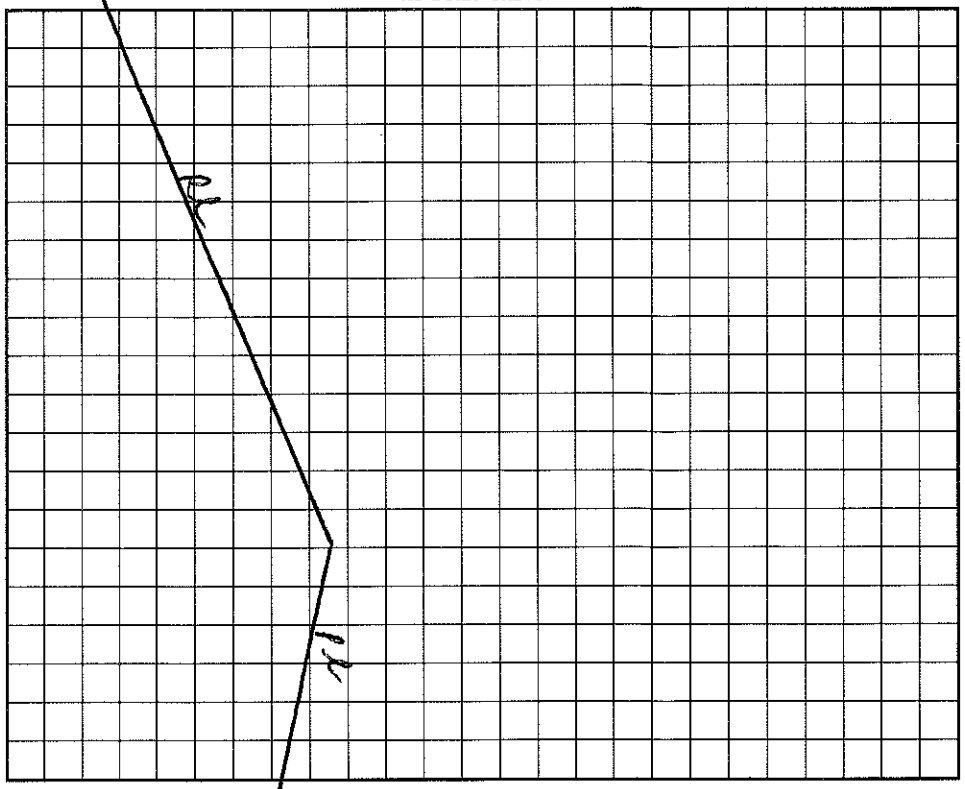

I understand that this permit can be suspended or revoked if any false information is supplied toward securing the permit/any unauthorized changes are made to the site/any unauthorized changes are made in the installation of the system. Improvement Permit is valid for 60 months from date of issuance.

Signed: Howard Culbreth Installed by: Lavon Burton

Improvement Permit by: C. Ray Freeman EHSS date 2/24/97 Certificate of Completion by: date

Existing System Inspection by: C. Ray Freeman EHSS date 2/24/97 Operation Permit by: C. Ray Freeman date 10/21/97

HEALTH DEPT. COPY: WHITE INSPECTION COPY (FINAL): GREEN OWNER COPY (FINAL): YELLOW INSPECTION COPY (INITIAL): PINK OWNER COPY (INITIAL): GOLD