IREDELL COUNTY HEALTH DEPARTMENT

STATESVILLE 704-878-5305 146 MOORESVILLE 704-664-5281

IMPROVEMENT PERMIT / AUTHORIZATION TO CONSTRUCT / OPERATION PERMIT / EXISTING SYSTEM INSPECTION

PERMIT# 108660 PIN# 4636216368.10 4636-21-2236 DATE 12/13/02

OWNER OR CONTRACTOR EASTER DEVELOPMENT/Carolina Bldr Assn PHONE: Business 664-2906 Home

ADDRESS 227 HIDEAWAY LN MOORESVILLE NC 28117

LOCATION BRAWLEY SCHOOL - TL ISLE OF PINES - TR ENGLISH ~~RD~~ IVY - AT END IN CUL-DE-SAC

SUBDIVISION STONEGATE BLOCK / SECTION LOT 10 LOT AREA .69AC SITE CLASS PS DESIGN FLOW 360GPD L.T.A.R. .25 gpd/ft²

Septic Tank: 1000 Gallons; STB 1012 Date 7/31/05
Pump Tank: 1000 Gallons; PT PT 17 Date 1/29/06
Pump Make: Goulds Model WE6E10 Serial No. 1106
Nitrification Field: No Fields 1 Square Feet 480 Linear Feet 240
No Lines 3@80' Trench Width 24" Max Trench Bottom Depth (30") Gravel Depth N/A

☑ New System ☐ Repair System Type: I. II. III. IV. V. VI
System Description: LP PANEL OFFSITE
Repair System Description: SAME
Maintenance Agreement Required: ☑ Yes ☐ No


☑ House/Mod. Home No. Bedrooms 3
☐ Mobile Home No. Bathrooms 2
☐ Business No. Employees
☐ Other
☐ Slab ☐ Crawl Space ☑ Basement w/plumbing ☐ Basement wo/plumbing

Water Supply: ☑ Individual ☐ Public ☐ Community


Comments:/Conditions: 1) 3 BEDROOM ONLY OR LESS

Comments:/Conditions:

INITIAL SITE SKETCH 1"=50'

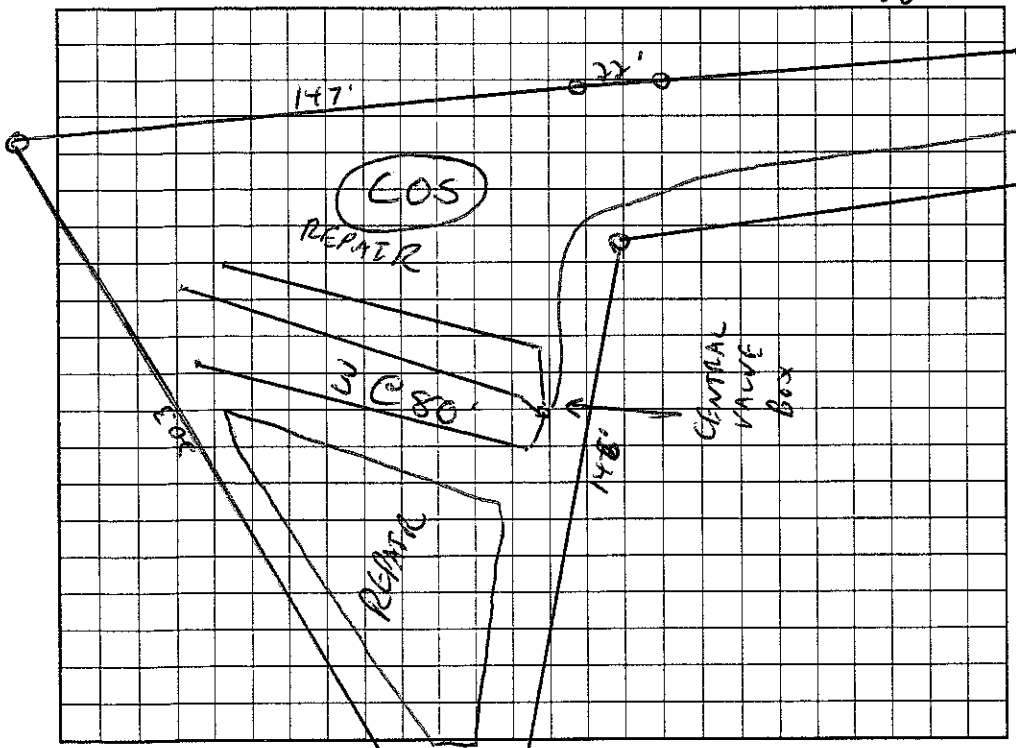

AS BUILT SKETCH

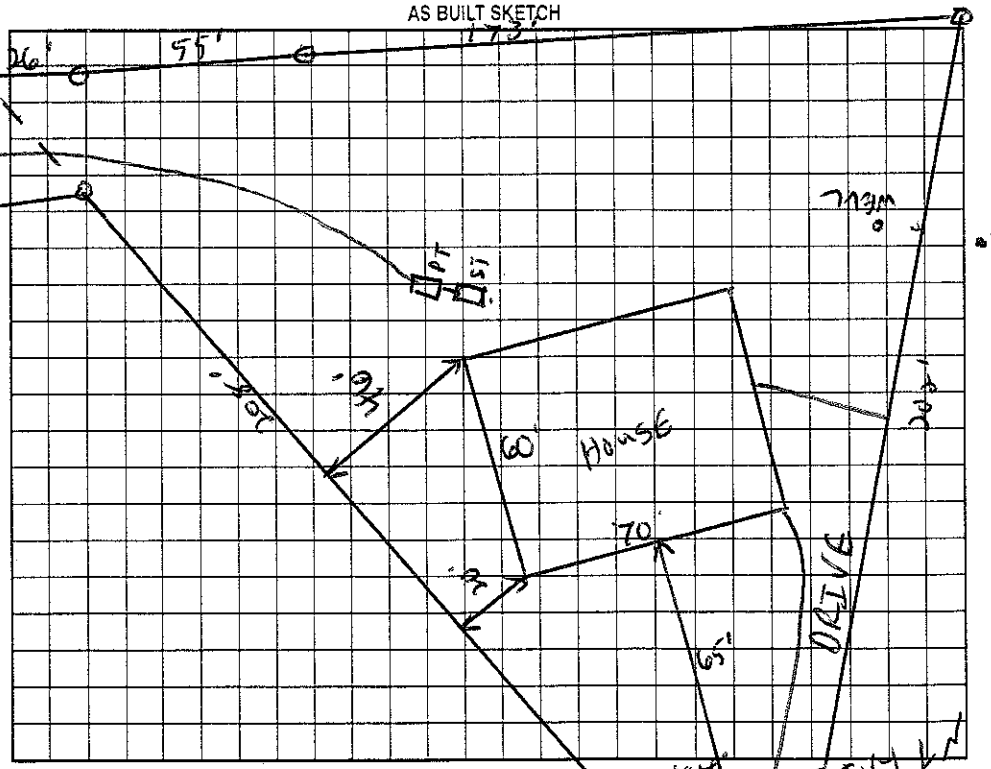

Permit can be suspended or revoked if any false information is supplied toward securing the permit/any unauthorized changes are made to the site/any unauthorized changes are made in the installation of the system. Improvement Permit with plat valid without expiration. Improvement Permit with site plan valid for sixty months. Authorization to Construct is valid for a period equal to that of Improvement Permit – not to exceed sixty months.

Signed: [signature] date 12/30/02 Installed by: C+S

Improvement Permit by: [signature] RS date 12/13/02 Operation Permit by: [signature] RS date 5/19/06

Authorization to Construct by: [signature] RS date 2/18/05 Existing System Inspection by: date

HEALTH DEPT. COPY: WHITE OWNER COPY (FINAL): YELLOW OWNER COPY (INITIAL): PINK