IREDELL COUNTY HEALTH DEPARTMENT

STATESVILLE 704-878-5305 130.00 Paid MOORESVILLE 704-664-5281

IMPROVEMENT PERMIT / AUTHORIZATION TO CONSTRUCT / OPERATION PERMIT / EXISTING SYSTEM INSPECTION

PERMIT# 108665 PIN# ~~4636216368.000~~ 4636218184 DATE 11/22/02

OWNER OR CONTRACTOR EASTER DEVELOPMENT / Tom Lawley PHONE: Business 664-2906 Home

ADDRESS 227 HIDEAWAY LN MOORESVILLE NC 28117

LOCATION BRAWLEY SCHOOL - TL ISLES OF PINES - TR ENGLISH IVY - 6th ON LT

SUBDIVISION STONEGATE BLOCK / SECTION LOT 12 LOT AREA .93 AC SITE CLASS. RS DESIGN FLOW 480GPD L.T.A.R. .30 RD/KD

Septic Tank: 1000 Gallons; STB 1012 Date 2/15/04

Pump Tank: Gallons; PT Date

Pump Make: Model Serial No.

Nitrification Field: No Fields 1 Square Feet 1206 Linear Feet 402

No Lines 3@134' Trench Width 36" Max Trench Bottom Depth 36" Gravel Depth N/A

☐ New System ☐ Repair System Type: I, II, (III), IV, V, VI

System Description: GRAVITY INNOVATIVE

Repair System Description: ~~Same~~ SAME/PANEL

Maintenance Agreement Required: ☐ Yes ☒ No

☒ House/Mod. Home No. Bedrooms 4

☐ Mobile Home No. Bathrooms 4

☐ Business No. Employees

☐ Other


☐ Slab ☒ Crawl Space ☐ Basement w/plumbing ☐ Basement wo/plumbing

Water Supply: ☒ Individual ☐ Public ☐ Community


Comments:/Conditions:

Comments:/Conditions: EZ FLOW INSTALLED.

INITIAL SITE SKETCH 1"=50'

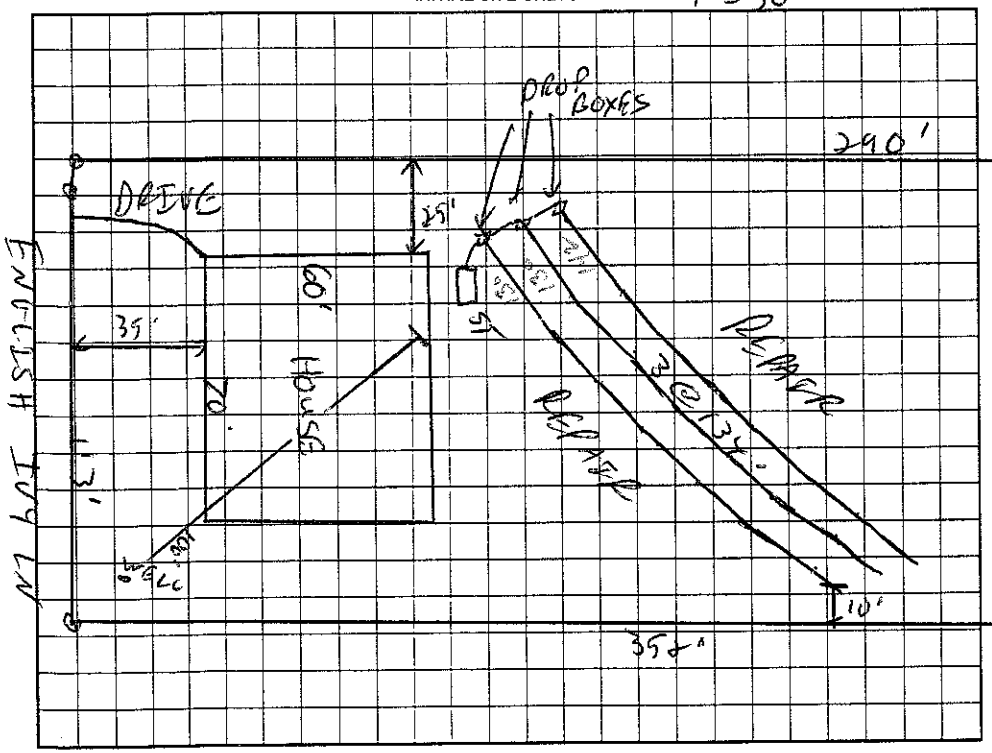

AS BUILT SKETCH

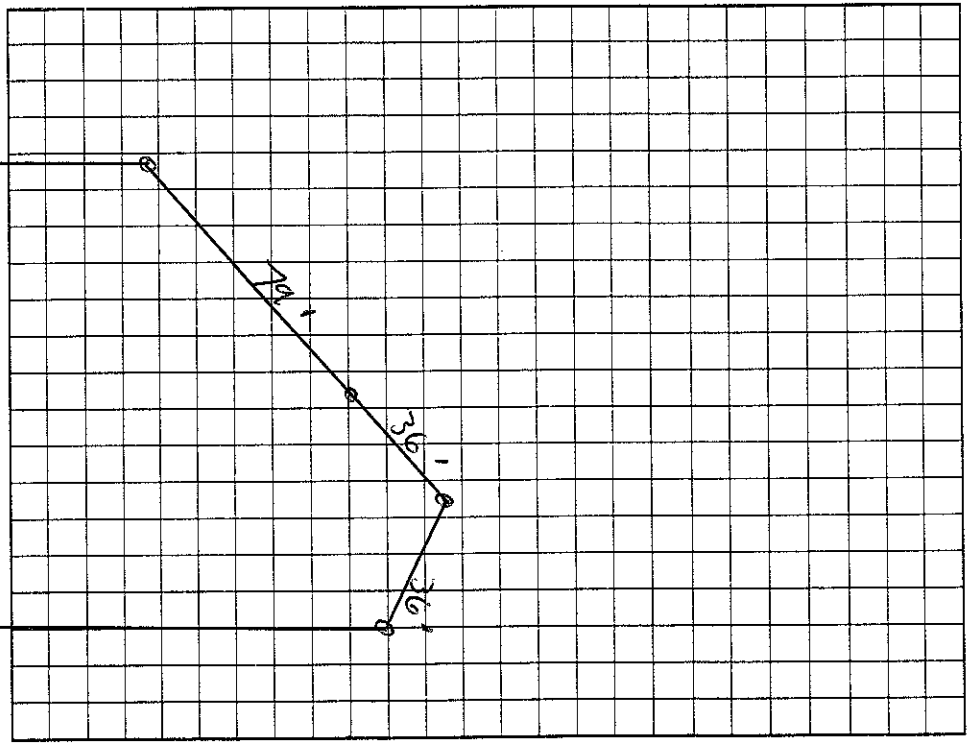

Permit can be suspended or revoked if any false information is supplied toward securing the permit/any unauthorized changes are made to the site/any unauthorized changes are made in the installation of the system. Improvement Permit with plat valid without expiration. Improvement Permit with site plan valid for sixty months. Authorization to Construct is valid for a period equal to that of Improvement Permit – not to exceed sixty months.

Signed: date 12-11-02 Installed by: C & S Grading & Landscaping

Improvement Permit by: RS date 11/22/02 Operation Permit by: Wesley Shackleford S. date 6/23/04

Authorization to Construct by: RS date 12/9/03 Existing System Inspection by: date

HEALTH DEPT. COPY: WHITE OWNER COPY (FINAL): YELLOW OWNER COPY (INITIAL): PINK