IREDELL COUNTY HEALTH DEPARTMENT

144 STATE 704-878-5305 MOORESVILLE 704-664-5281

IMPROVEMENT PERMIT / AUTHORIZATION TO CONSTRUCT ERATION PERMIT / EXISTING SYSTEM INSPECTION

PERMIT# 108662 PIN# 4636216368.TT 4636-21-3309 DATE 8-22-05

OWNER OR CONTRACTOR Carolina Builders & Assoc. PHONE: Business 704-622-6164 Home 704-543-0699

ADDRESS 9513 Wilson Hall Dr. Charlotte NC 28277

LOCATION Brawley school Rd. W, TL Isle of Pines, TR English Ivey Ln. 7th on rt

SUBDIVISION stonegate BLOCK / SECTION ____ LOT 11 LOT AREA .69 ac SITE CLASS. PS DESIGN FLOW 360gpd L.T.A.R. .25-.3 gpd/ft²

Septic Tank: 1000 ✓ Gallons: STB 1012 Date ____

Pump Tank: 1000 Gallons: PT 1? Date 5/29/06

Pump Make: Geo-Flo Model 511-N Serial No. ____

Nitrification Field: No Fields 1 Square Feet 420 Linear Feet 210

No Lines 3@70' Trench Width 24" Max Trench Bottom Depth 36" Gravel Depth NA

☒ New System ☐ Repair System Type: I, II, III, (IV) V, VI

System Description: LP Panel

Repair System Description: same

Maintenance Agreement Required: ☒ Yes ☐ No

☒ House/Mod. Home No. Bedrooms 3

☐ Mobile Home No. Bathrooms 3

☐ Business No. Employees ____

☐ Other ____

☐ Slab ☒ Crawl Space ☐ Basement w/plumbing ☐ Basement wo/plumbing

Water Supply: ☒ Individual ☐ Public ☐ Community


Comments:/Conditions:

1) Initial system rated at .3 gpd/ft.²
2) Repair rated at .25 gpd/ft²
3) No foundation drain front of house


Comments:/Conditions: 8/21/06 - Vd lower & middle Line

1"=50'

INITIAL SITE SKETCH

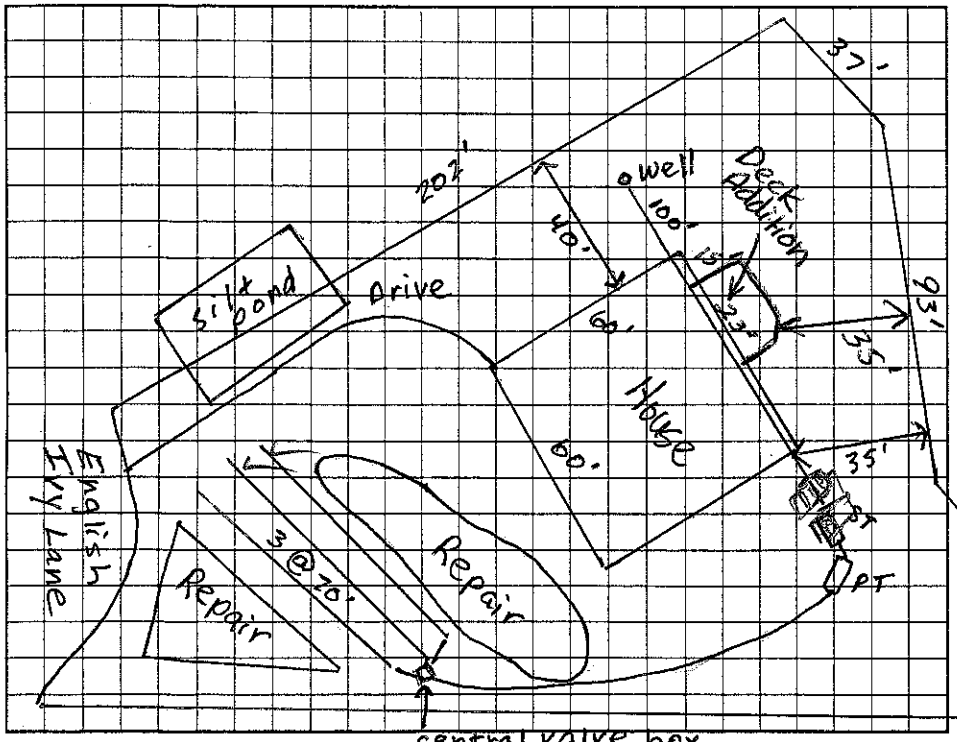

AS BUILT SKETCH

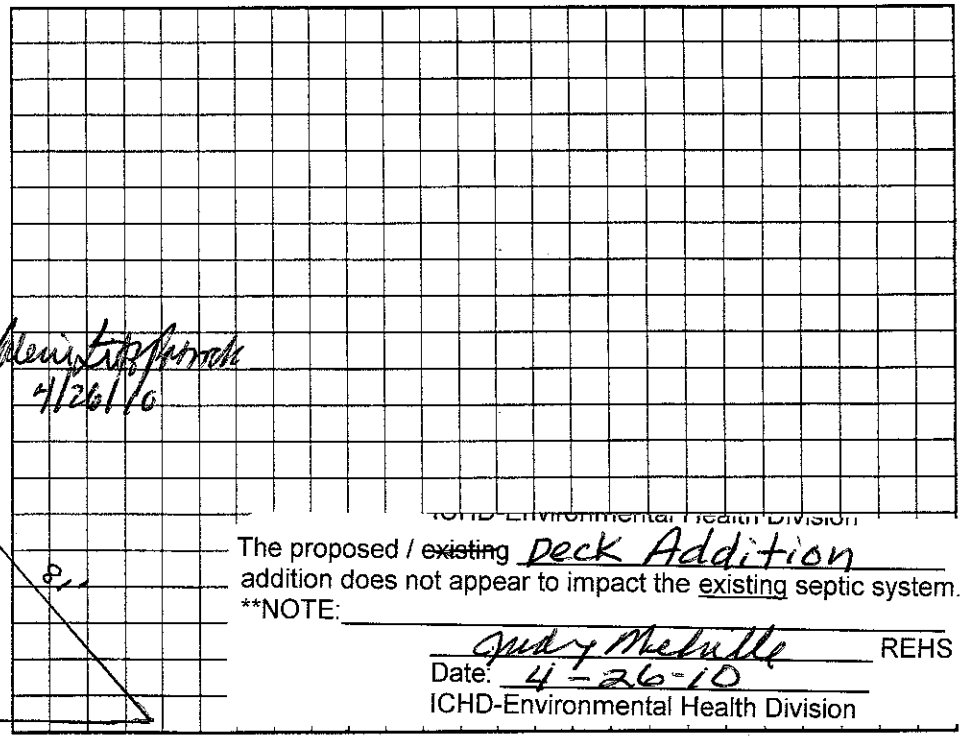

Memo to file 4/26/10

ICHD-Environmental Health Division

The proposed / ~~existing~~ Deck Addition addition does not appear to impact the existing septic system.

**NOTE: ____

Judy Melville REHS

Date: 4-26-10

ICHD-Environmental Health Division

Permit can be suspended or revoked if any false information is supplied toward securing the permit/any unauthorized changes are made to the site/any unauthorized changes are made in the installation of the system. Improvement Permit with plat valid without expiration. Improvement Permit with site plan valid for sixty months. Authorization to Construct is valid for a period equal to that of Improvement Permit – not to exceed sixty months.

Signed: [signature] date 8-29-05 Installed by: C+S

Improvement Permit by: Judy Melville date 8-22-05 Operation Permit by: Judy Melville date 9-1-06

Authorization to Construct by: Judy Melville date 8-22-05 Existing System Inspection by: ____ date ____

HEALTH DEPT. COPY: WHITE OWNER COPY (FINAL): YELLOW OWNER COPY (INITIAL): PINK