IREDELL COUNTY HEALTH DEPARTMENT

STATESVILLE 704-878-5305 130.00 Paid MOORESVILLE 704-664-5281

IMPROVEMENT PERMIT / AUTHORIZATION TO CONSTRUCT / OPERATION PERMIT / EXISTING SYSTEM INSPECTIO

PERMIT# 108666 PIN# ~~4636 21 6368.13~~ 4636214574 DATE 11/22/02

OWNER OR CONTRACTOR EASTER DEVELOPMENT/Lewis Carpenter PHONE: Business 664-2406 Home

ADDRESS 227 HIDEAWAY LN MOORESVILLE, NC 28117

LOCATION BRAWLEY SCHOOL - TL ISLE OF PINES - TR ENGLISH IVY LN - 5th ON RT

SUBDIVISION STONEGATE BLOCK / SECTION LOT 13 LOT AREA .89AC SITE CLASS PS DESIGN FLOW 480GPD L.T.A.R. .36-PD/ET

Septic Tank: 1000 Gallons; STB 312 Date 4/12/05
Pump Tank: Gallons; PT Date
Pump Make: Model Serial No.
Nitrification Field: No Fields 1 Square Feet 1200 Linear Feet 400
No Lines 4@100' Trench Width 36" Max Trench Bottom Depth 36" Gravel Depth N/A

☑ New System ☐ Repair System Type: I, II, III, IV, V, VI
System Description: GRAVITY INNOVATIVE
Repair System Description: SAME
Maintenance Agreement Required: ☐ Yes ☑ No


☑ House/Mod. Home No. Bedrooms 4
☐ Mobile Home No. Bathrooms 4
☐ Business No. Employees
☐ Other
☐ Slab ☑ Crawl Space ☐ Basement w/plumbing ☐ Basement wo/plumbing

Water Supply: ☑ Individual ☐ Public ☐ Community


Comments:/Conditions:

Comments:/Conditions:

INITIAL SITE SKETCH 1"=50'

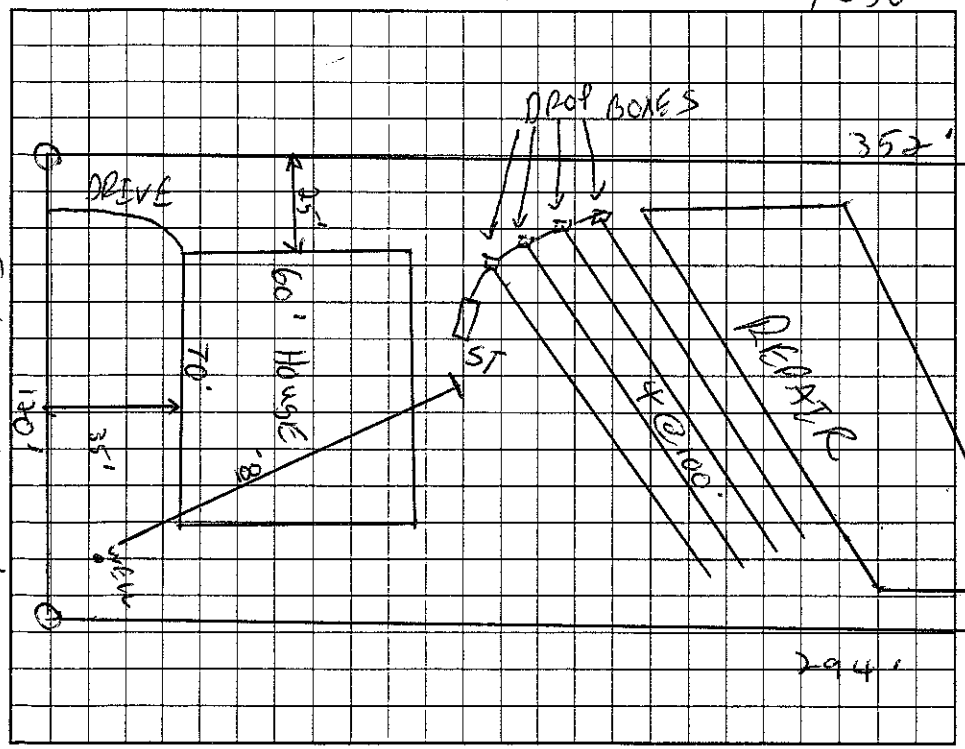

AS BUILT SKETCH

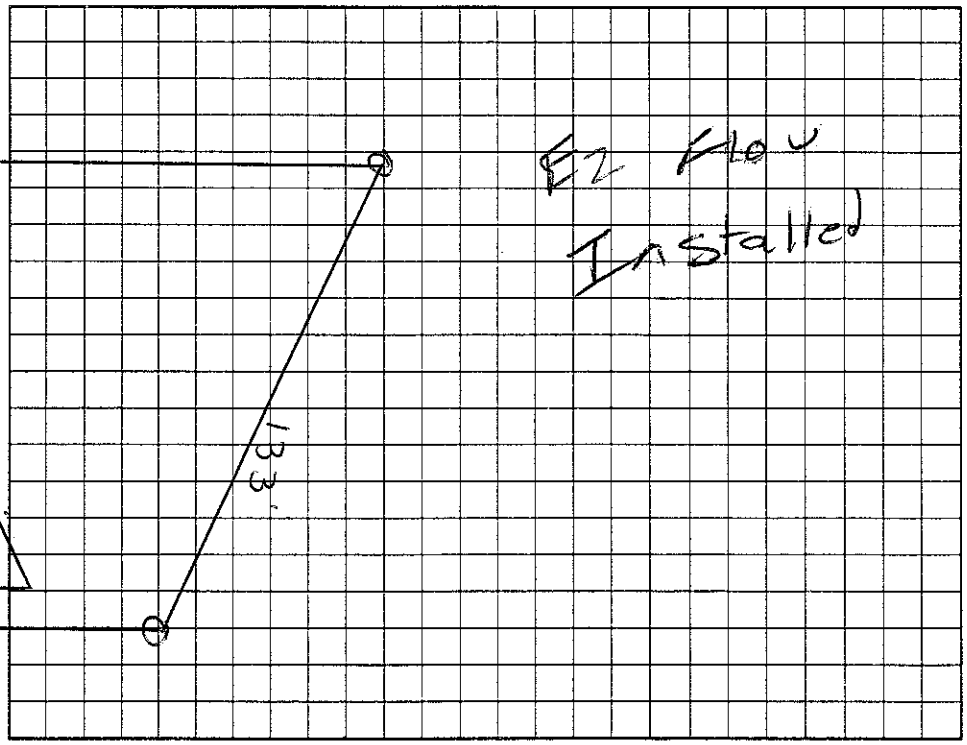

Permit can be suspended or revoked if any false information is supplied toward securing the permit/any unauthorized changes are made to the site/any unauthorized changes are made in the installation of the system. Improvement Permit with plat valid without expiration. Improvement Permit with site plan valid for sixty months. Authorization to Construct is valid for a period equal to that of Improvement Permit – not to exceed sixty months.

Signed: date 12-11-02 Installed by: Larry Beam

Improvement Permit by: RS date 11/22/02 Operation Permit by: RS date 5/12/05

Authorization to Construct by: RS date 12/16/04 Existing System Inspection by: date

HEALTH DEPT. COPY: WHITE OWNER COPY (FINAL): YELLOW OWNER COPY (INITIAL): PINK