IREDELL COUNTY HEALTH DEPARTMENT

STATESVILLE 704-878-5305 130.00 Paid MOORESVILLE 704-664-5281

IMPROVEMENT PERMIT / AUTHORIZATION TO CONSTRUCT / OPERATION PERMIT / EXISTING SYSTEM INSPECTION

PERMIT# 108667 PIN# ~~4636216308.79~~ 4636215599 DATE 11/22/02

OWNER OR CONTRACTOR EASTER DEVELOPMENT / LEWIS CARPENTER PHONE: Business 664-2906 Home

ADDRESS 227 HIDEAWAY LN MOORESVILLE NC 28117

LOCATION BRAWLEY SCHOOL - TL ISLE OF PINES - TR ENGLISH IVY LN - 4TH ON RT

SUBDIVISION STONEGATE BLOCK / SECTION LOT 14 LOT AREA 1.73AC SITE CLASS. PS DESIGN FLOW 450GPD L.T.A.R. 1,350 SQ FT

Septic Tank: 1000 Gallons; STB 794 Date 1/24/04
Pump Tank: Gallons; PT Date
Pump Make: Model Serial No.
Nitrification Field: No Fields 1 Square Feet 1200 Linear Feet 400
No Lines 4@100' Trench Width 36" Max Trench Bottom Depth 36"

☑ New System ☐ Repair System Type: I, II, III, IV, V, VI
System Description: GRAVITY INNOVATIVE
Repair System Description: SAME
Maintenance Agreement Required: ☐ Yes ☑ No
Gravel Depth N/A


☑ House/Mod. Home No. Bedrooms 4
☐ Mobile Home No. Bathrooms 4
☐ Business No. Employees
☐ Other
☐ Slab ☑ Crawl Space ☐ Basement w/plumbing ☐ Basement wo/plumbing

Water Supply: ☑ Individual ☐ Public ☐ Community


Comments:/Conditions: MAY SET TANK ON OTHER SIDE OF LOT. IF 100' FROM WELL

Comments:/Conditions:

INITIAL SITE SKETCH 1"=50'

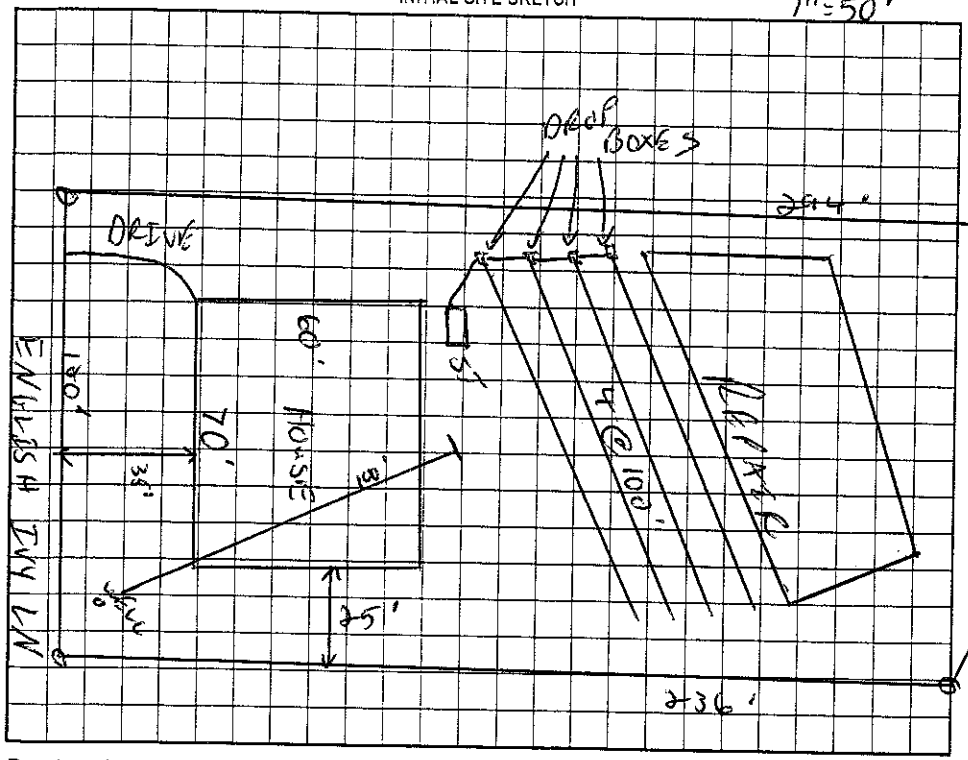

AS BUILT SKETCH

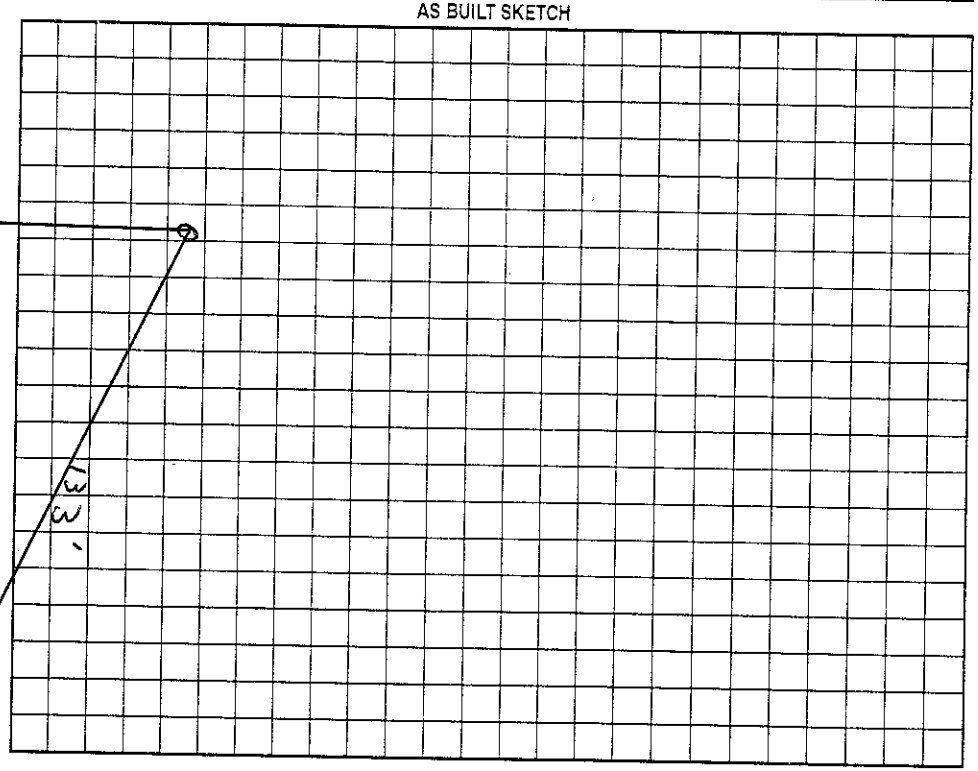

Permit can be suspended or revoked if any false information is supplied toward securing the permit/any unauthorized changes are made to the site/any unauthorized changes are made in the installation of the system. Improvement Permit with plat valid without expiration. Improvement Permit with site plan valid for sixty months. Authorization to Construct is valid for a period equal to that of Improvement Permit – not to exceed sixty months.

Signed: date 12-11-02 Installed by: Larry Beam

Improvement Permit by: RS date 11/22/02 Operation Permit by: RS date 3/17/04

Authorization to Construct by: RS date 5/28/03 Existing System Inspection by: date

HEALTH DEPT. COPY: WHITE OWNER COPY (FINAL): YELLOW OWNER COPY (INITIAL): PINK