IREDELL COUNTY HEALTH DEPARTMENT

Authorization to Construct

STATESVILLE 704-878-5305 MOORESVILLE 704-664-5281

IMPROVEMENT PERMIT / ~~CERTIFICATE OF COMPLETION~~ / OPERATION PERMIT / EXISTING SYSTEM INSPECTION

PROPERTY DESCRIPTION NO. 24237 DATE 7/15/96 TAX MAP NO. 2G 23 A 83 Watershed: [X] Yes [ ] No

OWNER OR CONTRACTOR Robert Thurston Homes PHONE: Business 391-3715 Home

ADDRESS 2900 I 85 Service Road Charlotte NC 28208 ~~463-10-7804~~ 4636 21 7031

LOCATION Brawley Sch Tl Side of Pines TR Cove Creek TR High Sail Ct. end of cul de sac

SUBDIVISION North Shore BLOCK / SECTION I LOT 2 LOT AREA 1.66Ac. SITE CLASS. 1 PS. DESIGN FLOW 480 L.T.A.R. .3

Septic Tank: 1000 Gallons; STB 794 Date 10/7/96

Pump Tank: ____ Gallons; PT ____ Date ____

Pump Make: ____ Model ____ Serial No. ____

Nitrification Field: No Fields 1 Square Feet 1600 Linear Feet 400 *

No Lines 4 Trench Width 36" Max Trench Bottom Depth 36" Gravel Depth SAND

[X] New System [ ] Repair System Type: I, II, (III), IV, V, VI

System Description: * CH. PLASTIC

Repair System Description: 16" PANEL BLOCK

Maintenance Agreement Required: [ ] Yes [X] No

[X] House/Mod. Home No. Bedrooms 4

[ ] Mobile Home No. Bathrooms 2.5

[ ] Business No. Employees ____

[ ] Other ____


[ ] Slab [X] Crawl Space [ ] Basement w/plumbing [ ] Basement wo/plumbing

Water Supply: [ ] Individual [X] Community [ ] Public


Comments: * 25% reduction of square footage sand to top of louvers on each plenum section

Comments:

INITIAL SITE SKETCH

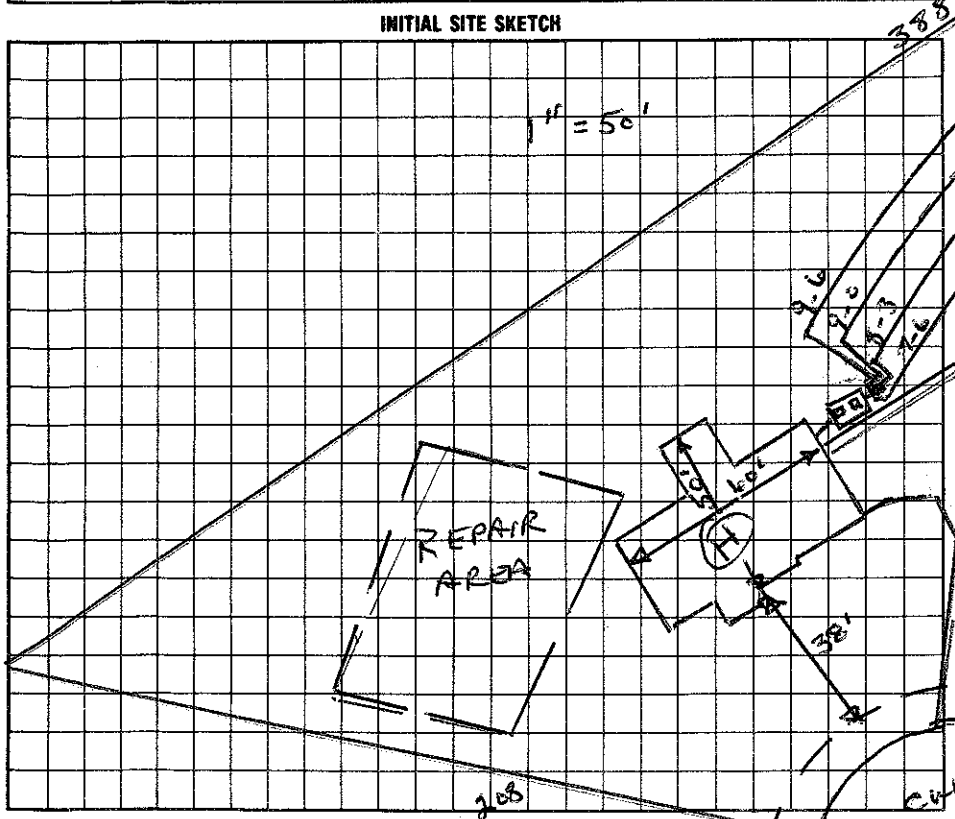

AS BUILT SKETCH

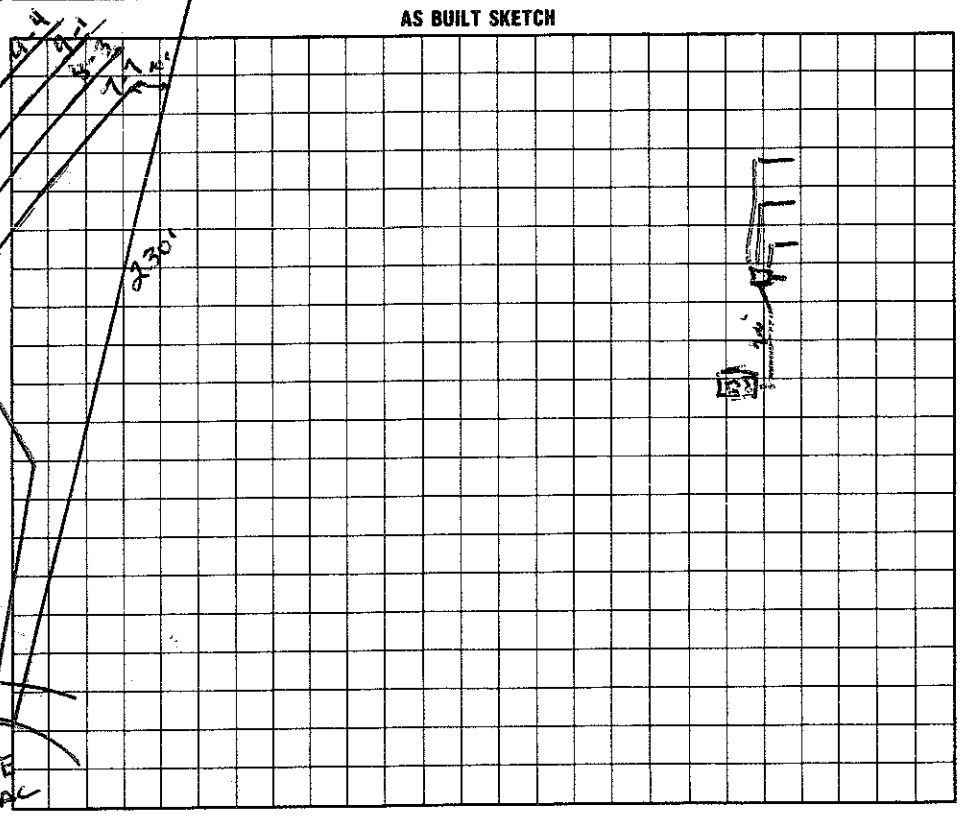

I understand that this permit can be suspended or revoked if any false information is supplied toward securing the permit/any unauthorized changes are made to the site/any unauthorized changes are made in the installation of the system.

Authorization to Construct valid 60 months.

Signed: *

Improvement Permit by: Wesley Sparks RS date 7/15/96

Existing System Inspection by: Wesley Sparks RS. date 7/15/96

Installed by: Thurston Grading

Certificate of Completion by: ____ date ____

Operation Permit by: Wesley Sparks RS date 11/18/96

HEALTH DEPT. COPY: WHITE INSPECTION COPY (FINAL): GREEN OWNER COPY (FINAL): YELLOW INSPECTION COPY (INITIAL): PINK OWNER COPY (INITIAL): GOLD