# IREDELL COUNTY HEALTH DEPARTMENT

STATESVILLE 704-878-5305 130.00 Paid MOORESVILLE 704-664-5281 4.00

## IMPROVEMENT PERMIT / AUTHORIZATION TO CONSTRUCT / OPERATION PERMIT / EXISTING SYSTEM INSPECTION

PERMIT# 108673 PIN# ~~4636216368.16~~ 4636218667 DATE 11/22/02

OWNER OR CONTRACTOR EASTER DEVELOPMENT / HERITAGE HOMES PHONE: Business 664-2406 Home

ADDRESS 227 HIDEAWAY LN MOORESVILLE, NC 28117

LOCATION BRAWLEY SCHOOLS - TL ISLE OF PINES - TR ENGLISH IVY LN - 2nd ON RT

SUBDIVISION STONEGATE BLOCK / SECTION LOT 16 LOT AREA .69AC SITE CLASS. PS DESIGN FLOW 480GPD L.T.A.R. .30-PO/F72

Septic Tank: 1000 Gallons; STB 350 Date 4/28/04
Pump Tank: Gallons; PT Date
Pump Make: Model Serial No.
Nitrification Field: No Fields 1 Square Feet 1206 Linear Feet 406
No Lines 3@134' Trench Width 36" Max Trench Bottom Depth 36" Gravel Depth N/A

☑ New System ☐ Repair System Type: I, II, III, IV, V, VI
System Description: GRAVITY INNOVATIVE
Repair System Description: SAME
Maintenance Agreement Required: ☐ Yes ☑ No


☑ House/Mod. Home No. Bedrooms 4
☐ Mobile Home No. Bathrooms 4
☐ Business No. Employees
☐ Other
☐ Slab ☑ Crawl Space ☐ Basement w/plumbing ☐ Basement wo/plumbing

Water Supply: ☑ Individual ☐ Public ☐ Community

Comments/Conditions:

Comments/Conditions:

1"=50' INITIAL SITE SKETCH

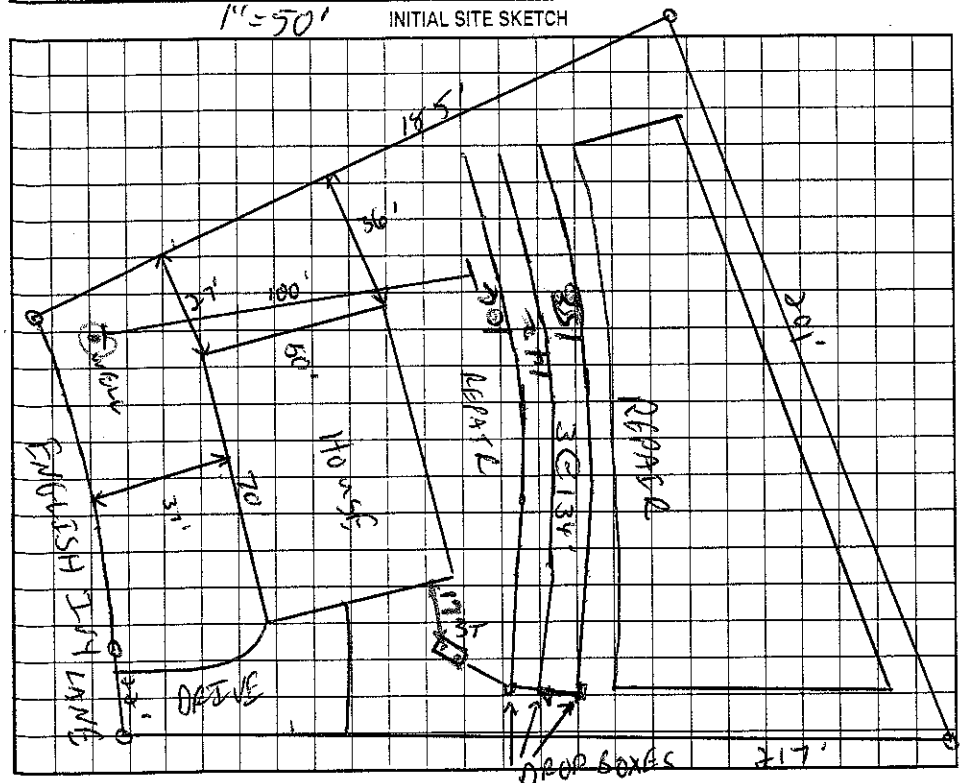


AS BUILT SKETCH

Permit can be suspended or revoked if any false information is supplied toward securing the permit/any unauthorized changes are made to the site/any unauthorized changes are made in the installation of the system. Improvement Permit with plat valid without expiration. Improvement Permit with site plan valid for sixty months. Authorization to Construct is valid for a period equal to that of Improvement Permit – not to exceed sixty months.

Signed: date 12-11-02 Installed by: Piedmont Septic Tank

Improvement Permit by: C. [illegible] RS date 11/22/02 Operation Permit by: Wesley Sparks R.S. date 6/11/04

Authorization to Construct by: Wesley Sparks R.S. date 11/10/03 Existing System Inspection by: date

HEALTH DEPT. COPY: WHITE OWNER COPY (FINAL): YELLOW OWNER COPY (INITIAL): PINK