IREDELL COUNTY HEALTH DEPARTMENT

STATESVILLE 704-878-5305 MOORESVILLE 704-664-5281

IMPROVEMENT PERMIT / AUTHORIZATION TO CONSTRUCT / OPERATION PERMIT / EXISTING SYSTEM INSPECTION

PERMIT# 084200 PIN# 4603602190065 DATE 12/6/2000

OWNER OR CONTRACTOR David Brodigan PHONE: Business _____ Home 663-4422

ADDRESS 123 Shore view Dr. Mooresville NC 28117

LOCATION Brawley School Rd TL Isle of Pines TR Cove Creek TR High Sail Ct. at end

SUBDIVISION North Shore I BLOCK / SECTION I *LOT 182 LOT AREA 1.18 Acre SITE CLASS. PS DESIGN FLOW 360 gpd L.T.A.R. .3

Septic Tank: 1000 Gallons; STB 794 Date 6-17-00

Pump Tank: _____ Gallons; PT _____ Date _____

Pump Make: _____ Model _____ Serial No. _____

Nitrification Field: No Fields 1 Square Feet 900' Linear Feet 300'

No Lines 4 at 75' Trench Width 36" Max Trench Bottom Depth 36" Gravel Depth N/A

☒ New System ☐ Repair System Type: I, II, III, IV, V, VI

System Description: Gravity - 25% Reduction

Repair System Description: Grav/Pump-Modified

Maintenance Agreement Required: ☑ Yes ☒ No

☐ House/Mod. Home No. Bedrooms 3

☐ Mobile Home No. Bathrooms 2.5

☐ Business No. Employees _____

☐ Other _____

☐ Slab ☒ Crawl Space ☐ Basement w/plumbing ☐ Basement wo/plumbing


Water Supply: ☐ Individual ☒ Public ☒ Community

Comments:/Conditions: * Lot 1 from latest plat


Comments:/Conditions: * Installed Plastic Chamber Drainfield. Zabel Filter installed

Scale 1:50

INITIAL SITE SKETCH

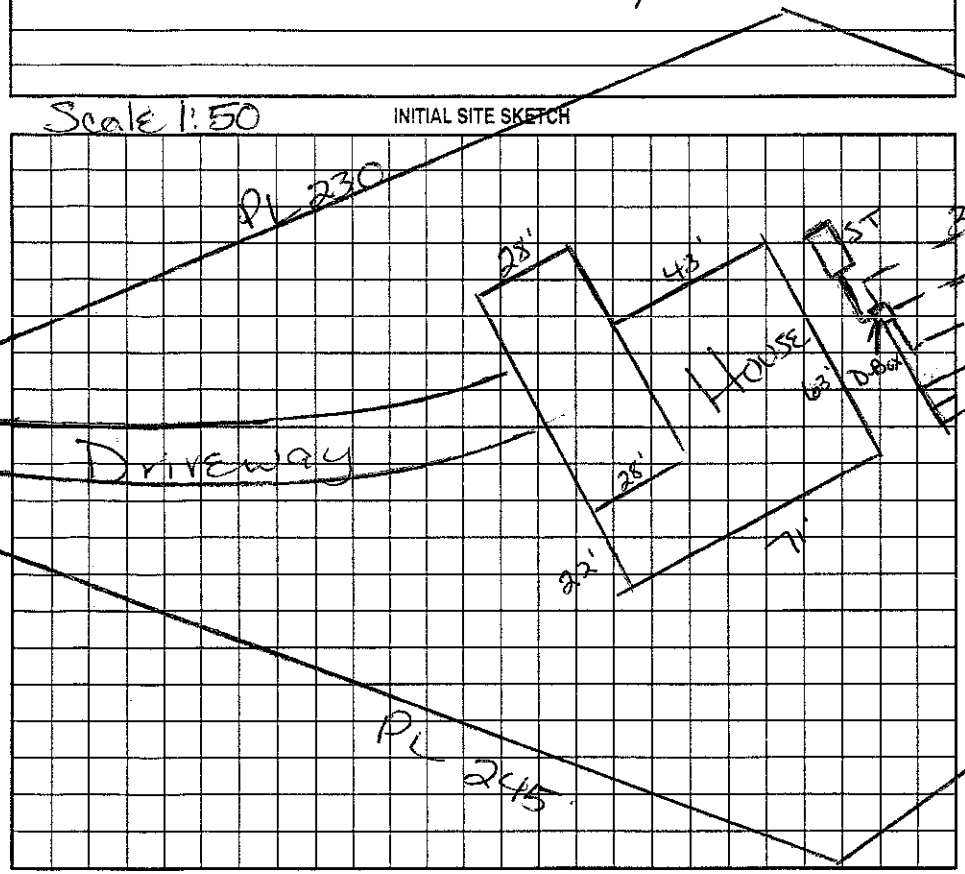

AS BUILT SKETCH

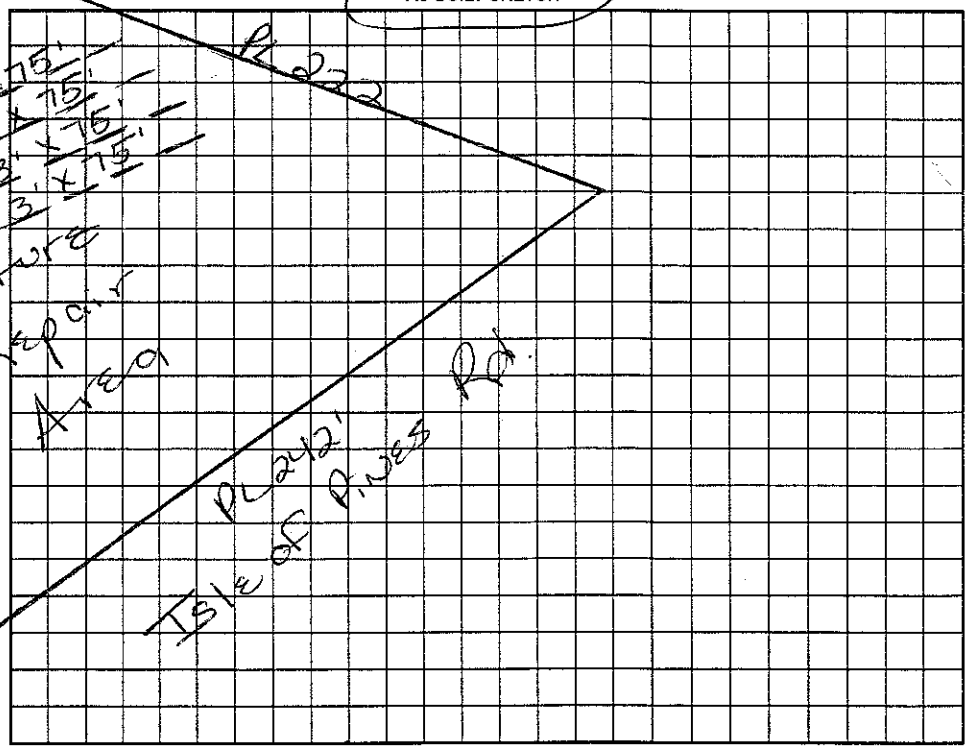

Permit can be suspended or revoked if any false information is supplied toward securing the permit/any unauthorized changes are made to the site/any unauthorized changes are made in the installation of the system. Improvement Permit with plat valid without expiration. Improvement Permit with site plan valid for sixty months. Authorization to Construct is valid for a period equal to that of Improvement Permit – not to exceed sixty months.

Signed: _____ date _____

Improvement Permit by: _____ date _____

Authorization to Construct by: _____ date _____

Installed by: Charles Beatty

Operation Permit by: Maina H. Dotson date 12/6/2000

Existing System Inspection by: _____ date _____

HEALTH DEPT. COPY: WHITE OWNER COPY (FINAL): YELLOW OWNER COPY (INITIAL): PINK

IREDELL COUNTY HEALTH DEPARTMENT

Paid 175.00

STATESVILLE 704-878-5305 MOORESVILLE 704-664-5281

3.30

IMPROVEMENT PERMIT / AUTHORIZATION TO CONSTRUCT / OPERATION PERMIT / EXISTING SYSTEM INSPECTION

PERMIT# 084200 PIN# 4636219065 DATE 11-20-2000

OWNER OR CONTRACTOR David Brodigan PHONE: Business Home 663-4422

ADDRESS 123 Shoreview Dr. Mooresville, NC 28117

LOCATION Brawley School Rd TL Isle of Pines TR Cove Creek TR High Sail at end of cul-de-sac

SUBDIVISION North Shore BLOCK / SECTION I LOT 82 LOT AREA 1.18 Acre SITE CLASS. PS DESIGN FLOW 3bdrm L.T.A.R. .3

Septic Tank: 1000 Gallons; STB 794 Date 6-17-00

Pump Tank: Gallons; PT Date

Pump Make: Model Serial No.

Nitrification Field: No Fields 1 Square Feet 900' Linear Feet 300'

No Lines 4 at 75' Trench Width 36" Max Trench Bottom Depth 36" Gravel Depth N/A

☒ New System ☐ Repair System Type: I, II, III, IV, V, VI

System Description: Gravity - 25% Reduction

Repair System Description: Grav/Pump - Modified

Maintenance Agreement Required: ☐ Yes ☒ No

☒ House/Mod. Home No. Bedrooms 3

☐ Mobile Home No. Bathrooms 2.5

☐ Business No. Employees

☐ Other

☐ Slab ☒ Crawl Space ☐ Basement w/plumbing ☐ Basement wo/plumbing


Water Supply: ☐ Individual ☒ Public ☐ Community

Comments:/Conditions: Keep Septic System 10' from PL, 5' from house Replaces previous permit.


Comments:/Conditions: ~~X~~ Remove old berms & terraces. Position ST for gravity flow to drainfield. Replaces previous permit Label Filter

Scale 1:50

INITIAL SITE SKETCH

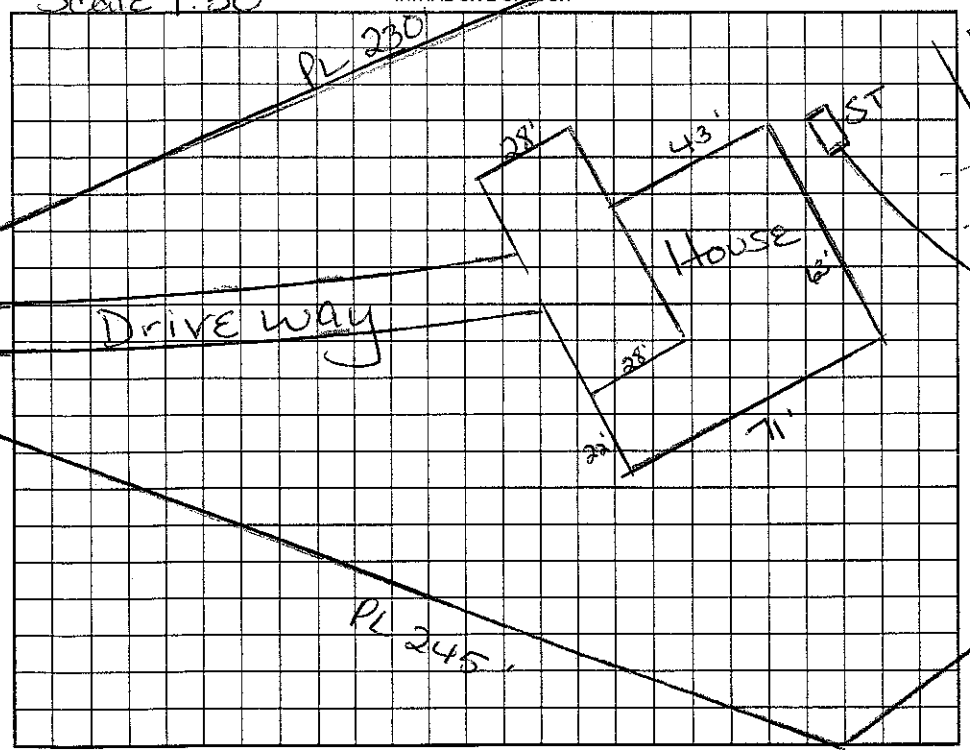

AS BUILT SKETCH

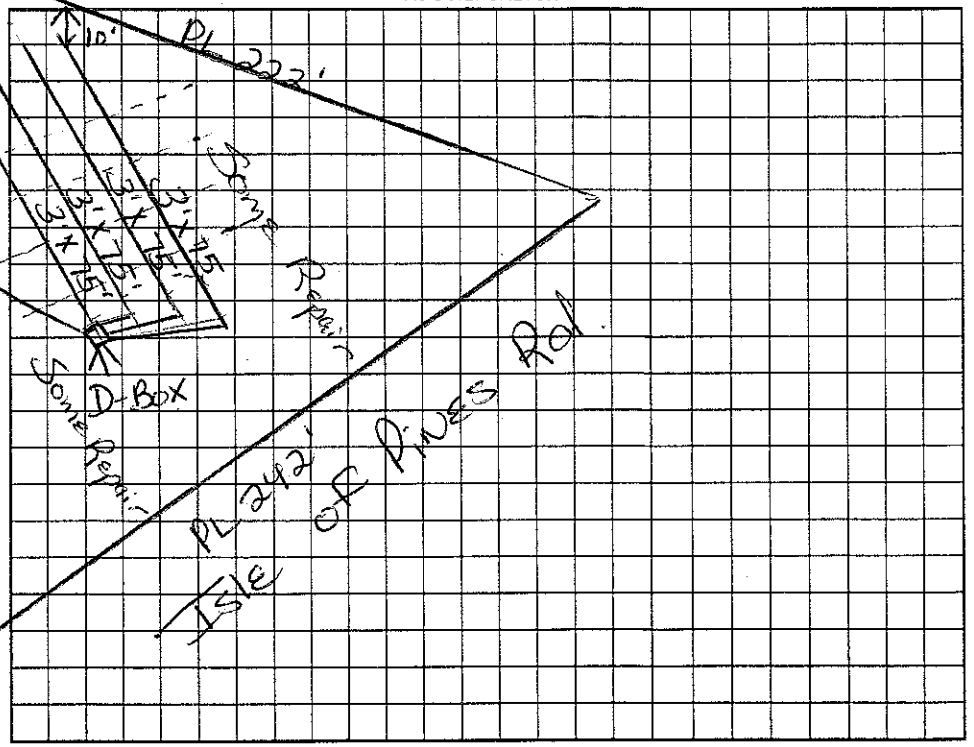

Permit can be suspended or revoked if any false information is supplied toward securing the permit/any unauthorized changes are made to the site/any unauthorized changes are made in the installation of the system. Improvement Permit with plat valid without expiration. Improvement Permit with site plan valid for sixty months. Authorization to Construct is valid for a period equal to that of Improvement Permit – not to exceed sixty months.

Signed: Dan E. Byers Jr. date 11-22-00 Installed by: Charles Beaty

Improvement Permit by: Maria H. Dotson RS date 11/20/2000 Operation Permit by: Maria H. Dotson RS date 12/1/2000

Authorization to Construct by: Maria H. Dotson RS date 11/20/2000 Existing System Inspection by: date

HEALTH DEPT. COPY: WHITE OWNER COPY (FINAL): YELLOW OWNER COPY (INITIAL): PINK

2:00 Charles Beatty 828 478-3514

IREDELL COUNTY HEALTH DEPARTMENT

STATESVILLE 704-878-5305 MOORESVILLE 704-664-5281

IMPROVEMENT PERMIT / AUTHORIZATION TO CONSTRUCT / OPERATION PERMIT / EXISTING SYSTEM INSPECTION

PERMIT# 084200 PIN# 4636219065 DATE 10/29/99

OWNER OR CONTRACTOR David Brodigan PHONE: Business _____ Home 663-4422

ADDRESS 123 Shoreview Dr Mooresville NC 28117

LOCATION Brawley School Rd TL Isle of Pines TR Cove Creek TR High Sail at end of cul-de-sac

SUBDIVISION North Shore BLOCK / SECTION _____ LOT 82 LOT AREA 1.18 Acre SITE CLASS. PS DESIGN FLOW 360gpd L.T.A.R. .3

Septic Tank: 1000 Gallons; STB _____ Date _____

Pump Tank: _____ Gallons; PT _____ Date _____

Pump Make: _____ Model _____ Serial No. _____

Nitrification Field: No Fields 1 Square Feet 1200' Linear Feet 400'

No Lines 4 at 100' Trench Width 36" Max Trench Bottom Depth 36" Gravel Depth 12"

[X] New System [ ] Repair System Type: I, II, III, IV, V, VI

System Description: Gravity - Conventional

Repair System Description: Grav/Pump-Modified

Maintenance Agreement Required: [ ] Yes [ ] No

[X] House/Mod. Home No. Bedrooms 3

[ ] Mobile Home No. Bathrooms 2.5

[ ] Business No. Employees _____

[ ] Other _____

[ ] Slab [X] Crawl Space [ ] Basement w/plumbing [ ] Basement wo/plumbing


Water Supply: [ ] Individual [X] Public [X] Community

Comments:/Conditions: *Plumbing should be stubbed out at higher end of house.


Comments:/Conditions: Keep Septic System 10' from PL @ 5' from house. Replaces permit from 12/30/96.

Scale 1:50

INITIAL SITE SKETCH

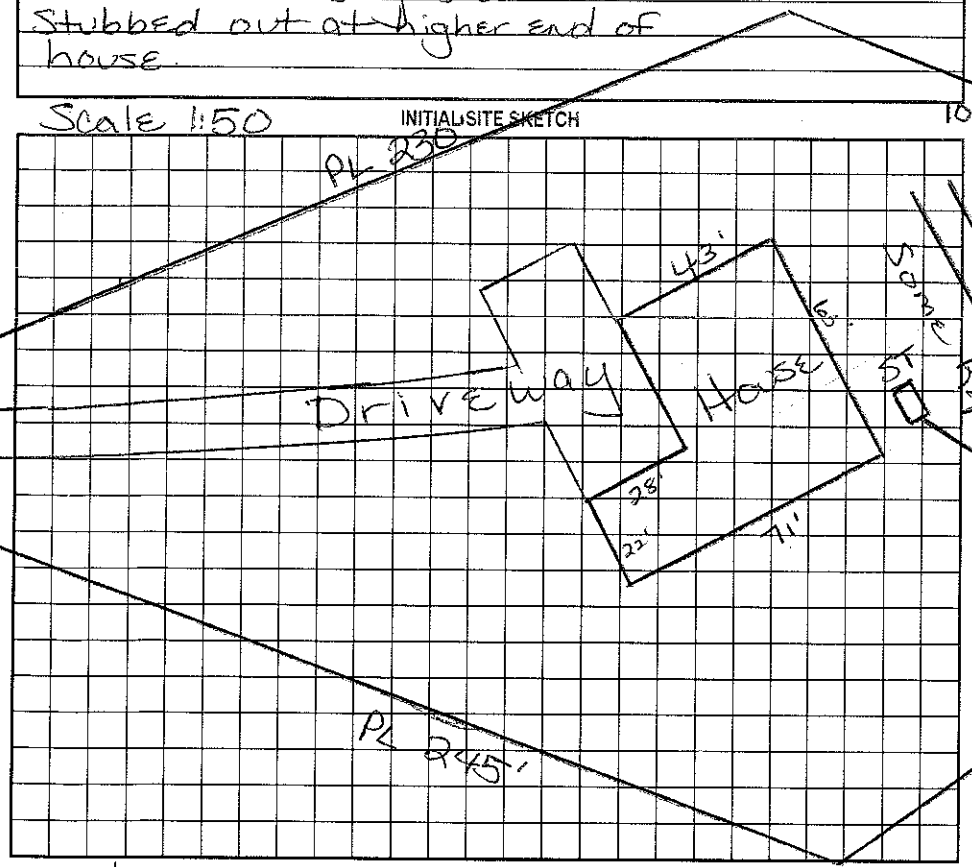

AS BUILT SKETCH

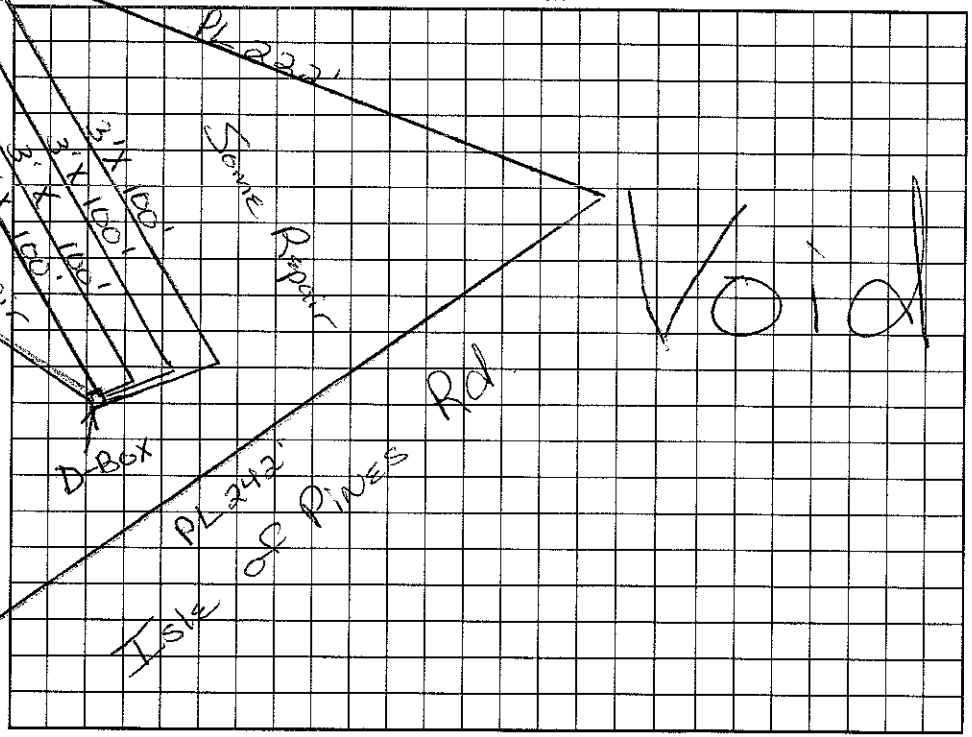

Permit can be suspended or revoked if any false information is supplied toward securing the permit/any unauthorized changes are made to the site/any unauthorized changes are made in the installation of the system. Improvement Permit with plat valid without expiration. Improvement Permit with site plan valid for sixty months. Authorization to Construct is valid for a period equal to that of Improvement Permit – not to exceed sixty months.

Signed: David C. Brodigan date 11-1-99 Installed by: _____

Improvement Permit by: Marian H. H. Dotson R.S. date 10/29/99 Operation Permit by: _____ date _____

Authorization to Construct by: Marian H. H. Dotson R.S. date 10/29/99 Existing System Inspection by: _____ date _____

HEALTH DEPT. COPY: WHITE OWNER COPY (FINAL): YELLOW OWNER COPY (INITIAL): PINK