IREDELL COUNTY HEALTH DEPARTMENT

STATESVILLE 704-878-5305 130.00 Paid 3:00 MOORESVILLE 704-664-5281

IMPROVEMENT PERMIT / AUTHORIZATION TO CONSTRUCT / OPERATION PERMIT / EXISTING SYSTEM INSPECTION

PERMIT# 108646 PIN# ~~4636216368.02~~ 4636219377 DATE Nov. 18, 02

OWNER OR CONTRACTOR Easter Development PHONE: Business _____ Home _____

ADDRESS 227 Hideaway Lane Mooresville N.C. 28117

LOCATION Brawley School Road TL Isle of Pines TR English Ivy Lane 2nd lot on left

SUBDIVISION Stonegate I BLOCK / SECTION _____ LOT 2 LOT AREA .74 ac SITE CLASS. IB DESIGN FLOW 480gpd L.T.A.R. .25-.3

Septic Tank: 1000 Gallons; STB 1007 Date 3/31/03

Pump Tank: _____ Gallons; P.T _____ Date _____

Pump Make: _____ Model _____ Serial No. _____

Nitrification Field: No Fields 1 Square Feet 1440 Linear Feet 480

No Lines 5 Trench Width 36" Max Trench Bottom Depth 36" Gravel Depth NA

☑ New System ☐ Repair System Type: I. II. III. IV. V. VI

System Description: Gravity 25% Reduction

Repair System Description: LPP BPS

Maintenance Agreement Required: ☐ Yes ☑ No Initially

☑ House/Mod. Home No. Bedrooms 4

☐ Mobile Home No. Bathrooms 3

☐ Business No. Employees _____

☐ Other _____


☐ Slab ☑ Crawl Space ☐ Basement w/plumbing ☐ Basement wo/plumbing

Water Supply: ☑ Individual ☐ Public ☐ Community


Comments:/Conditions:

Comments:/Conditions:

1"=50' INITIAL SITE SKETCH

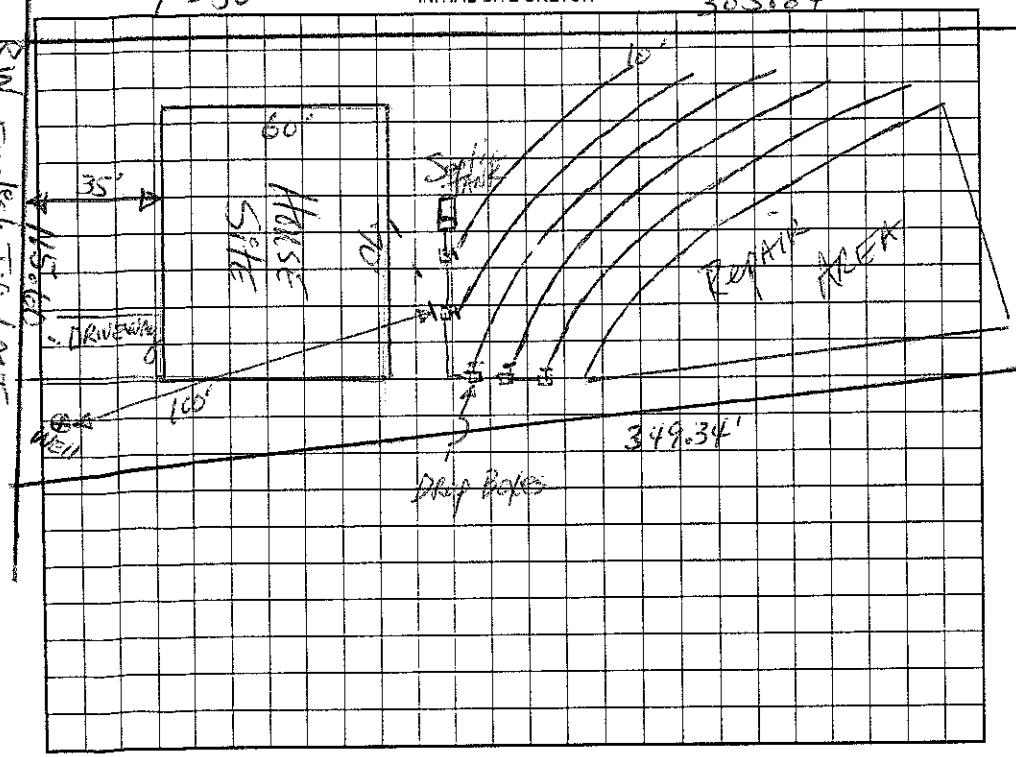

AS BUILT SKETCH

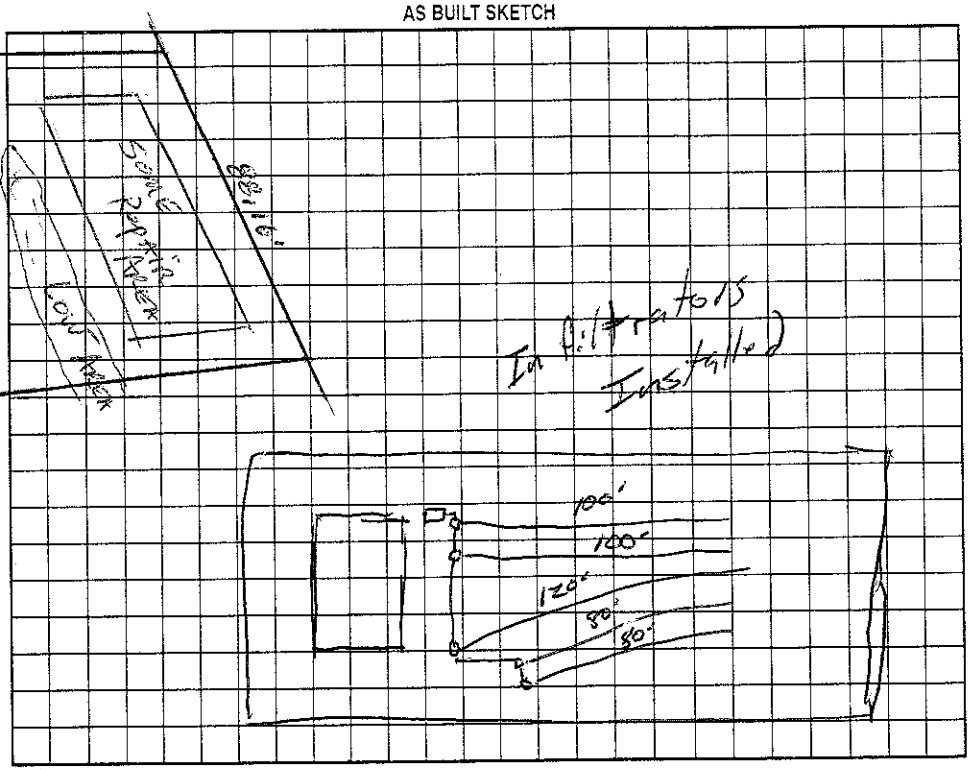

Permit can be suspended or revoked if any false information is supplied toward securing the permit/any unauthorized changes are made to the site/any unauthorized changes are made in the installation of the system. Improvement Permit with plat valid without expiration. Improvement Permit with site plan valid for sixty months. Authorization to Construct is valid for a period equal to that of Improvement Permit – not to exceed sixty months.

Signed: _____ date 12-11-02 Installed by: Jody Travis

Improvement Permit by: _____ IRS date 11-18-02 Operation Permit by: _____ RS date 6/2/03

Authorization to Construct by: _____ IRS date 12-17-02 Existing System Inspection by: _____ date _____

HEALTH DEPT. COPY: WHITE OWNER COPY (FINAL): YELLOW OWNER COPY (INITIAL): PINK