IREDELL COUNTY HEALTH DEPARTMENT

STATESVILLE 704-878-5305 (10:30 - 11:00) MOORESVILLE 704-664-5281

IMPROVEMENT PERMIT / AUTHORIZATION TO CONSTRUCT / OPERATION PERMIT / EXISTING SYSTEM INSPECTION

PERMIT# 18700 PIN# part of 2FB10 4686-22-0035 DATE 3/5/98

OWNER OR CONTRACTOR Paul Sinderman / HEINZ II PHONE: Business (704) 948-1995 ~~Home~~ Mob. 619-5365

ADDRESS 7914 Gilead Rd Huntersville, NC 28078

LOCATION Brawley School Rd TL Isle of Pines TR Cove Creek Rd TR Mussel Ct at End

SUBDIVISION Northshore BLOCK / SECTION II-3 LOT 67 LOT AREA 24,179 ft² SITE CLASS. PS DESIGN FLOW 480 gpd L.T.A.R. .3

Septic Tank: 1000 Gallons; STB 794 Date 2/19/98
Pump Tank: 1000 Gallons; PT 27 Date 12/2/97
Pump Make: _____ Model _____ Serial No. _____
Nitrification Field: No. Fields 1 Square Feet _____ Linear Feet 270'
No Lines 3 at 90' Trench Width 36" Max Trench Bottom Depth 36"

☒ New System ☐ Repair System Type: I, II, III, ⓘ V, VI
System Description: LP PPBPS
Repair System Description: Same
Maintenance Agreement Required: ☒ Yes ☐ No

☒ House/Mod. Home No. Bedrooms 4
☐ Mobile Home No. Bathrooms 4
☐ Business No. Employees ____
☐ Other _____

Water Supply: ☐ Individual ☐ Public ☒ Community


Gravel Depth N/A ☐ Slab ☒ Crawl Space ☐ Basement w/plumbing ☐ Basement wo/plumbing

Comments:/Conditions: Keep Septic System 50' From well if Downgradient & 100' if Upgradient of "Bond" Well

Comments:/Conditions: (Building Permit Issued without "Ready to Issue" or "Auth to Construct" being issued.

Scale 1" = 50'

INITIAL SITE SKETCH (Bond)

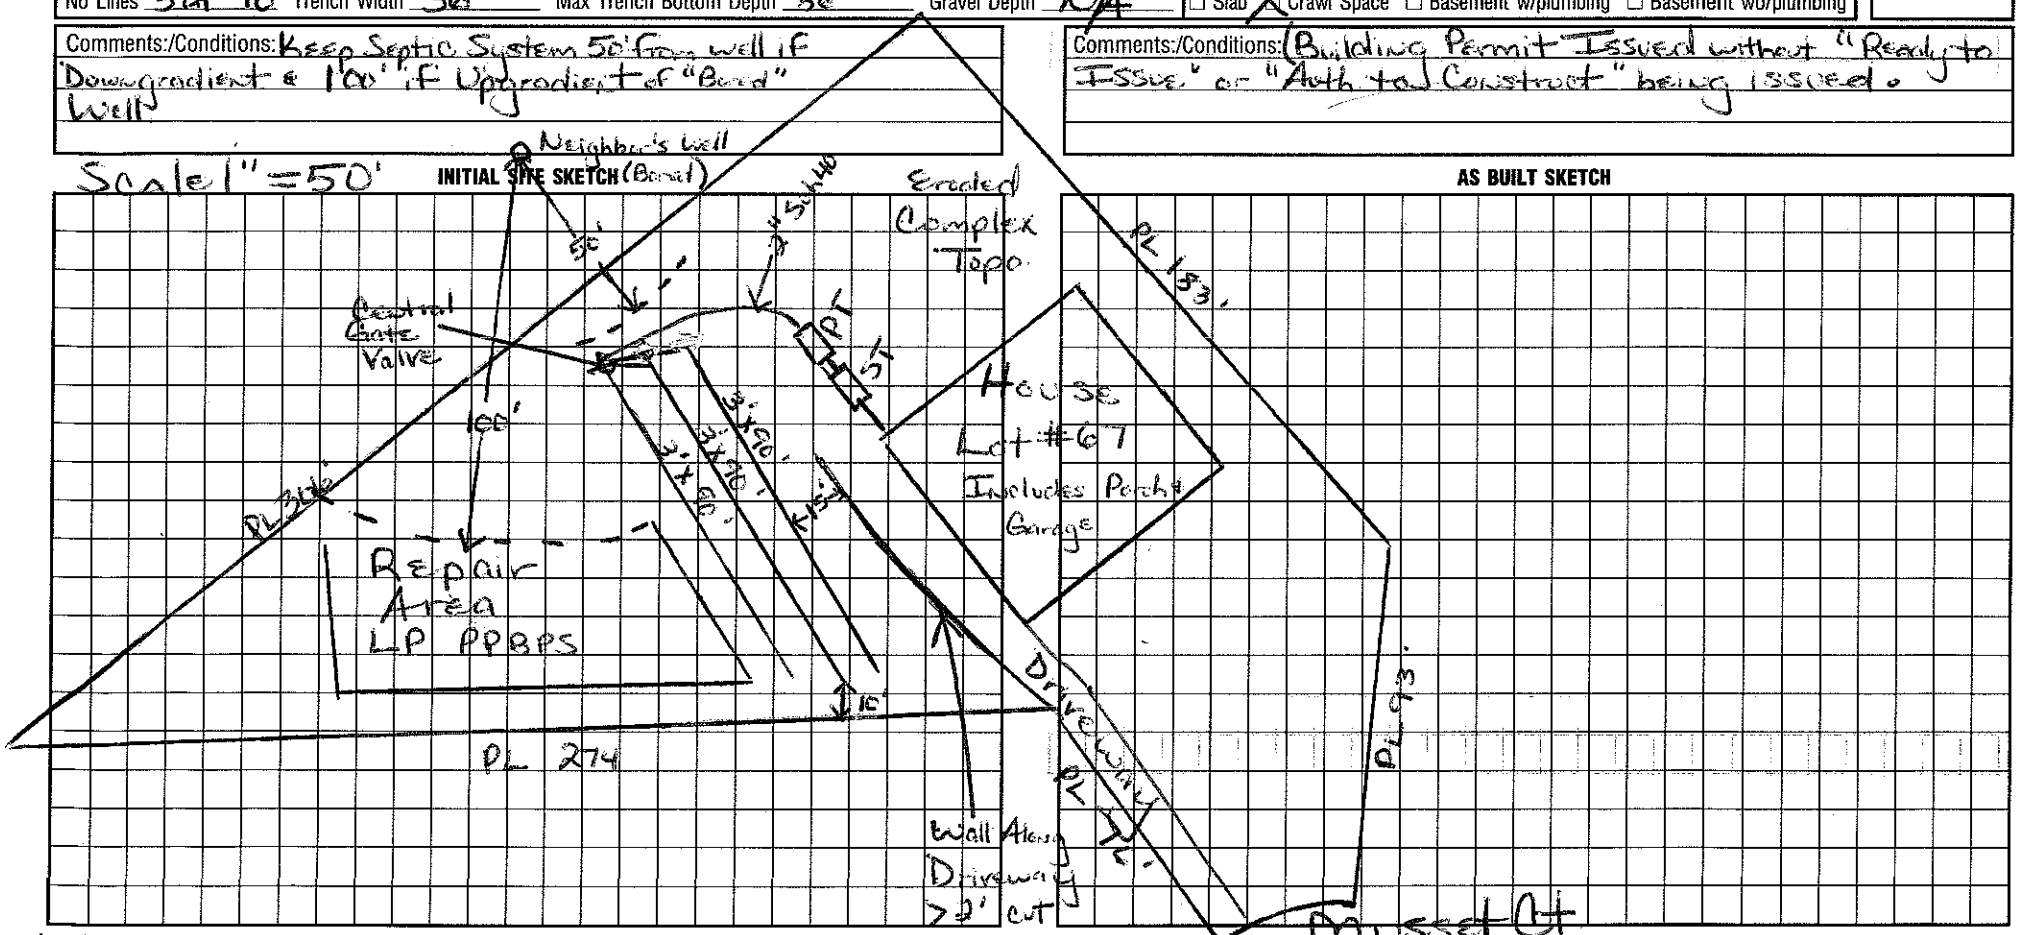

AS BUILT SKETCH

I understand that this permit can be suspended or revoked if any false information is supplied toward securing the permit/any unauthorized changes are made to the site/any unauthorized changes are made in the installation of the system. Improvement Permit with plat valid without expiration. Improvement Permit with site plan valid for sixty months. Authorization to Construct is valid for a period equal to that of Improvement Permit – not to exceed sixty months.

Signed: H Paul Sinderman II T/A HEINZ II date 3/11/98

Improvement Permit by: Maria H. Dotson date 3/5/98

Authorization to Construct by: Maria H. Dotson date 3/5/98

Installed by: Lewon Benton

Operation Permit by: Wesley Sparks RS date 6/23/98

Existing System Inspection by: Wesley Sparks RS date 6/23/98

HEALTH DEPT. COPY: WHITE INSPECTION COPY (FINAL): GREEN OWNER COPY (FINAL): YELLOW INSPECTION COPY (INITIAL): PINK OWNER COPY (INITIAL): GOLD