IREDELL COUNTY HEALTH DEPARTMENT

STATESVILLE 704-878-5305 MOORESVILLE 704-664-5281

IMPROVEMENT PERMIT / AUTHORIZATION TO CONSTRUCT / OPERATION PERMIT / EXISTING SYSTEM INSPECTION

PERMIT# 133759 202154 PIN# ~~4636-23-313-.014~~ 4636-22-0818 DATE March 24, 06

OWNER OR APPLICANT Ulysses Enterprises PHONE: Business _____ Home _____

ADDRESS 2125 Stratton Rd Charlotte NC 28211

LOCATION Brawley School Rd TR Lake of Pines TR Rocky Farm Rd on left 3rd lot past Wheaton Way

SUBDIVISION Rocky Ridge Pt BLOCK / SECTION _____ LOT 14 LOT AREA ~~1.02~~ 1.02 Ac SITE CLASS. B5 DESIGN FLOW 400 gpd T.A.R. .03

Septic Tank: ~~1~~ 1500 Gallons; STB 833 Date 5-23-14

Pump Tank: _____ Gallons; PT _____ Date _____

Pump Make: _____ Model _____ Serial No. _____

Nitrification Field: No Fields 1 Square Feet 1200 Linear Feet 400

No Lines 3 Trench Width 36" Max Trench Bottom Depth 36" Gravel Depth NA

☒ New System ☐ Repair ☐ Expansion System Type: I II III IV V VI

System Description: Gravity 25% Reduction

Repair System Description: PPPBPS

Maintenance Agreement Required: ☐ Yes ☒ No Initially

☒ Gravity ☐ Pressure

☒ House/Mod. Home ☐ Mobile Home ☐ Business ☐ Other

No. Bedrooms 4 No. Persons _____ No. Employees _____

Water Supply: ☐ Individual ☒ Public ☒ Community

☐ Slab ☒ Crawl Space ☐ Basement w/plumbing ☐ Basement wo/plumbing

Comments:/Conditions: ~~1~~ PER Plan Specs

Shave off burms in septic system area.

Comments:/Conditions:

INITIAL SITE SKETCH

SEE Plan from S+ME

AS BUILT SKETCH

Permit can be suspended or revoked if any false information is supplied toward securing the permit/any unauthorized changes are made to the site/any unauthorized changes are made in the installation of the system. Improvement Permit with plat valid without expiration ☐ Improvement Permit with site plan valid for sixty months ☒ Authorization to Construct is valid for a period equal to that of Improvement Permit – not to exceed sixty months.

Signed: Robert Brandenburg date 4/11/06

Improvement Permit by: D Johnson 18 date 3-24-06

Authorization to Construct by: R Kelly APPROVED MAR 14 2014 date _____


Installed by: _____

Operation Permit by: R Kelly date 6-30-14


Existing System Inspection by: _____ date _____

HEALTH DEPT. COPY: WHITE OWNER COPY (FINAL): YELLOW OWNER COPY (INITIAL): PINK

Revised - Rec'd 3-24-06

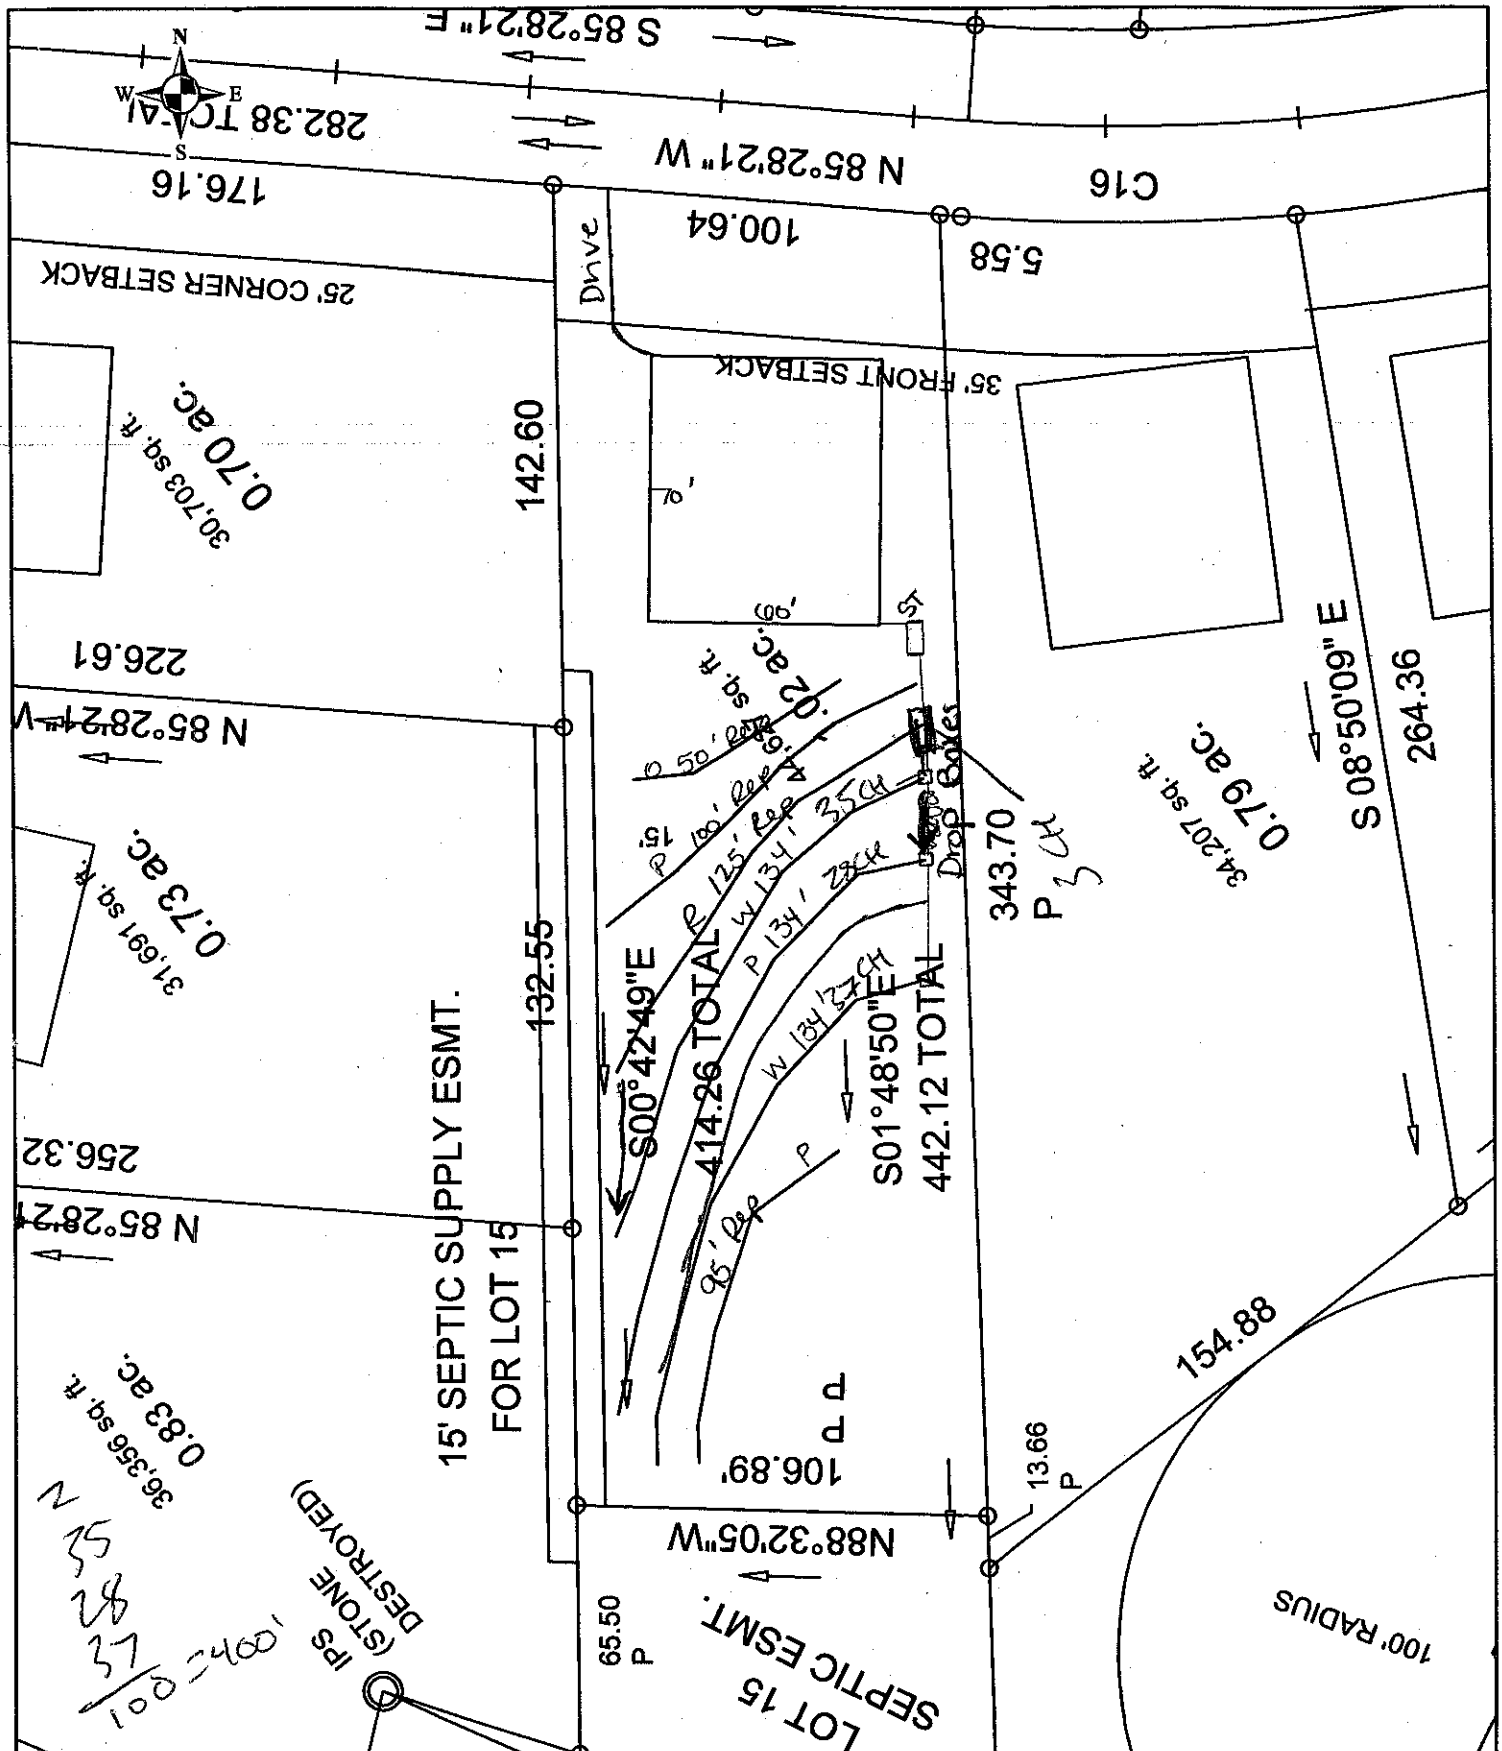

Scale: 1 inch equals 50 feet	S&ME ENVIRONMENTAL SERVICES • ENGINEERING • TESTING	Rocky Ridge - Lot 14	FIGURE
Drawn by: JBP		Scaled Detailed Site Plan	1
Reviewed by: PGP		Iredell County, NC	
Date: March, 2006		S&ME Project #1588-05-081	

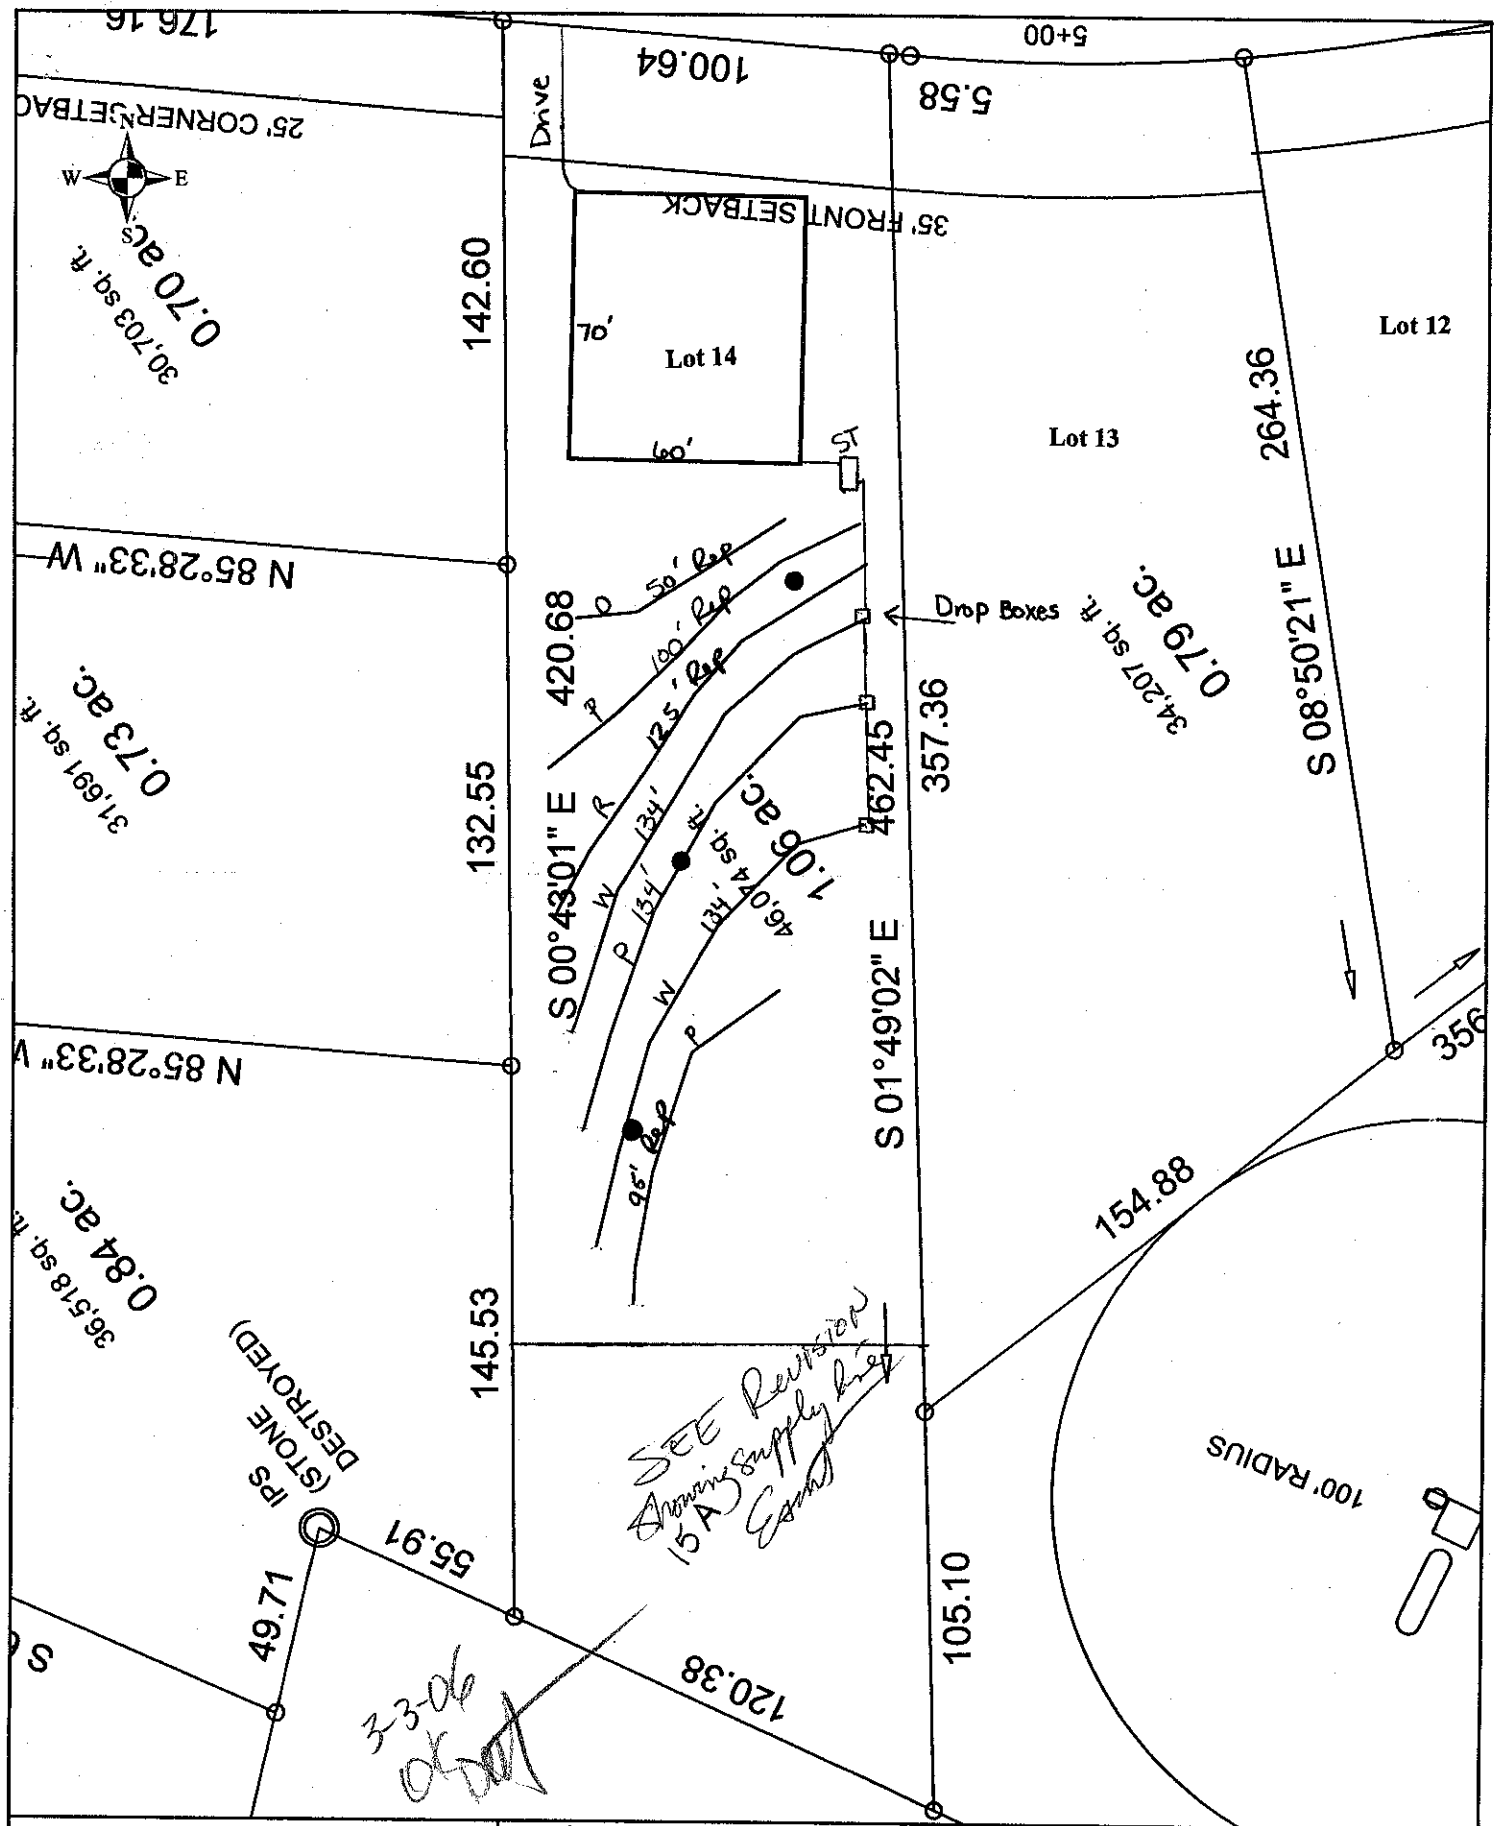

Scale: 1 inch equals 50 feet	S&ME	Rocky Ridge - Lot 14	FIGURE
Drawn by: JBP	ENVIRONMENTAL SERVICES • ENGINEERING • TESTING	Scaled, Detailed Site Plan	1
Reviewed by: PGP		Iredell County, NC	
Date: January, 2006		S&ME Project #1588-05-081	