IREDELL COUNTY HEALTH DEPARTMENT

Statesville Office (704) 878-5305 Mooresville Office (704) 660-3625 (3) Old # 133758 PERMIT # 208728

IMPROVEMENT PERMIT / AUTHORIZATION TO CONSTRUCT / OPERATION PERMIT / EXISTING SYSTEM

PIN # 4636-22-1827.000

APPLICANT: True Homes APPLICANT ADDRESS: 2649 Brookridge Center Dr. Monroe NC

SITE ADDRESS: 121 Rock Ridge Point Mooresville, NC PHONE: 704-293-1229 ALT. PHONE:

SITE DIRECTIONS: I-77, 11 Isle Of Pines, TR Rock Ridge Point

SUBDIVISION: Rock Ridge Point SECTION: LOT # 13 LOT AREA: .79 Acre DESIGN FLOW: 480 GPD L.T.A.R.: .3

Septic Tank 1500 (gal) STB GST-2111 Date 7-8-16
Pump Tank (gal) PT Date
Pump Make Model Serial #
Nitrification Fields 1 # Lines 4 @ 100' Linear Ft: 400'
Trench Width 36" Max. Trench Bottom Depth 36" Gravel Depth N/A

☑ New System ☐ Repair ☐ Expansion System Type: I II (III) IV V VI
System Description: 25% Reduction - Gravity
Repair System Description: LP PPBPS
Maintenance Agreement Required: ☐ YES ☒ NO
☒ GRAVITY ☐ PRESSURE

☑ Residence No. Bedrooms 4
☐ Business No. Persons 8
☐ Other No. Employees
☐ Slab ☑ Crawl Space
☐ Basement w/plumbing ☐ Basement w/o plumbing

Water Supply: ☐ Private ☐ Public ☒ Community


Comments / Conditions: 1500 Gal. Tank Per Designer.
If any fill is needed on Initial or Repair use 6" or less fill and use approved fill material

INITIAL SITE SKETCH

See Attached Approved Design By Septic Environmental Solutions Dated APPROVED MAR 13 2015

AS BUILT SKETCH

10-21-16: Gamble Septic Tanks (precast) 1500 top seam tank installed w/ a Polylok PL-68 Filter (red in black housing) - OK

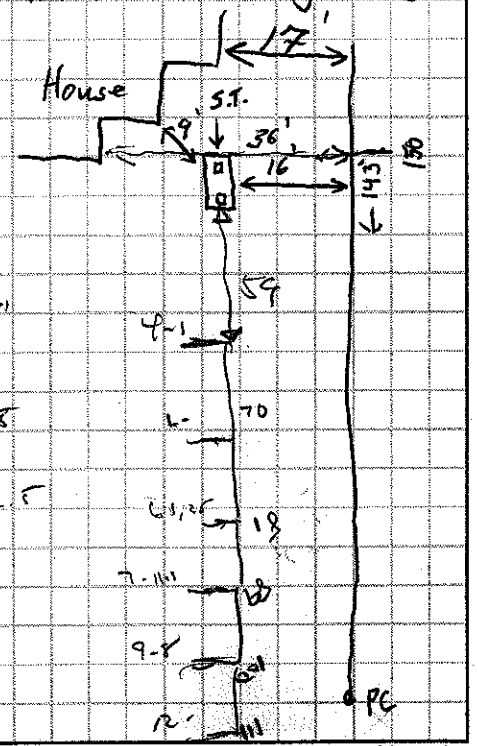

Permit can be suspended or revoked if any false information is supplied toward securing the permit / any unauthorized changes are made to the site / any unauthorized changes are made in the installation of the system. **CONTACT A LOCATOR SERVICE PRIOR TO ANY EXCAVATION**

☐ **IMPROVEMENT PERMIT** *with plat valid without expiration.* ☒ **IMPROVEMENT PERMIT** *with site plan valid for 60 mos.* ☒ **AUTHORIZATION TO CONSTRUCT** *valid for period equal to IMPROVEMENT PERMIT--not to exceed 60 mo.*


Owner / Applicant Signature: Date: 3-16-15 Installed by: Sid Gaskins

IMPROVEMENT PERMIT by: APPROVED MAR 13 2015 OPERATION PERMIT by: W Sparks Date: 10/24/16

AUTHORIZATION TO CONSTRUCT by: APPROVED Date: JUN 01 2016 Existing System Inspected by: Date:

Health Dept. Copy - WHITE Applicant (Final Approval) - YELLOW Applicant (Conditional Approval) - PINK

ROCKRIDGE POINT SUBDIVISION

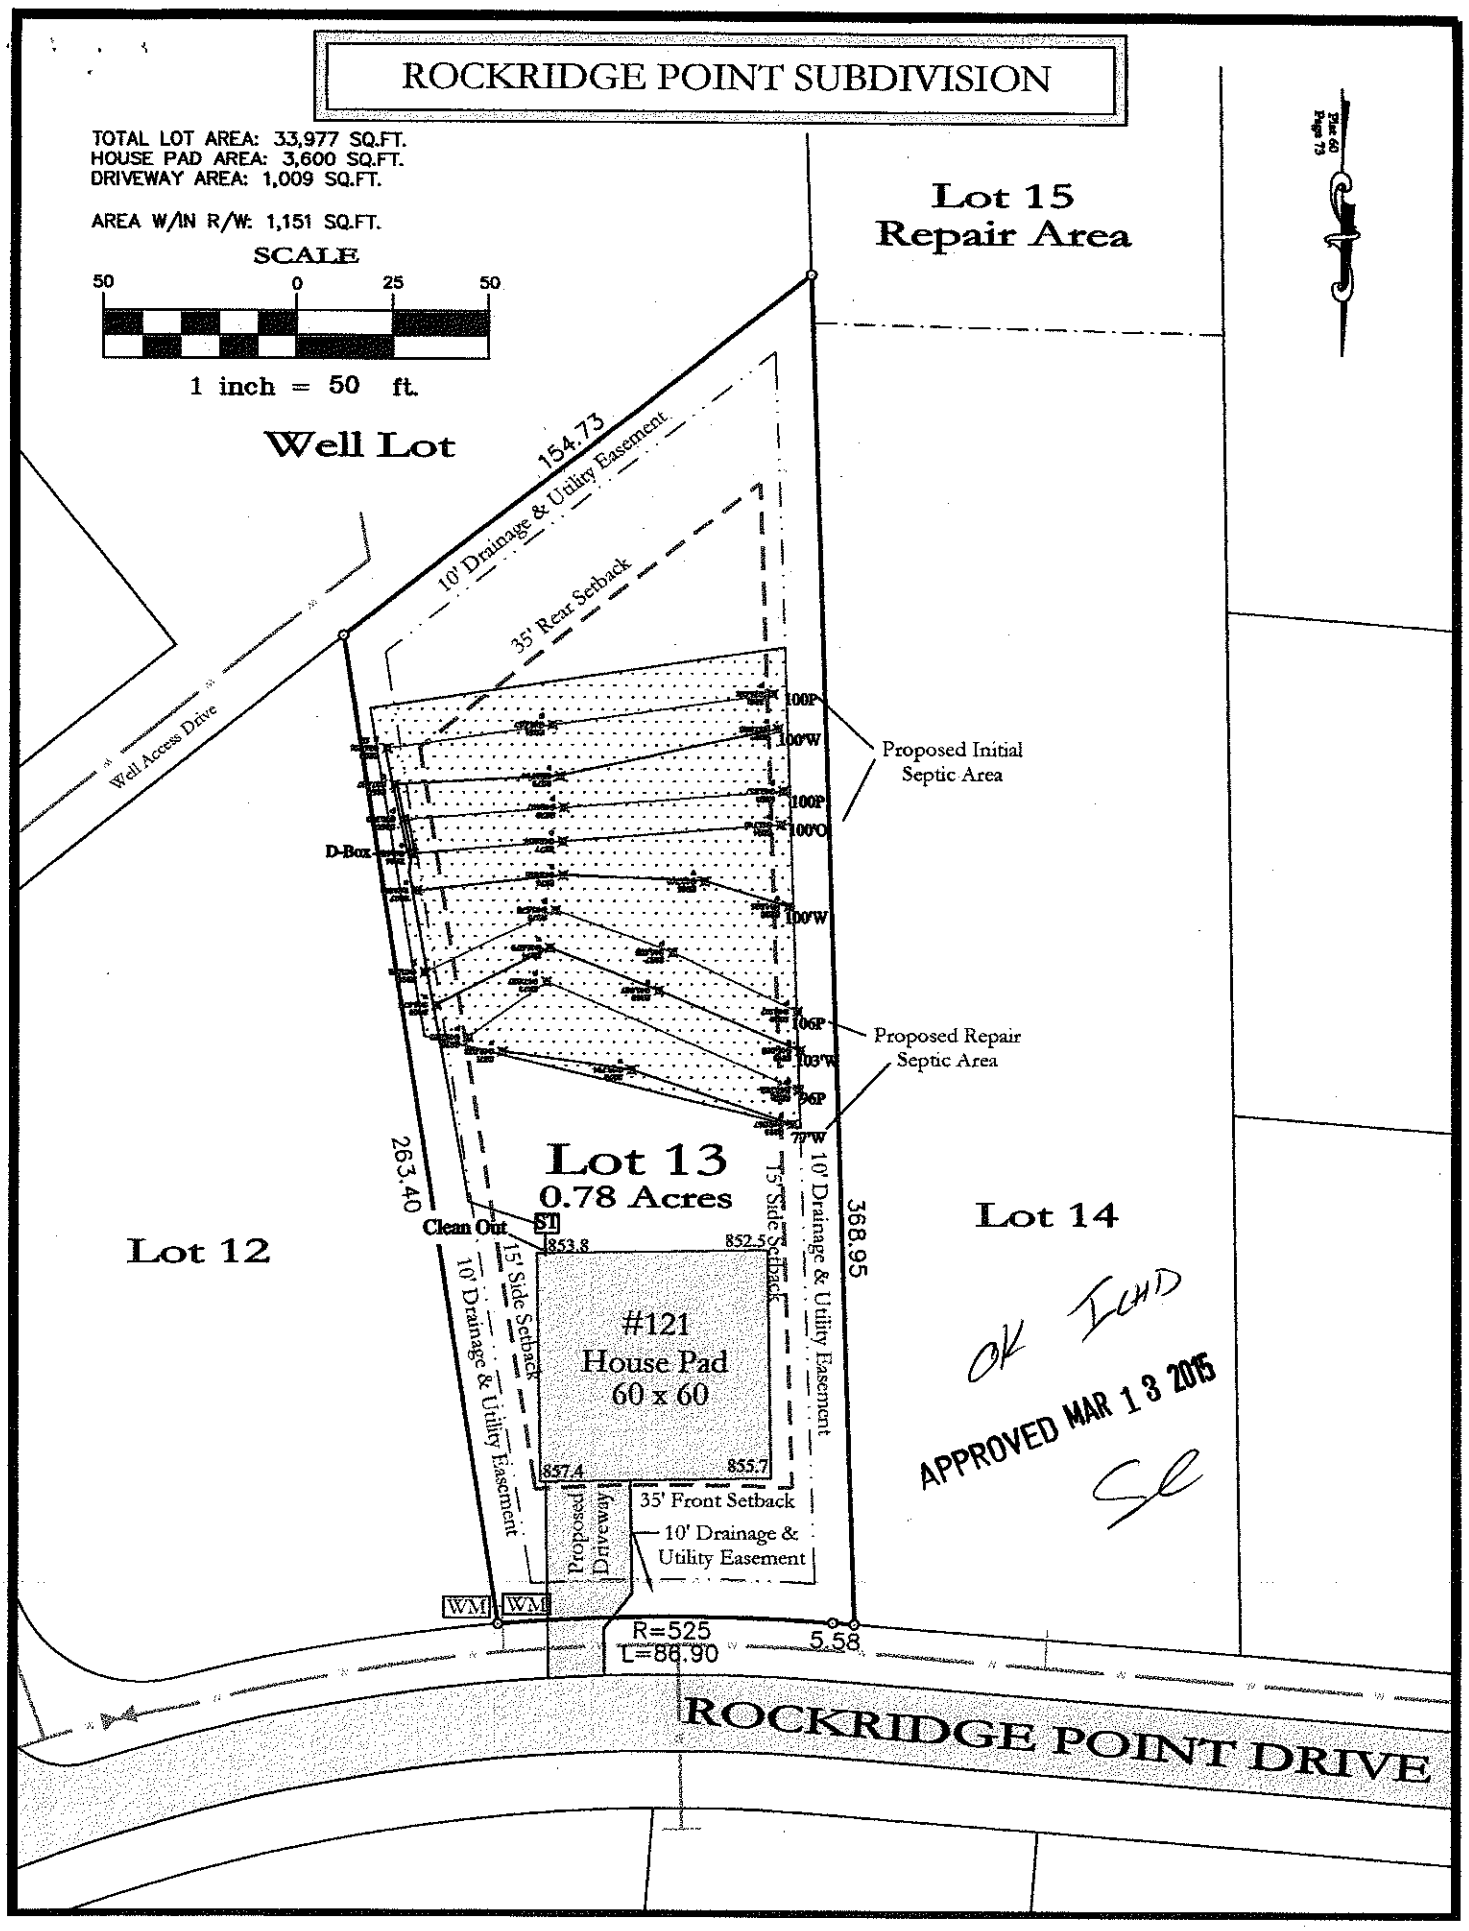

OK ICHD

APPROVED MAR 13 2015

SE

150 STB