IREDELL COUNTY HEALTH DEPARTMENT

Authorization to Construct

STATESVILLE 704-878-5305 MOORESVILLE 704-664-5281

IMPROVEMENT PERMIT / ~~CERTIFICATE OF COMPLETION~~ / OPERATION PERMIT / EXISTING SYSTEM INSPECTION

PROPERTY DESCRIPTION NO. 23047 DATE 2/7/96 TAX MAP NO. 2G 23 B 68 4636 22 2034 Watershed: X Yes ☐ No

OWNER OR CONTRACTOR Robert Ingram Homes PHONE: Business 704-391-3715 Home

ADDRESS 2900 B I-85 Service Cher. NC. 28208

LOCATION 1100 TL Lake of Pines TR Cove Creek Rd TR Mussel Ct. at end off cul de sac

SUBDIVISION North Shore BLOCK / SECTION II ph3 LOT 68 LOT AREA 1 acre SITE CLASS. P3 DESIGN FLOW 480 L.T.A.R. .3

Septic Tank: 1000 Gallons; STB 794 Date 4/16/96

Pump Tank: 1000 Gallons; PT 417 Date 4/20/96

Pump Make: Liberty Model 60 Serial No. —

Nitrification Field: No Fields 4 Square Feet 1600 Linear Feet 400

No Lines 4 Trench Width 36" Max Trench Bottom Depth 36" Gravel Depth 6" SAND

X New System ☐ Repair System Type: I, II, III, IV, V, VI

System Description: Pump&Pin/Elm/Filtrator

Repair System Description: LP PPBS

Maintenance Agreement Required: ☐ Yes X No

X House/Mod. Home No. Bedrooms 4

☐ Mobile Home No. Bathrooms 2.5

☐ Business No. Employees

☐ Other


☐ Slab X Crawl Space ☐ Basement w/plumbing ☐ Basement wo/plumbing

Water Supply: ☐ Individual X Community ☐ Public


Comments: X 25% reduction for elm/filtrator use
Sand backfill

Comments:

INITIAL SITE SKETCH

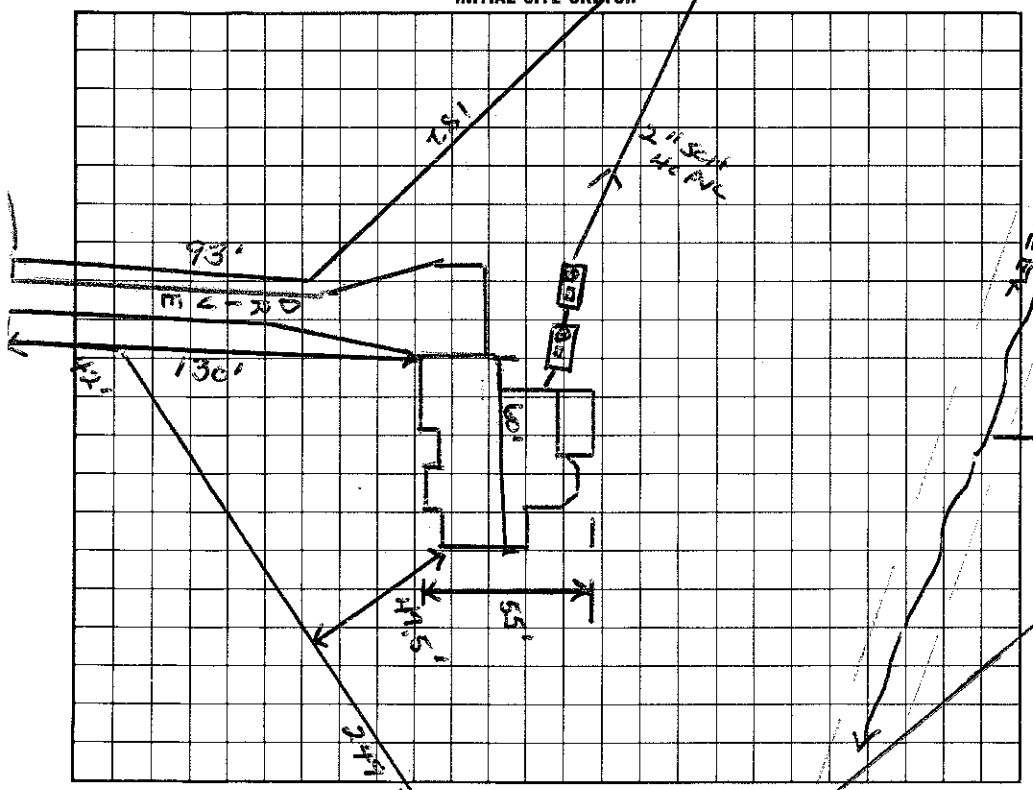

AS BUILT SKETCH

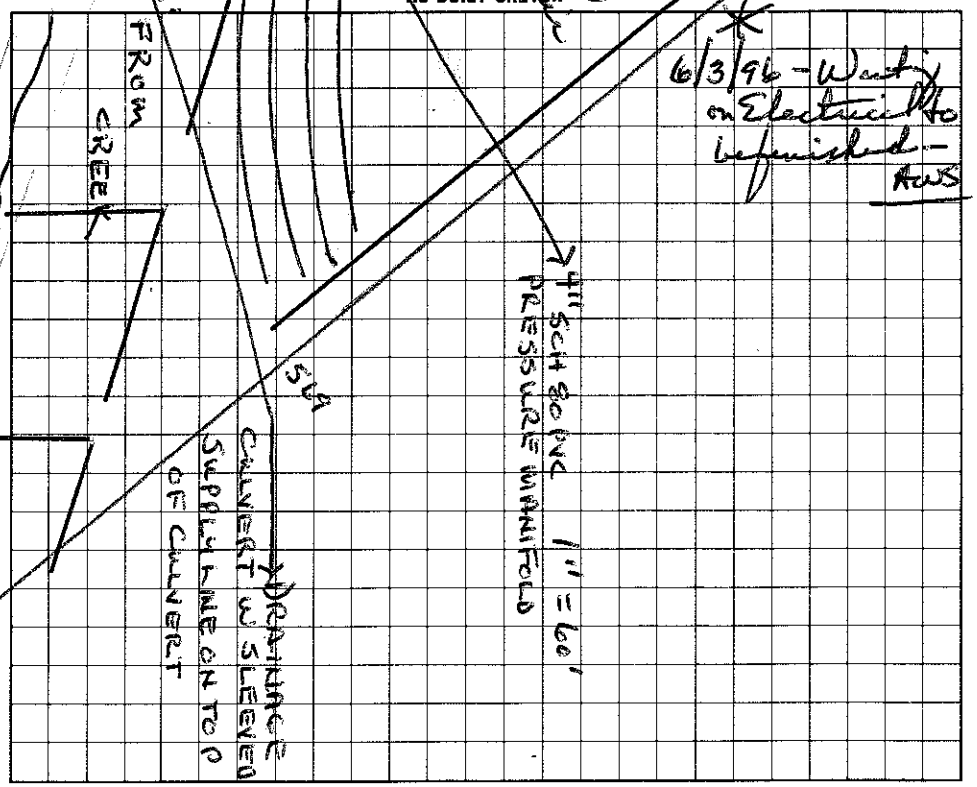

I understand that this permit can be suspended or revoked if any false information is supplied toward securing the permit/any unauthorized changes are made to the site/any unauthorized changes are made in the installation of the system.

Signed: X

Improvement Permit by: Wesley Sparks RS date 2/9/96

Authorization to Construct Existing System Inspection by: Wesley Sparks RS date 2/7/96

Installed by: Elon Horne Trading

Certificate of Completion by: Wesley Sparks R.S. date 6/27/96

Operation Permit by: Wesley Sparks R.S. date 6/27/96

HEALTH DEPT. COPY: WHITE INSPECTION COPY (FINAL): GREEN OWNER COPY (FINAL): YELLOW INSPECTION COPY (INITIAL): PINK OWNER COPY (INITIAL): GOLD