
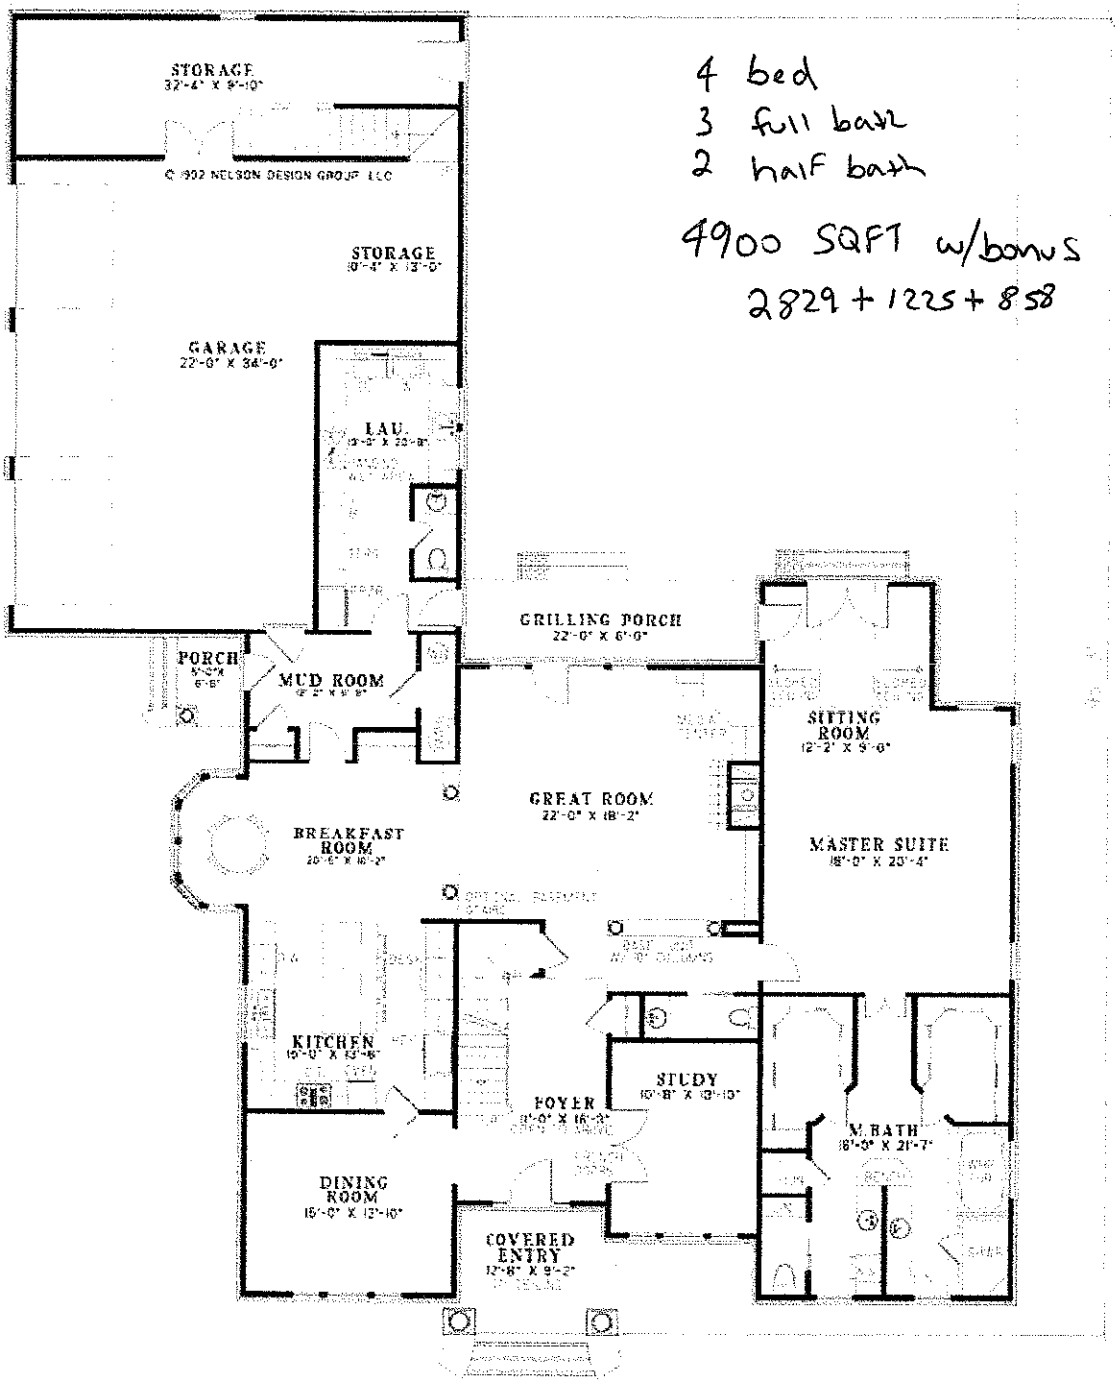



4 bed
3 full bath
2 half bath

4900 SQFT w/bonus
2829 + 1225 + 858

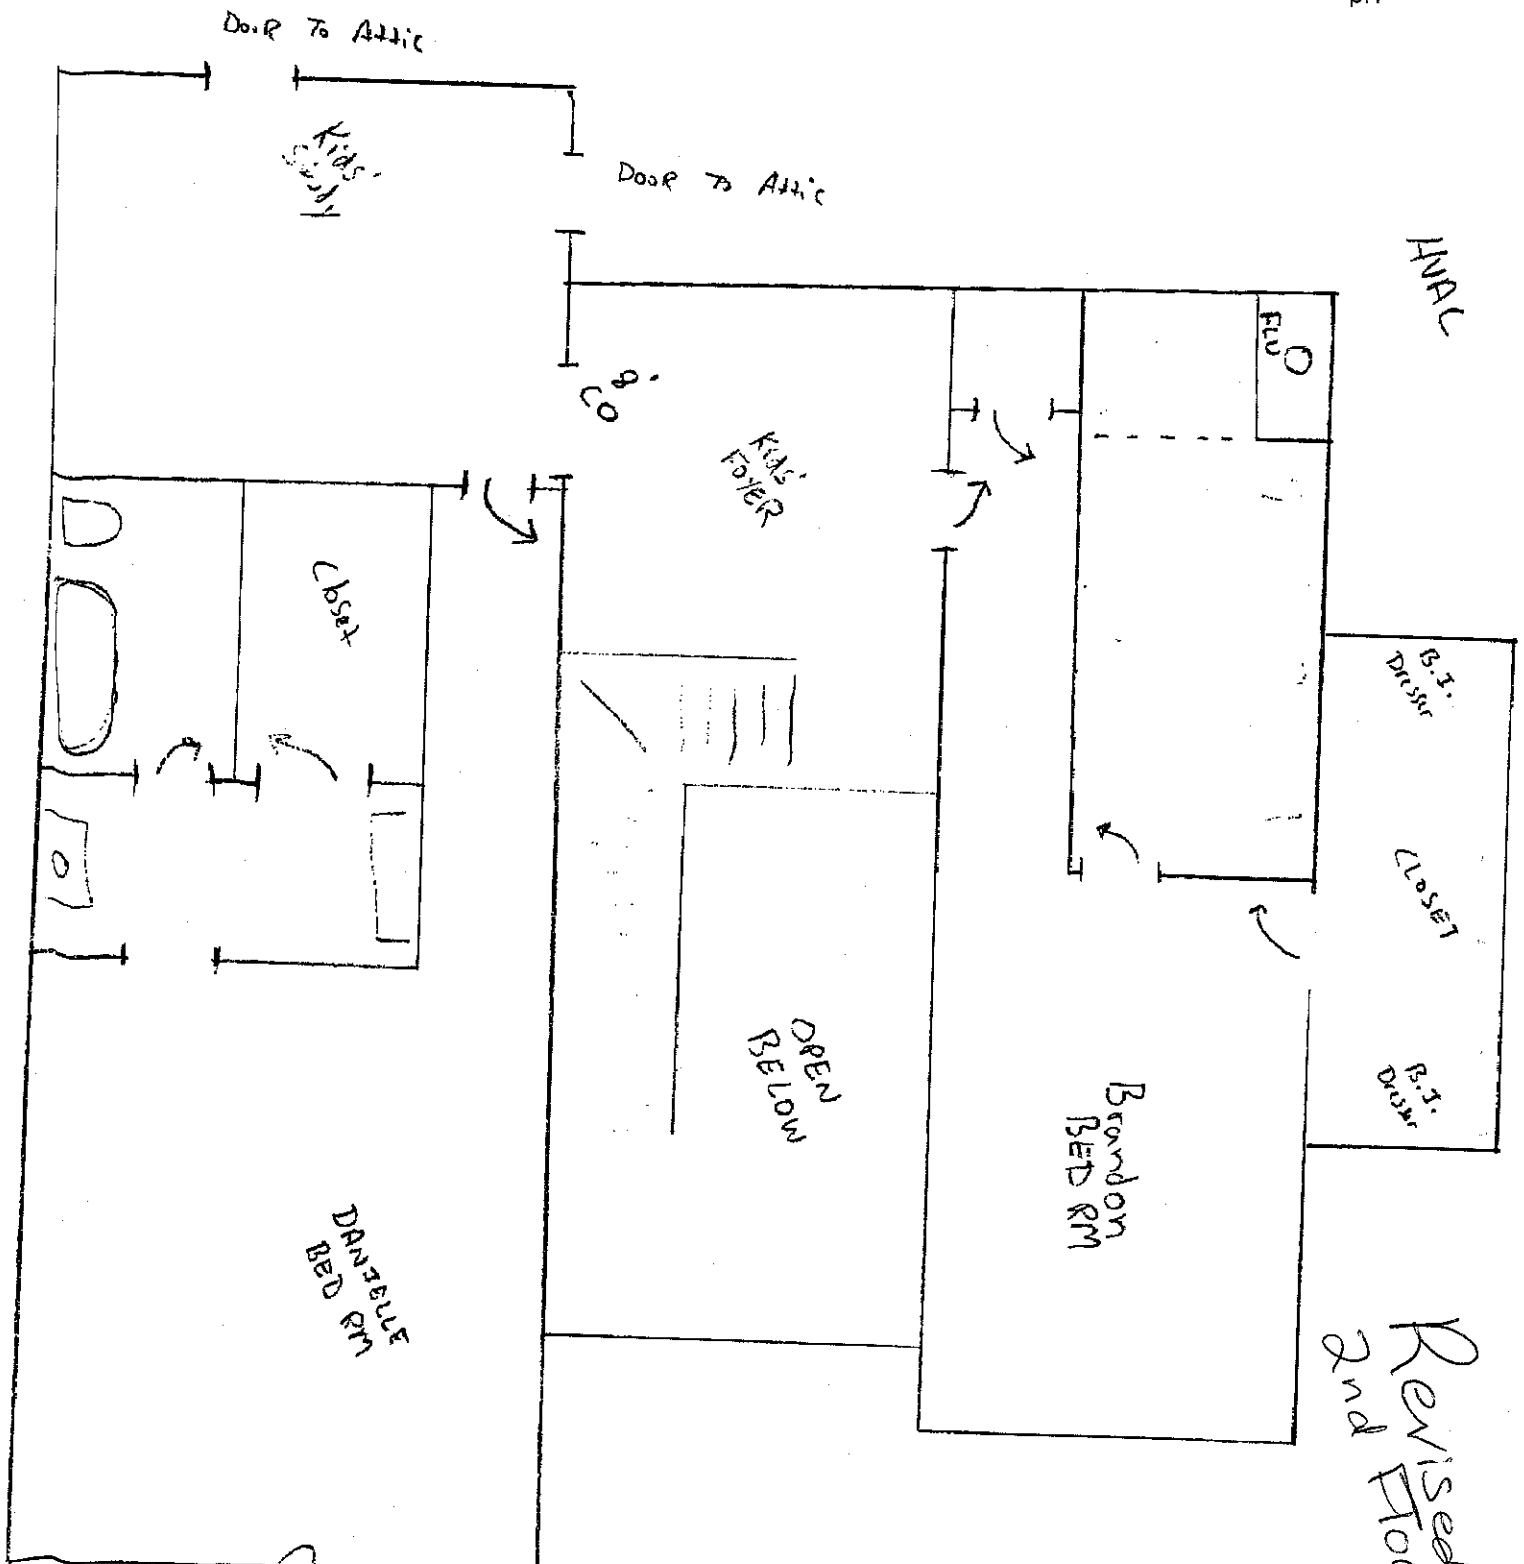


Revised 2nd Floor

Attn: Maria Dotson
704-662-3239

AS Built
10-16-07

REDESIGN
2ND FLOOR
2-BED
2-BATH