IREDELL COUNTY HEALTH DEPARTMENT

Statesville Office (704) 878-5305 Mooresville Office (704) 660-3625 PERMIT # 208722

IMPROVEMENT PERMIT / AUTHORIZATION TO CONSTRUCT / OPERATION PERMIT / EXISTING SYSTEM

PIN # 4636-22-6478

APPLICANT: TRUE Homes APPLICANT ADDRESS: 2649 BRENTON RIDGE CENTRA DR.

SITE ADDRESS: 126 WHEATON LN. - Mooresville PHONE: 704-283-1229 ALT. PHONE:

SITE DIRECTIONS: ISLE OF PINES, TR ROCKRIDGE POINT, TL WHEATON, C END

SUBDIVISION: ROCK RIDGE POINT SECTION: LOT # 7 LOT AREA: .89 AC DESIGN FLOW: 480 L.T.A.R.: .3

Septic Tank 1500 (gal) STB 444 Date 11-30-15
Pump Tank (gal) PT Date
Pump Make Model Serial #
Nitrification Fields 1 # Lines 4 Linear Ft: 410' ★
Trench Width 36" Max. Trench Bottom Depth 36" Gravel Depth —

☒ New System ☐ Repair ☐ Expansion System Type: I II (III) IV V VI
System Description: 25% REDUCTION
Repair System Description: PANEL BLOCK
Maintenance Agreement Required: ☐ YES ☒ NO
☒ GRAVITY ☐ PRESSURE

☒ Residence ☐ Business ☐ Other ☐ Slab ☐ Basement w/plumbing
No. Bedrooms 4 No. Persons No. Employees
☒ Crawl Space ☐ Basement w/o plumbing

Water Supply: ☐ Private ☐ Public ☒ Community

Comments / Conditions:
1000 GAL MIN REQUIRED
★ Only 400ft required @ .3

Chambers 26, 130, 130, 114 line lengths

INITIAL SITE SKETCH

SEE PLAN FROM SEPTIC ENV. SOLUTIONS

AS BUILT SKETCH

Permit can be suspended or revoked if any false information is supplied toward securing the permit / any unauthorized changes are made to the site / any unauthorized changes are made in the installation of the system. **CONTACT A LOCATOR SERVICE PRIOR TO ANY EXCAVATION**

☐ **IMPROVEMENT PERMIT** *with plat valid without expiration.* ☐ **IMPROVEMENT PERMIT** *with site plan valid for 60 mos.* ☐ **AUTHORIZATION TO CONSTRUCT** *valid for period equal to IMPROVEMENT PERMIT--not to exceed 60 mo.*


Owner / Applicant Signature: Date: 10-5-15 Installed by: Sid Gaskins

IMPROVEMENT PERMIT by: APPROVED Date: SEP 29 2015 OPERATION PERMIT by: Maria Dolson Date: 1/6/16

AUTHORIZATION TO CONSTRUCT by: APPROVED Date: SEP 29 2015 Existing System Inspected by: Date:

Health Dept. Copy - WHITE Applicant (Final Approval) - YELLOW Applicant (Conditional Approval) - PINK

APPROVED SEP 2 8 2015

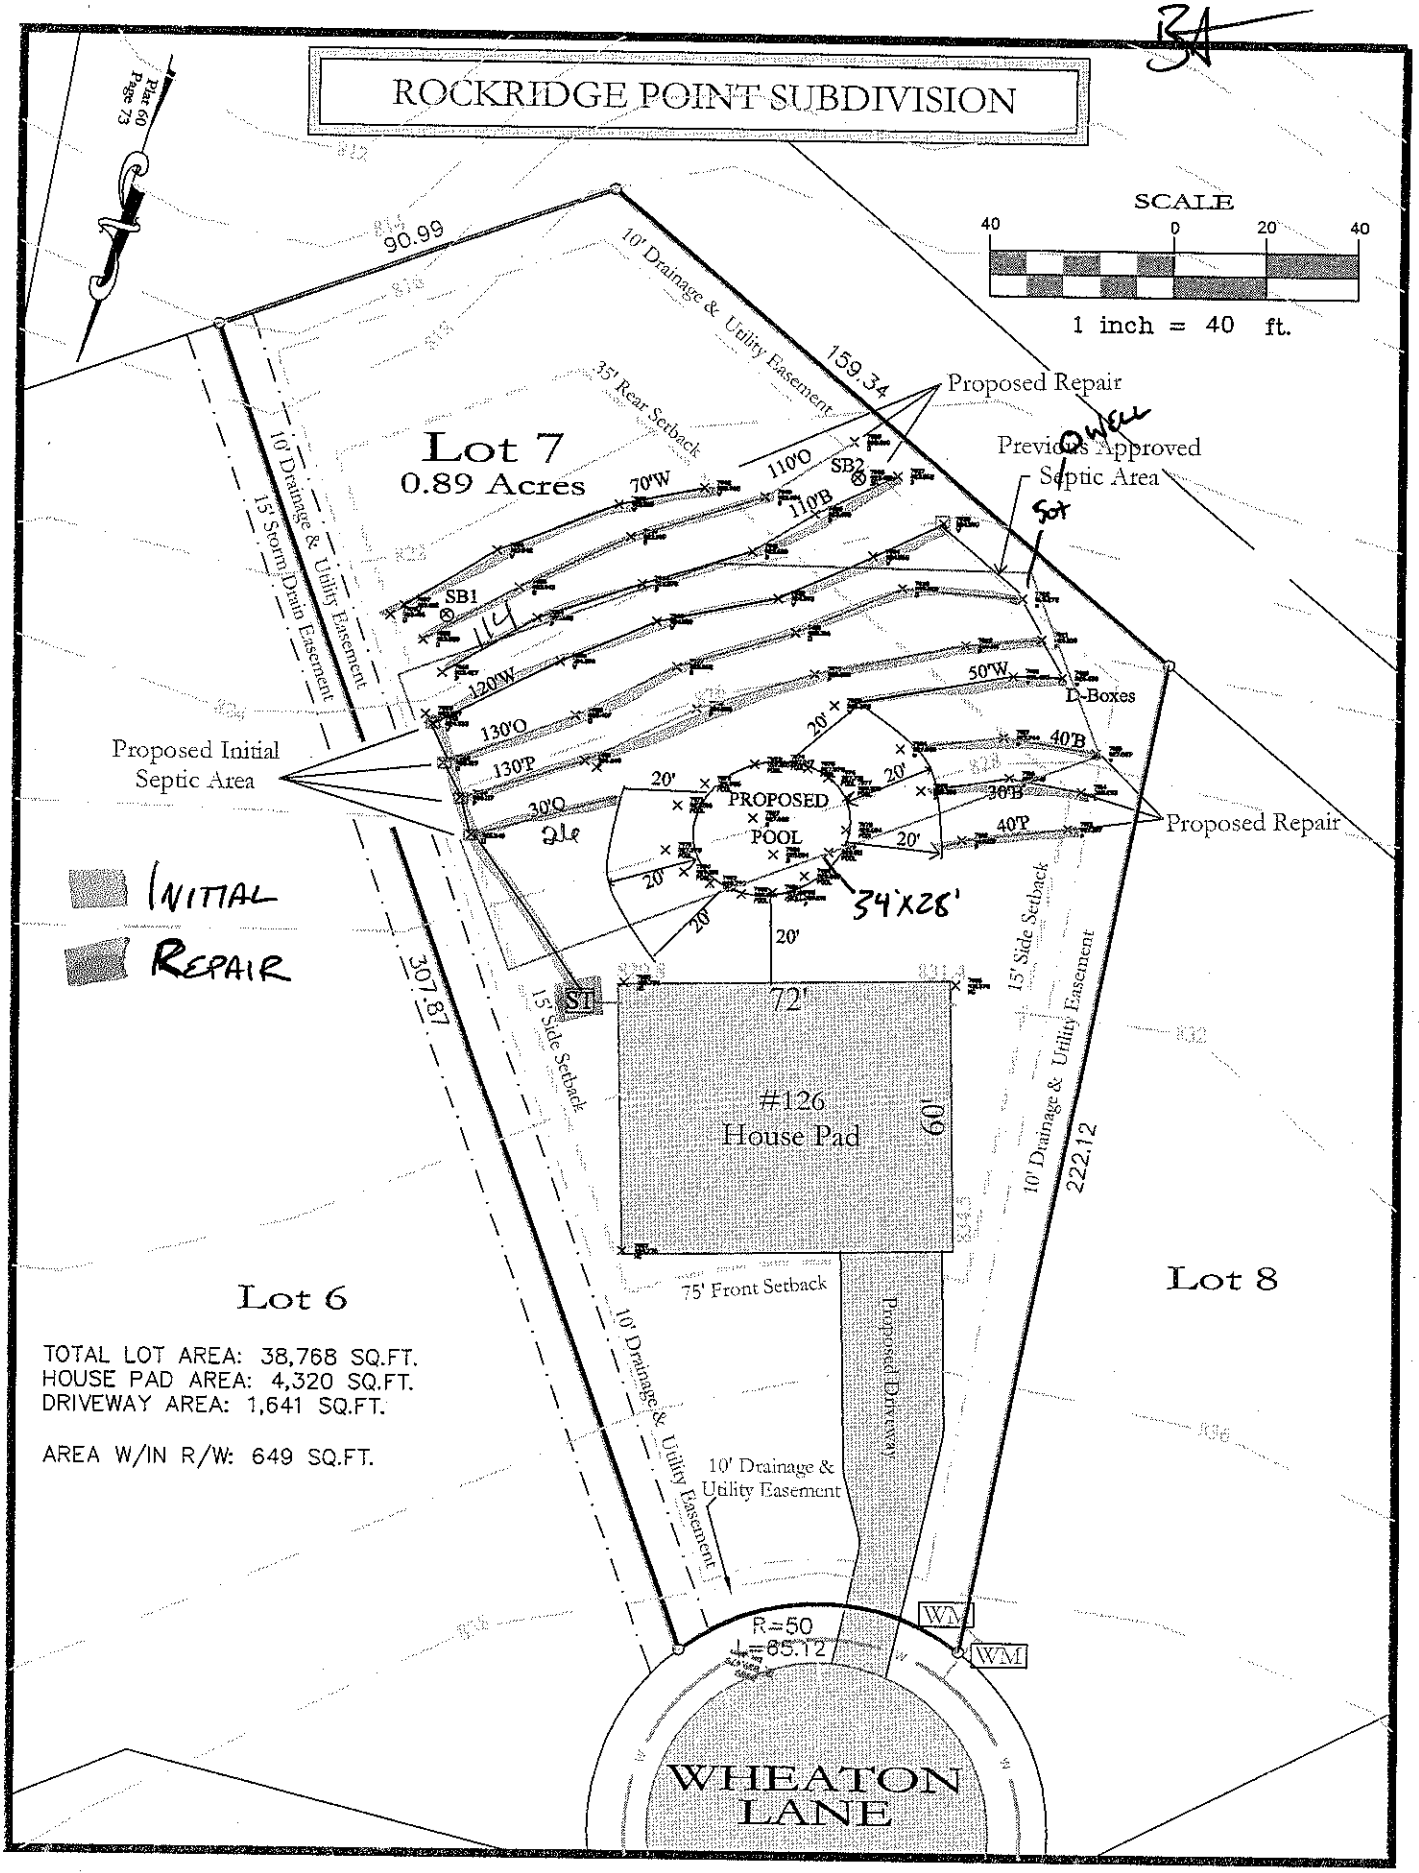

TOTAL LOT AREA: 38,768 SQ.FT.
HOUSE PAD AREA: 4,320 SQ.FT.
DRIVEWAY AREA: 1,641 SQ.FT.

AREA W/IN R/W: 649 SQ.FT.