IREDELL COUNTY HEALTH DEPARTMENT

Authorization to Construct 4636229456

STATESVILLE 704-878-5305 MOORESVILLE 704-664-5281

IMPROVEMENT PERMIT / ~~CERTIFICATE OF COMPLETION~~ / OPERATION PERMIT / EXISTING SYSTEM INSPECTION

PROPERTY DESCRIPTION NO. 24150 DATE 7/20/96 TAX MAP NO. 26A39 Watershed: [X] Yes [ ] No

OWNER OR CONTRACTOR John Castro PHONE: Business Home 896-9966

ADDRESS 175 S Shooner Rd. Mooresville, NC 28115

LOCATION Side of Pines Rd. / Brawley TL side Pines on (R) then right before Tubyfield Rd.

SUBDIVISION No BLOCK / SECTION LOT LOT AREA 30,000 FT2 SITE CLASS. PS DESIGN FLOW 480 L.T.A.R. .3

Septic Tank: 1500 Gallons; STB 1012 Date 12/23/96
Pump Tank: Gallons; PT Date
Pump Make: Model Serial No.
Nitrification Field: No Fields 2 Square Feet 800/800 Linear Feet 520
No Lines 8 Trench Width 36" Max Trench Bottom Depth 36" Gravel Depth 12"

[X] New System [ ] Repair System Type: I, II, III, IV, V, VI
System Description: FLOW-DIVIDER-2D/B
Repair System Description: PRESSURE PANEL
Maintenance Agreement Required: [ ] Yes [X] No


[ ] House/Mod. Home No. Bedrooms
[ ] Mobile Home No. Bathrooms
[ ] Business No. Employees
[X] Other 2 - 2BD APTS.
[X] Slab [ ] Crawl Space [ ] Basement w/plumbing [ ] Basement wo/plumbing

Water Supply: [X] Individual [ ] Community [ ] Public


Comments: FLOW DIVIDER & S/T SET AS SHOWN
2D/B REQUIRED

Comments: As Built OTHER PERMIT

INITIAL SITE SKETCH

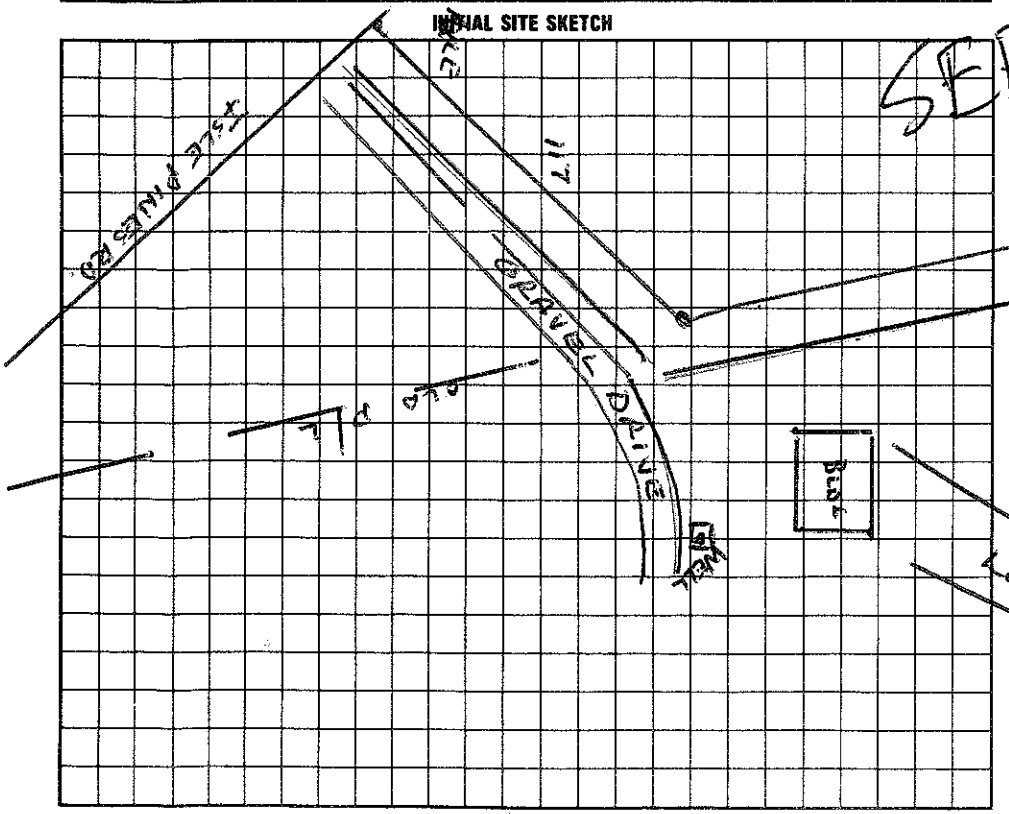

AS BUILT SKETCH

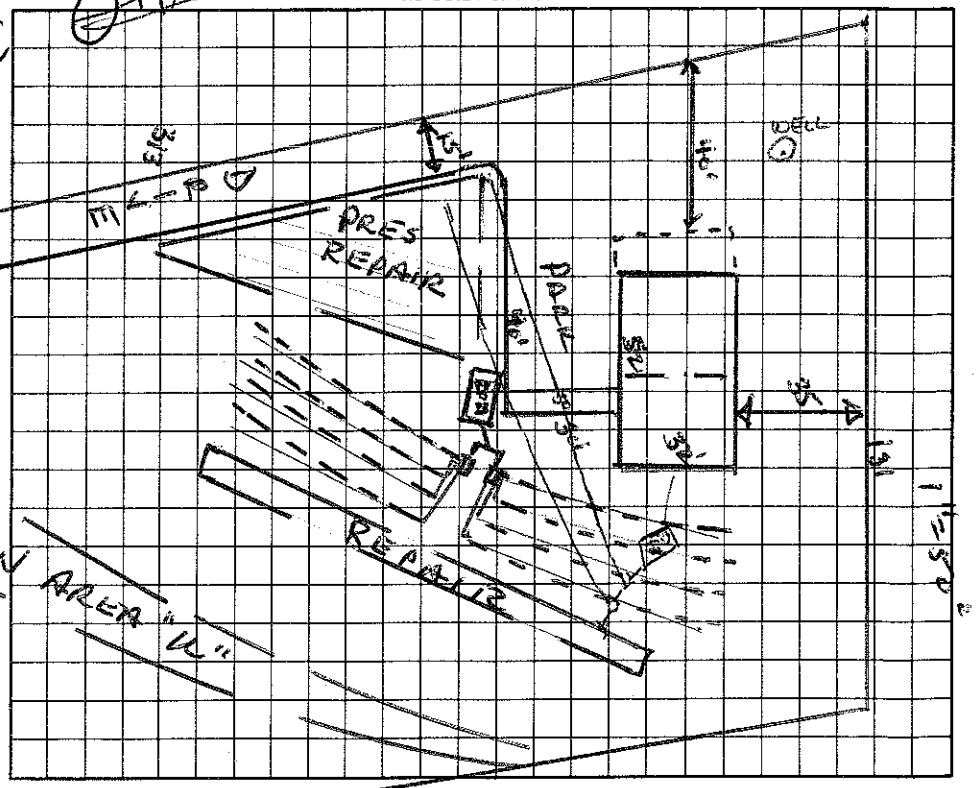

I understand that this permit can be suspended or revoked if any false information is supplied toward securing the permit/any unauthorized changes are made to the site/any unauthorized changes are made in the installation of the system.

Auth. Construction valid 60 months.

Signed: [X]

Improvement Permit by: Wesley Sparks R.S. date 7/20/96

Existing System Inspection by: Wesley Sparks R.S. date 7/20/96

Installed by: BARRY THOMPSON

Certificate of Completion by: date

Operation Permit by: C. [signature] date 3/25/97

HEALTH DEPT. COPY: WHITE INSPECTION COPY (FINAL): GREEN OWNER COPY (FINAL): YELLOW INSPECTION COPY (INITIAL): PINK OWNER COPY (INITIAL): GOLD