IREDELL COUNTY HEALTH DEPARTMENT

Statesville Office (704) 878-5305 Mooresville Office (704) 660-3625 PERMIT # 220963

IMPROVEMENT PERMIT / AUTHORIZATION TO CONSTRUCT / OPERATION PERMIT / EXISTING SYSTEM

PIN # 4636-23-0265

APPLICANT: Kevin + Lauren Beall APPLICANT ADDRESS: 122 Rockridge Point Dr. Mooresville, NC

SITE ADDRESS: 122 Rockridge Point Drive Mooresville, NC PHONE: 410-978-7829 ALT. PHONE:


SITE DIRECTIONS: BSR towards Lake Norman → L on Isle of Pines Rd → R on Rockridge Point Dr. → Lot on Right (w/House)

SUBDIVISION: Rockridge Point SECTION: LOT # 42 LOT AREA: 0.69 acres +SFE DESIGN FLOW: 480 GPD L.T.A.R.: 0.25

Septic Tank 1500 Ex (gal)	STB 338	Date 3/12/13	☒ New System ☐ Repair ☐ Expansion System Type: I II III (IV) V VI	☒ Residence	No. Bedrooms 4	Water Supply
Pump Tank 1500 Ex (gal)	PT 477	Date 3/11/13	System Description: LP-PPBPS (+1 new line)	☐ Business	No. Persons 8	☐ Private
Pump Make Ex	Model Ex	Serial # Ex	Repair System Description: offsite - LP PPBPS	☐ Other	No. Employees	☐ Public
# Nitrification Fields 1	# Lines 7 (1 new)	Linear Ft: 55' (320 LF)	Maintenance Agreement Required: ☒ YES ☐ NO	☒ Slab	☐ Crawl Space	☒ Community
Trench Width 24"	Max. Trench Bottom Depth 36"	Gravel Depth —	☐ GRAVITY ☒ PRESSURE	☐ Basement w/plumbing		☐ Basement w/o plumbing

Comments / Conditions: Follow all N.C. septic rules. Original system installed 5-17-2013. Ensure lines are equally balanced + not receiving more than 200 gallons / dose.

INITIAL SITE SKETCH

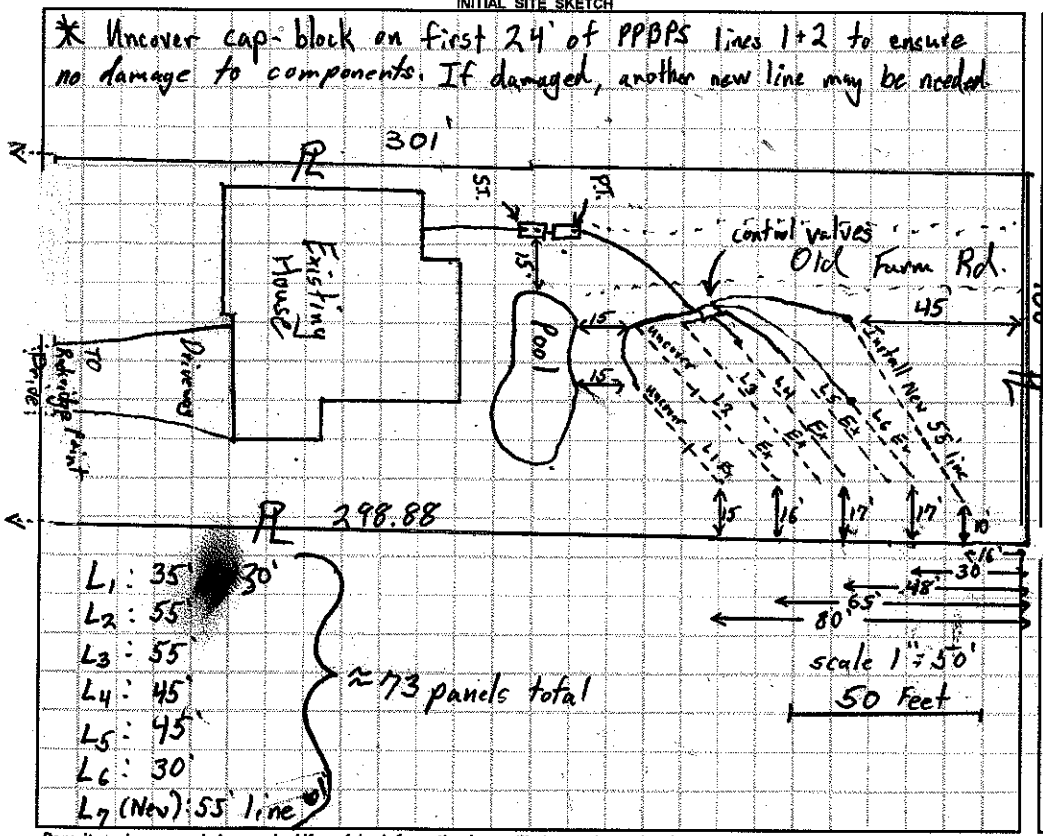

AS BUILT SKETCH

Permit can be suspended or revoked if any false information is supplied toward securing the permit / any unauthorized changes are made to the site / any unauthorized changes are made in the installation of the system. **CONTACT A LOCATOR SERVICE PRIOR TO ANY EXCAVATION**

☐ **IMPROVEMENT PERMIT** *with plat valid without expiration.* ☒ **IMPROVEMENT PERMIT** *with site plan valid for 60 mos.* ☒ **AUTHORIZATION TO CONSTRUCT** *valid for period equal to IMPROVEMENT PERMIT--not to exceed 60 mo.*

Owner / Applicant Signature: [signature] Date: 10-26-16 Installed by: WATER MGMT

IMPROVEMENT PERMIT by: Tom Shuck Date: 10-25-16 OPERATION PERMIT by: [signature] Date: 11-14-16

AUTHORIZATION TO CONSTRUCT by: Tom Shuck Date: 10-25-16 Existing System Inspected by: Date:

Health Dept. Copy - WHITE Applicant (Final Approval) - YELLOW Applicant (Conditional Approval) - PINK