RECEIVED OCT 18 2016

IREDELL COUNTY HEALTH DEPARTMENT *ENVIRONMENTAL HEALTH DIVISION* Application for SEPTIC REPAIR PERMIT

Repair Evaluation #220963

(THE ABOVE PERMIT DOCUMENTS WILL BECOME INVALID IF INFORMATION PROVIDED ON THIS APPLICATION IS FALSIFIED OR CHANGED, OR IF THE SITE IS ALTERED. THE IMPROVEMENT PERMIT IS VALID FOR EITHER 60 MONTHS OR WITHOUT EXPIRATION DEPENDING UPON DOCUMENTATION SUBMITTED - APPLICATION WITH SITE PLAN 60 MONTHS, APPLICATION WITH COMPLETE, SCALED PLAT WITHOUT EXPIRATION. SEE 15A NCAC 18A .1937(f) FOR DETAILS)

Paid $1200.00 10-26-16

1. APPLICATION FOR: ___Improvement Permit X REPAIR Authorization To Construct ___BOTH ___Existing System Inspection

2. Page 2: *Site Plan Worksheet* Form MUST Accompany This Application
The following optional attachments may also be submitted: ___Survey Plat, Scaled no more than 1 Inch = 60 Feet
Place check ( ) beside whichever is submitted if applicable ___Custom Site Plan, Scaled no more than 1 Inch = 60 Feet

3. Applicant Information:

Applicant Name	Mailing Address	Home Phone #	Alternate Phone #
Kevin & Lauren Beall	122 Rockridge Point Dr., Mooresville		410-978-7829
Owner Name	Mailing Address	Home Phone #	Alternate Phone #

4. Property Information:

122 Rockridge Point Dr, Mooresville — Street Address; Rockridge Point — Subdivision Name; 42 — Section/Phase and Lot Number

Driving Directions: Brawley School Rd. Ⓛ Isle of Pines. Ⓡ Rockridge Point Dr. 122 on Ⓡ.

5. RESIDENTIAL Site Development Information: *(Check or Complete ALL that apply)*

( ) New, Single Family Residence
( ) New, Multi-Family Residence
( ) Expansion of Existing Septic System
(X) Repair To Failing Septic System due to Damage from pool excavation
( ) Other

Maximum Number of Bedrooms 4
Maximum Number of Occupants ___
If Expansion, Current Number of Bedrooms ___

( ) Crawl Space Foundation?
(X) Concrete Slab Foundation?
( ) Basement w/Plumbing?
( ) Basement w/out Plumbing?

IF Non-Residential Site Development: Type of Business ___
Square Footage of Building ___
Maximum Number of Employees ___
Maximum Number of Seats ___

6. Proposed Water Supply:

( ) New Well ( ) Existing Well (X) EXISTING Community Well ( ) City Water ( ) Other Public Water

7. Desired Septic System Type: *(You may rank in order of preference, if any)* (✓) EXISTING SYSTEM installed 2013 *Year*

( ) Alternative ( ) Conventional ( ) Innovative ( ) Modified Conventional (X) Other LPP PPBPS

I have read this application and certify that the information provided herein is true, complete, and correct. Authorized county and state officials are granted right of entry to conduct necessary inspections to determine compliance with applicable laws and rules. I understand that I am solely responsible for the proper identification and labeling of all property lines and corners and making the site accessible so that a complete site evaluation can be performed.

9. Signature: Sidney L. Haskins Jr. — Property owner or owner's legal representative signature (SIGNATURE REQUIRED)

10/17/2016 — DATE

IREDELL COUNTY DEPARTMENT OF ENVIRONMENTAL HEALTH

DOCUMENTATION TO AUTHORIZE AN OWNER'S LEGAL REPRESENTATIVE

Applications for permits require the "signature of the owner or owner's legal representative" (15A NCAC 18A .1937). If the owner does not sign the application himself or herself, they can submit any one of the following documents to designate their legal representative:

Power of Attorney; Real Estate Contract; Estate executor; Bankruptcy trustee; Court ordered guardianship

In the absence of the above documentation, the property owner may provide the local health department with documentation that designates a legal representative. A property owner may:
Complete this form to document his or her legal representative, or provide his or her own form that contains the information in this form.
If there are multiple property owners, then all property owners must sign the form that designates a legal representative.

By signing a form that designates a legal representative for purposes of 15A NCAC 18A .1937, the property owner authorizes that representative to act on their behalf in matters pertaining to the application and permitting process, including signing or receiving any application, document or permit. The owner retains full responsibility to meet all permit conditions specified by the local health department.

I, Lauren Beall / Kevin Beall, am the legal owner(s) of the property located at 122 Rockridge Point Drive, Mooresville, identified as PIN (Parcel Identification Number) 4626230265, located in Iredell County, North Carolina.

I do hereby authorize (**print legal representative/company name**) Sid Gaskins Water Management, to act as an agent on my behalf in applying for/signing/obtaining any of the documents described below.

- Application for Improvement Permit (IP) / Authorization to Construct (AC)
- Improvement Permit (IP) / Authorization to Construct (AC)
- Application for soil-site evaluation (new/repair)
- Application/permit for private drinking water well/well abandonment
- Application for Compliance Inspection

I agree to abide by all decisions and/or conditions between the legal representative acting on my behalf and the Iredell County Department of Public Health, Environmental Health Division.

Lauren A. Beall	9/29/16	Carol Hobelmann	9/29/16
Signature of Owner(s)	Date	Signature of Witness	Date

Please return this signed form to the appropriate office:

Mooresville - Environmental Health
ronda.hart@co.iredell.nc.us
Fax: 704-662-3239
610 E. Center Avenue, Mooresville, NC 28115

Statesville - Environmental Health
adrienne.shea@co.iredell.nc.us
Fax: 704-871-3483
349 N. Center Street, Statesville, NC 28677

2.00 4636230265 2019819 4.38

IREDELL COUNTY HEALTH DEPARTMENT

STATESVILLE 704-878-5305 MOORESVILLE 704-664-5281

IMPROVEMENT PERMIT / AUTHORIZATION TO CONSTRUCT / OPERATION PERMIT / EXISTING SYSTEM INSPECTION

PERMIT# 133714 PIN# 4636 23 3131.042 ~~4636230265~~ DATE March 24, 06

OWNER OR APPLICANT Vigent Enterprises PHONE: Business 704 309 0123 Home

ADDRESS 2125 Sparrow Ave Charlotte N.C. 28211

LOCATION Mowley Sch Rd. TR Isle of Pines TR Rocky Farm Rd. 4th lot on Right

SUBDIVISION Rocky Ridge PT BLOCK / SECTION LOT 42/42A LOT AREA 1.69 Ac+SFE SITE CLASS. ES DESIGN FLOW 440gpd L.T.A.R. .25 initial (Required) 1/2-25 05 Repair

Septic Tank: X 1500 Gallons: STB 334 Date 3/17/13

Pump Tank: X 1500 Gallons: PT 477 Date 3/11/13

Pump Make: Model Serial No.

Nitrification Field: No Fields 1 Square Feet 640 Linear Feet 320

No Lines 7 Trench Width 24" max 36" Max Trench Bottom Depth 36" Gravel Depth N/A ☐ Gravity ☒ Pressure ☐ Slab ☒ Crawl Space ☐ Basement w/plumbing ☐ Basement wo/plumbing

☒ New System ☐ Repair ☐ Expansion System Type: I II III (IV) V VI

System Description: LPP685

Repair System Description: LPP685 on SFE 42A

Maintenance Agreement Required: ☒ Yes ☐ No

☒ House/Mod. Home No. Bedrooms 4

☐ Mobile Home No. Persons

☐ Business No. Employees

☐ Other

Water Supply: ☐ Individual ☒ Public ☒ Community

Comments/Conditions: * Per Plan Specs.

Share 5# old bumps in initial and repair septic areas.

Comments/Conditions:

5.8

4.11

4.4

4.7

4.2

3.9 5'

- 5/32" hole installed

4/19/13

- LINES CHECKED
- TANKS CHECKED

INSTALLED AS PER PLAN

INITIAL SITE SKETCH

See Plan from State

AS BUILT SKETCH

Permit can be suspended or revoked if any false information is supplied toward securing the permit/any unauthorized changes are made to the site/any unauthorized changes are made in the installation of the system. Improvement Permit with plat valid without expiration ☐ Improvement Permit with site plan valid for sixty months ☒ Authorization to Construct is valid for a period equal to that of Improvement Permit – not to exceed sixty months.

Signed: Robert B. Daniel date 4/11/06

Improvement Permit by: date 3-24-06


Authorization to Construct by: REHS date 4-7-13

Installed by: Chris Stevens

Operation Permit by: C. date 5/17/13

Existing System Inspection by: date

HEALTH DEPT. COPY: WHITE OWNER COPY (FINAL): YELLOW OWNER COPY (INITIAL): PINK

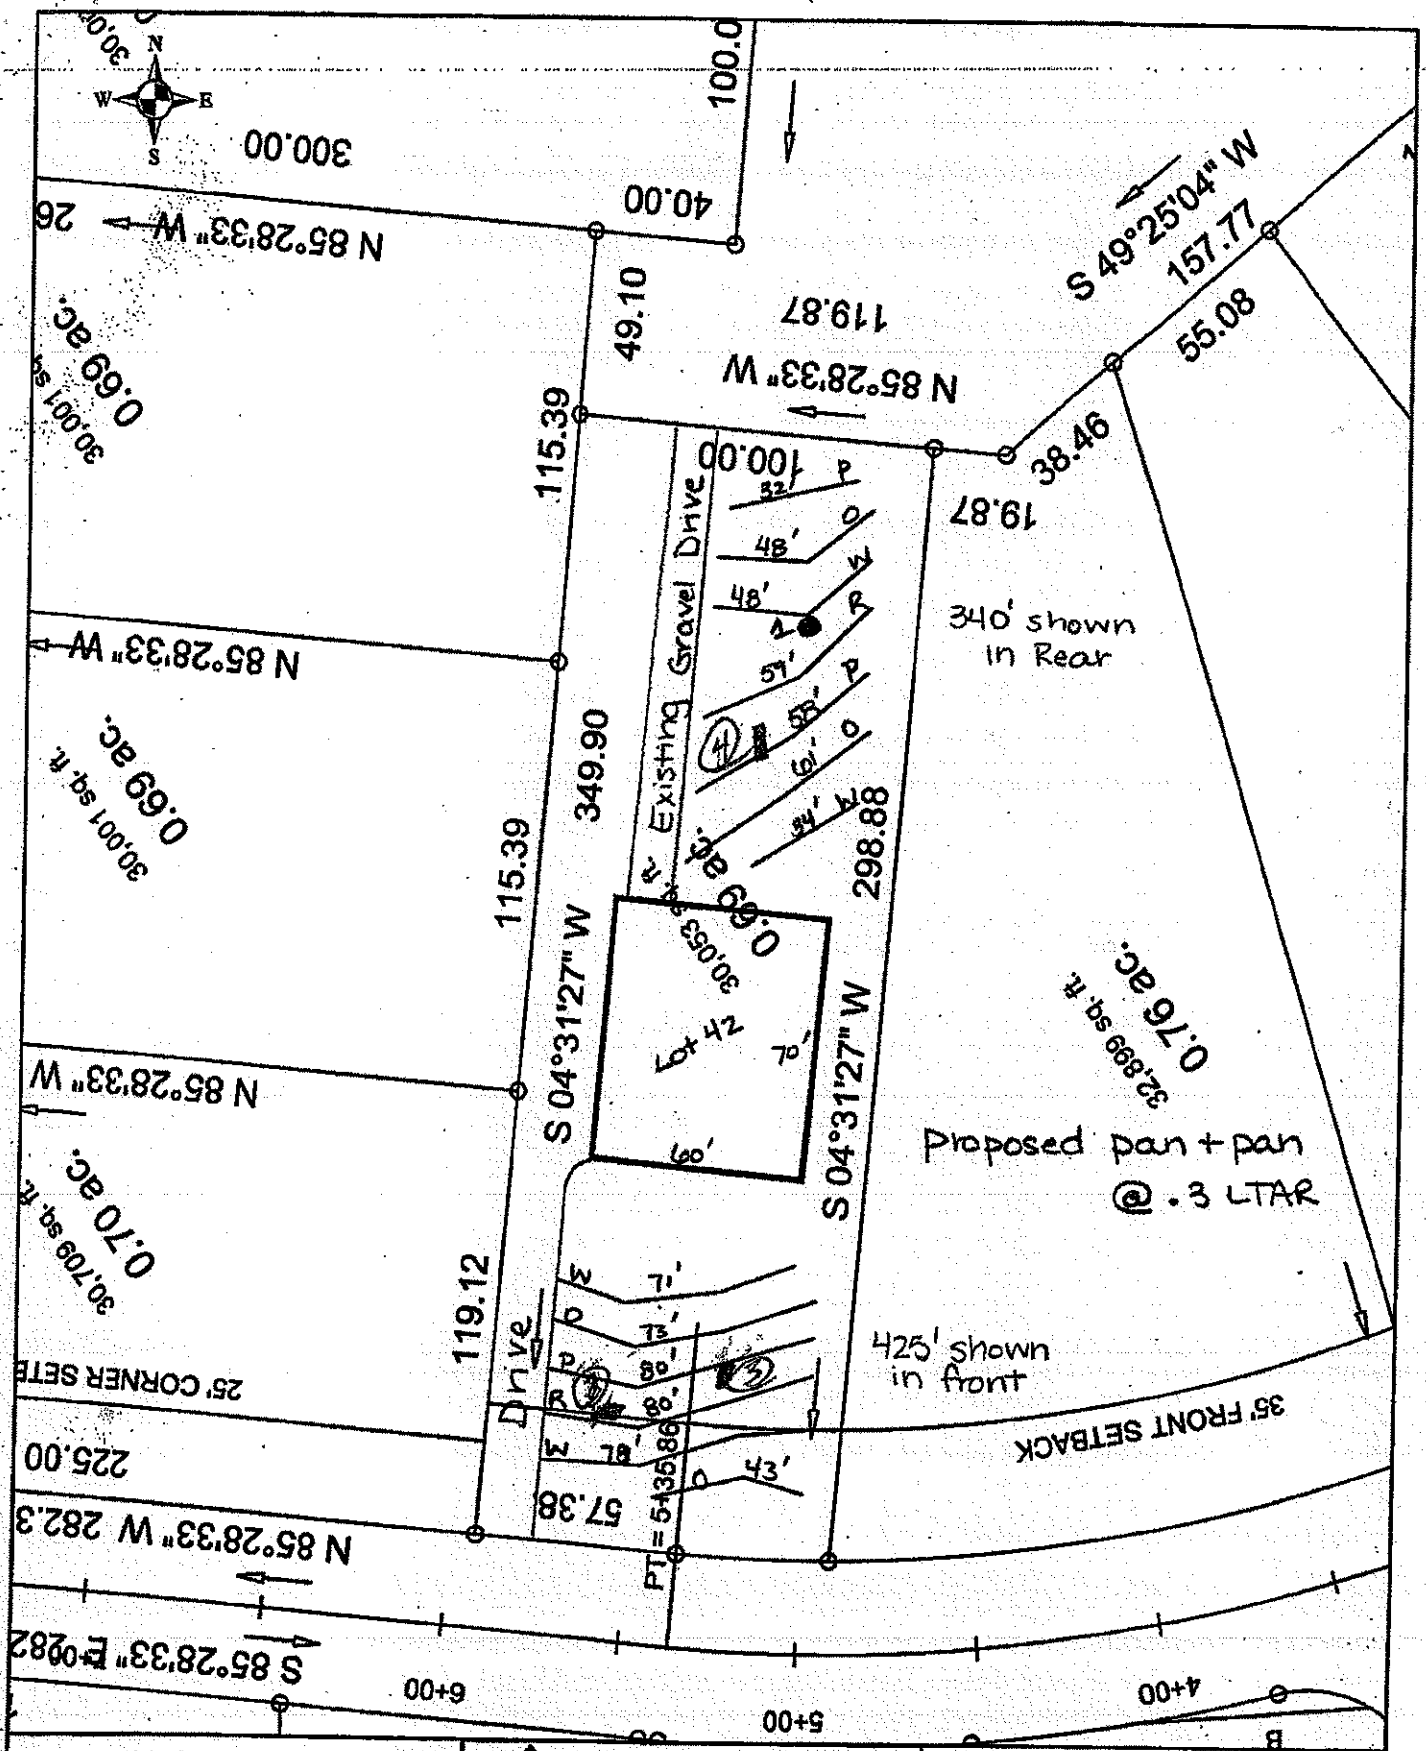

Scale: 1 inch equals 50 feet	S&ME	Rocky Ridge - Lot 42	FIGURE
Drawn by: JBP		Scaled Detailed Site Plan	1
Reviewed by: PGP	ENVIRONMENTAL SERVICES • ENGINEERING • TESTING	Iredell County, NC	
Date: January, 2006		S&ME Project #1588-05-081	