IREDELL COUNTY HEALTH DEPARTMENT

STATESVILLE 704-878-5305 MOORESVILLE 704-664-5281

IMPROVEMENT PERMIT / CERTIFICATE OF COMPLETION / OPERATION PERMIT / EXISTING SYSTEM INSPECTION

PROPERTY DESCRIPTION NO. 17410 DATE Nov. 30, '94 TAX MAP NO. part of 2K B45 Watershed: ☑ Yes ☐ No

OWNER OR CONTRACTOR Bonanza Development Co. PHONE: Business 663-6487 Home

ADDRESS PO Box 1186 Mooresville 4636-23-2888

LOCATION 1100 TR 1113 ~¼-½ mile on left

SUBDIVISION Pollard Pines BLOCK / SECTION A LOT 4A LOT AREA .71 Ac SITE CLASS 15 per 1956 DESIGN FLOW 480 gpd L.T.A.R. .3

Septic Tank: 1500 Gallons; STB TT Pollard Date 3-1-95

Pump Tank: Gallons; PT Date

Pump Make: Model Serial No.

Nitrification Field: No Fields 2 Square Feet 1600 Linear Feet 534+

No Lines 4+4 Trench Width 36" Max Trench Bottom Depth 36" Gravel Depth 12"

☑ New System ☐ Repair System Type: I, ⓘ III, IV, V, VI

System Description: gravity conventional

Repair System Description: off site LPP BPS

Maintenance Agreement Required: ☐ Yes ☑ No waived

☐ House/Mod. Home No. Bedrooms 4

☐ Mobile Home No. Bathrooms 4

☐ Business No. Employees

☑ Other Duplex Apt


☐ Slab ☑ Crawl Space ☐ Basement w/plumbing ☐ Basement wo/plumbing

Water Supply: ☑ Individual ☐ Community ☐ Public

Comments: 267' per subfield, follow contour w/ laterals

Comments: Installed as shown

INITIAL SITE SKETCH

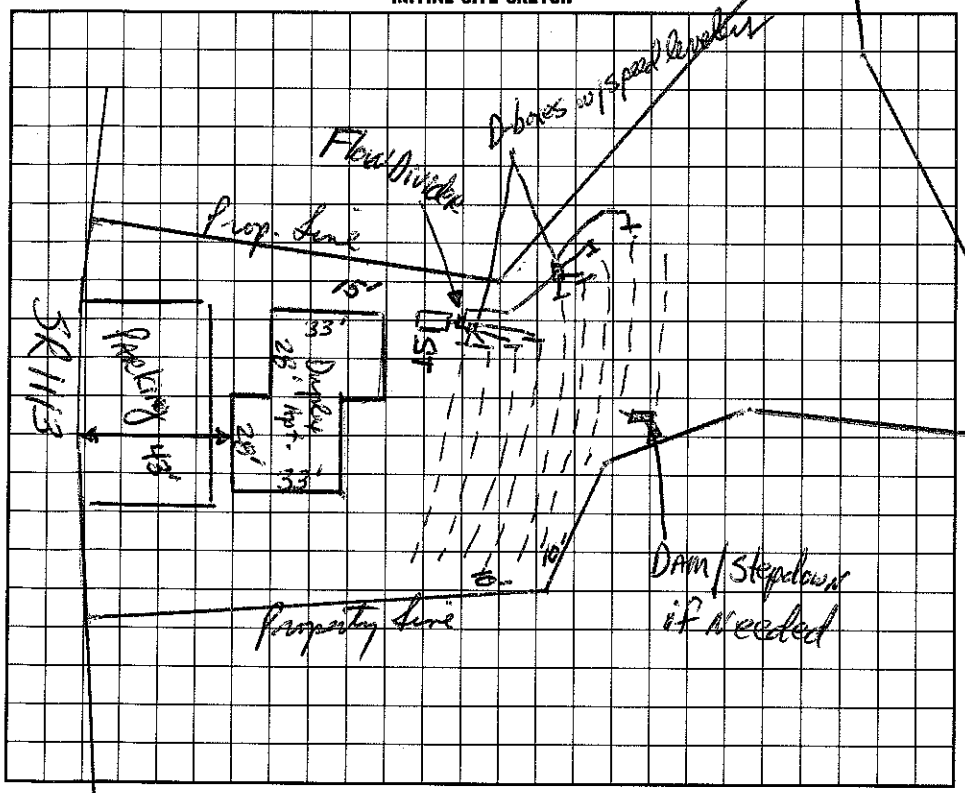

AS BUILT SKETCH

I understand that this permit can be suspended or revoked if any false information is supplied toward securing the permit/any unauthorized changes are made to the site/any unauthorized changes are made in the installation of the system. Improvement Permit is valid for 60 months from date of issuance.

Signed:

Improvement Permit by: Jesse R Hinson, RS date 11/30/94

Existing System Inspection by: date

Installed by:

Certificate of Completion by: J R Hinson, RS date 4/6/95

Operation Permit by: date

HEALTH DEPT. COPY: WHITE INSPECTION COPY (FINAL): GREEN OWNER COPY (FINAL): YELLOW INSPECTION COPY (INITIAL): PINK OWNER COPY (INITIAL): GOLD