IREDELL COUNTY HEALTH DEPARTMENT

STATESVILLE 704-878-5305 MOORESVILLE 704-664-5281

IMPROVEMENT PERMIT / CERTIFICATE OF COMPLETION / OPERATION PERMIT / EXISTING SYSTEM INSPECTION

PROPERTY DESCRIPTION NO. 17414 DATE April 13, 95 TAX MAP NO. part of 2K645 4636234701 Watershed: ☑ Yes ☐ No

OWNER OR CONTRACTOR Bonanza Dev. Co. PHONE: Business ______ Home ______

ADDRESS ______

LOCATION 1100 ... Rd. ~½ mile on left

SUBDIVISION ... BLOCK / SECTION ______ LOT 6 LOT AREA .734 SITE CLASS. ... DESIGN FLOW ... L.T.A.R. .35

Septic Tank: 1500 Gallons; STB ... Date 7-15-95
Pump Tank: 1000 Gallons; PT 27 ... Date 7-16-95
Pump Make: ______ Model ______ Serial No. ______
Nitrification Field: No Fields 1 Square Feet 1050 Linear Feet 350
No Lines 7 Trench Width 36" Max Trench Bottom Depth 30" Gravel Depth NA

☑ New System ☐ Repair System Type: I, II, III, IV, V, VI
System Description: Pumped to ...
Repair System Description: ...
Maintenance Agreement Required: ☐ Yes ☑ No

☐ House/Mod. Home No. Bedrooms 4
☐ Mobile Home No. Bathrooms 4
☐ Business No. Employees ______
☑ Other Duplex Apt

☐ Slab ☑ Crawl Space ☐ Basement w/plumbing ☐ Basement wo/plumbing


Water Supply: ☐ Individual ☑ Community ☐ Public

Comments: SEE ME for Design Specs on pressure manifold.


Comments: Sleeve under driveway ~36" deep — pvc used ...

1"=60'

INITIAL SITE SKETCH

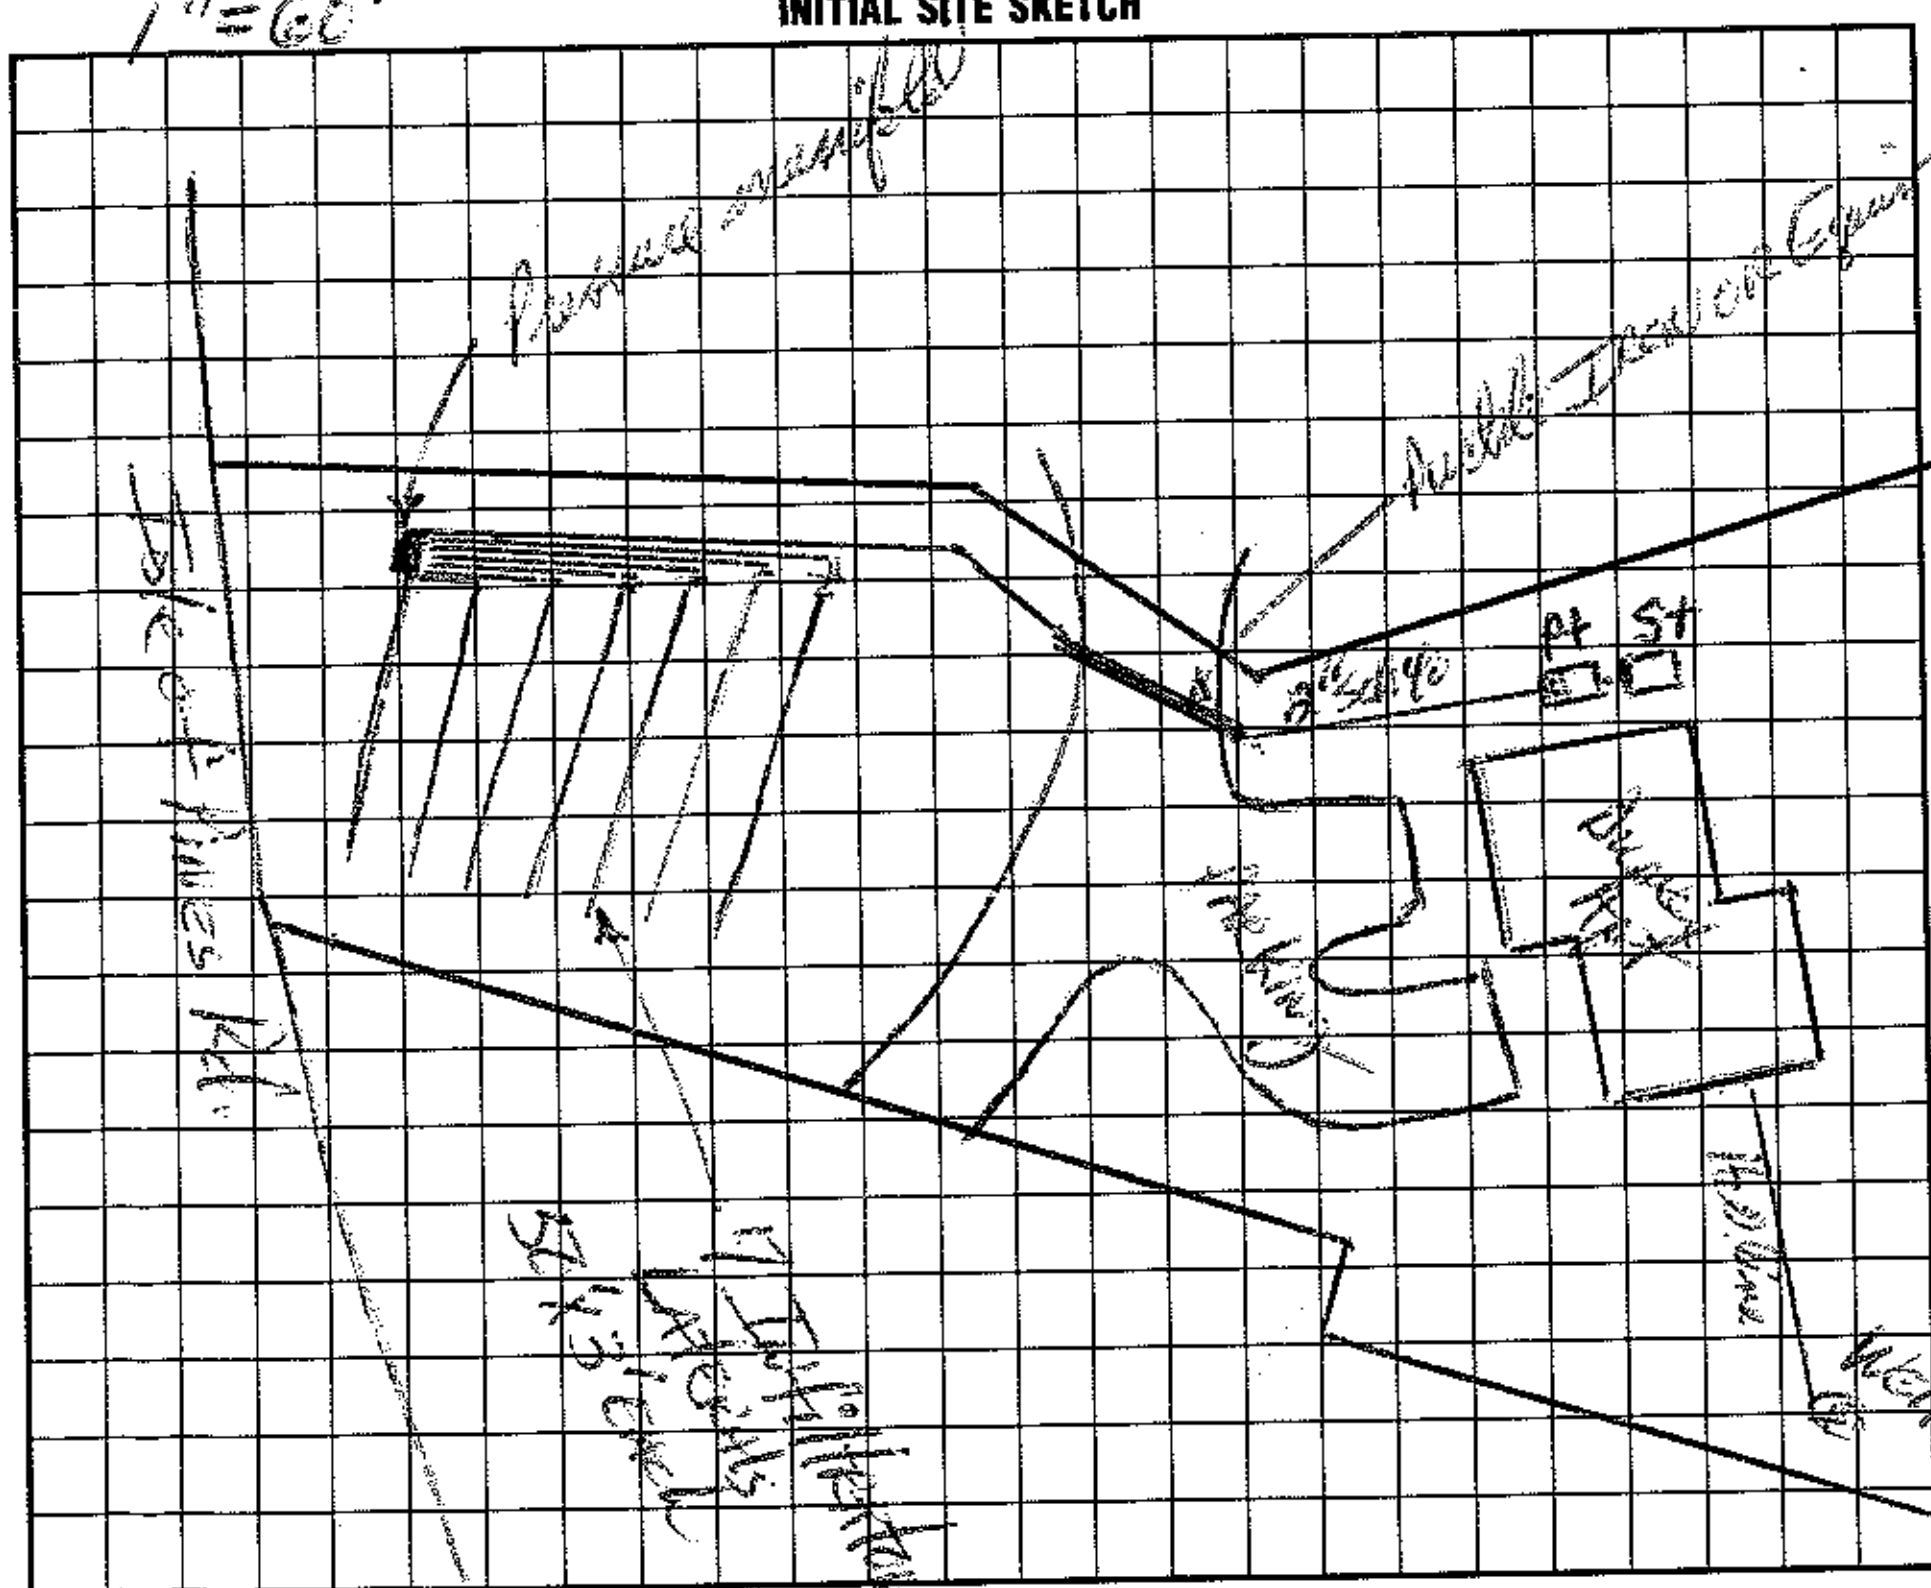

AS BUILT SKETCH

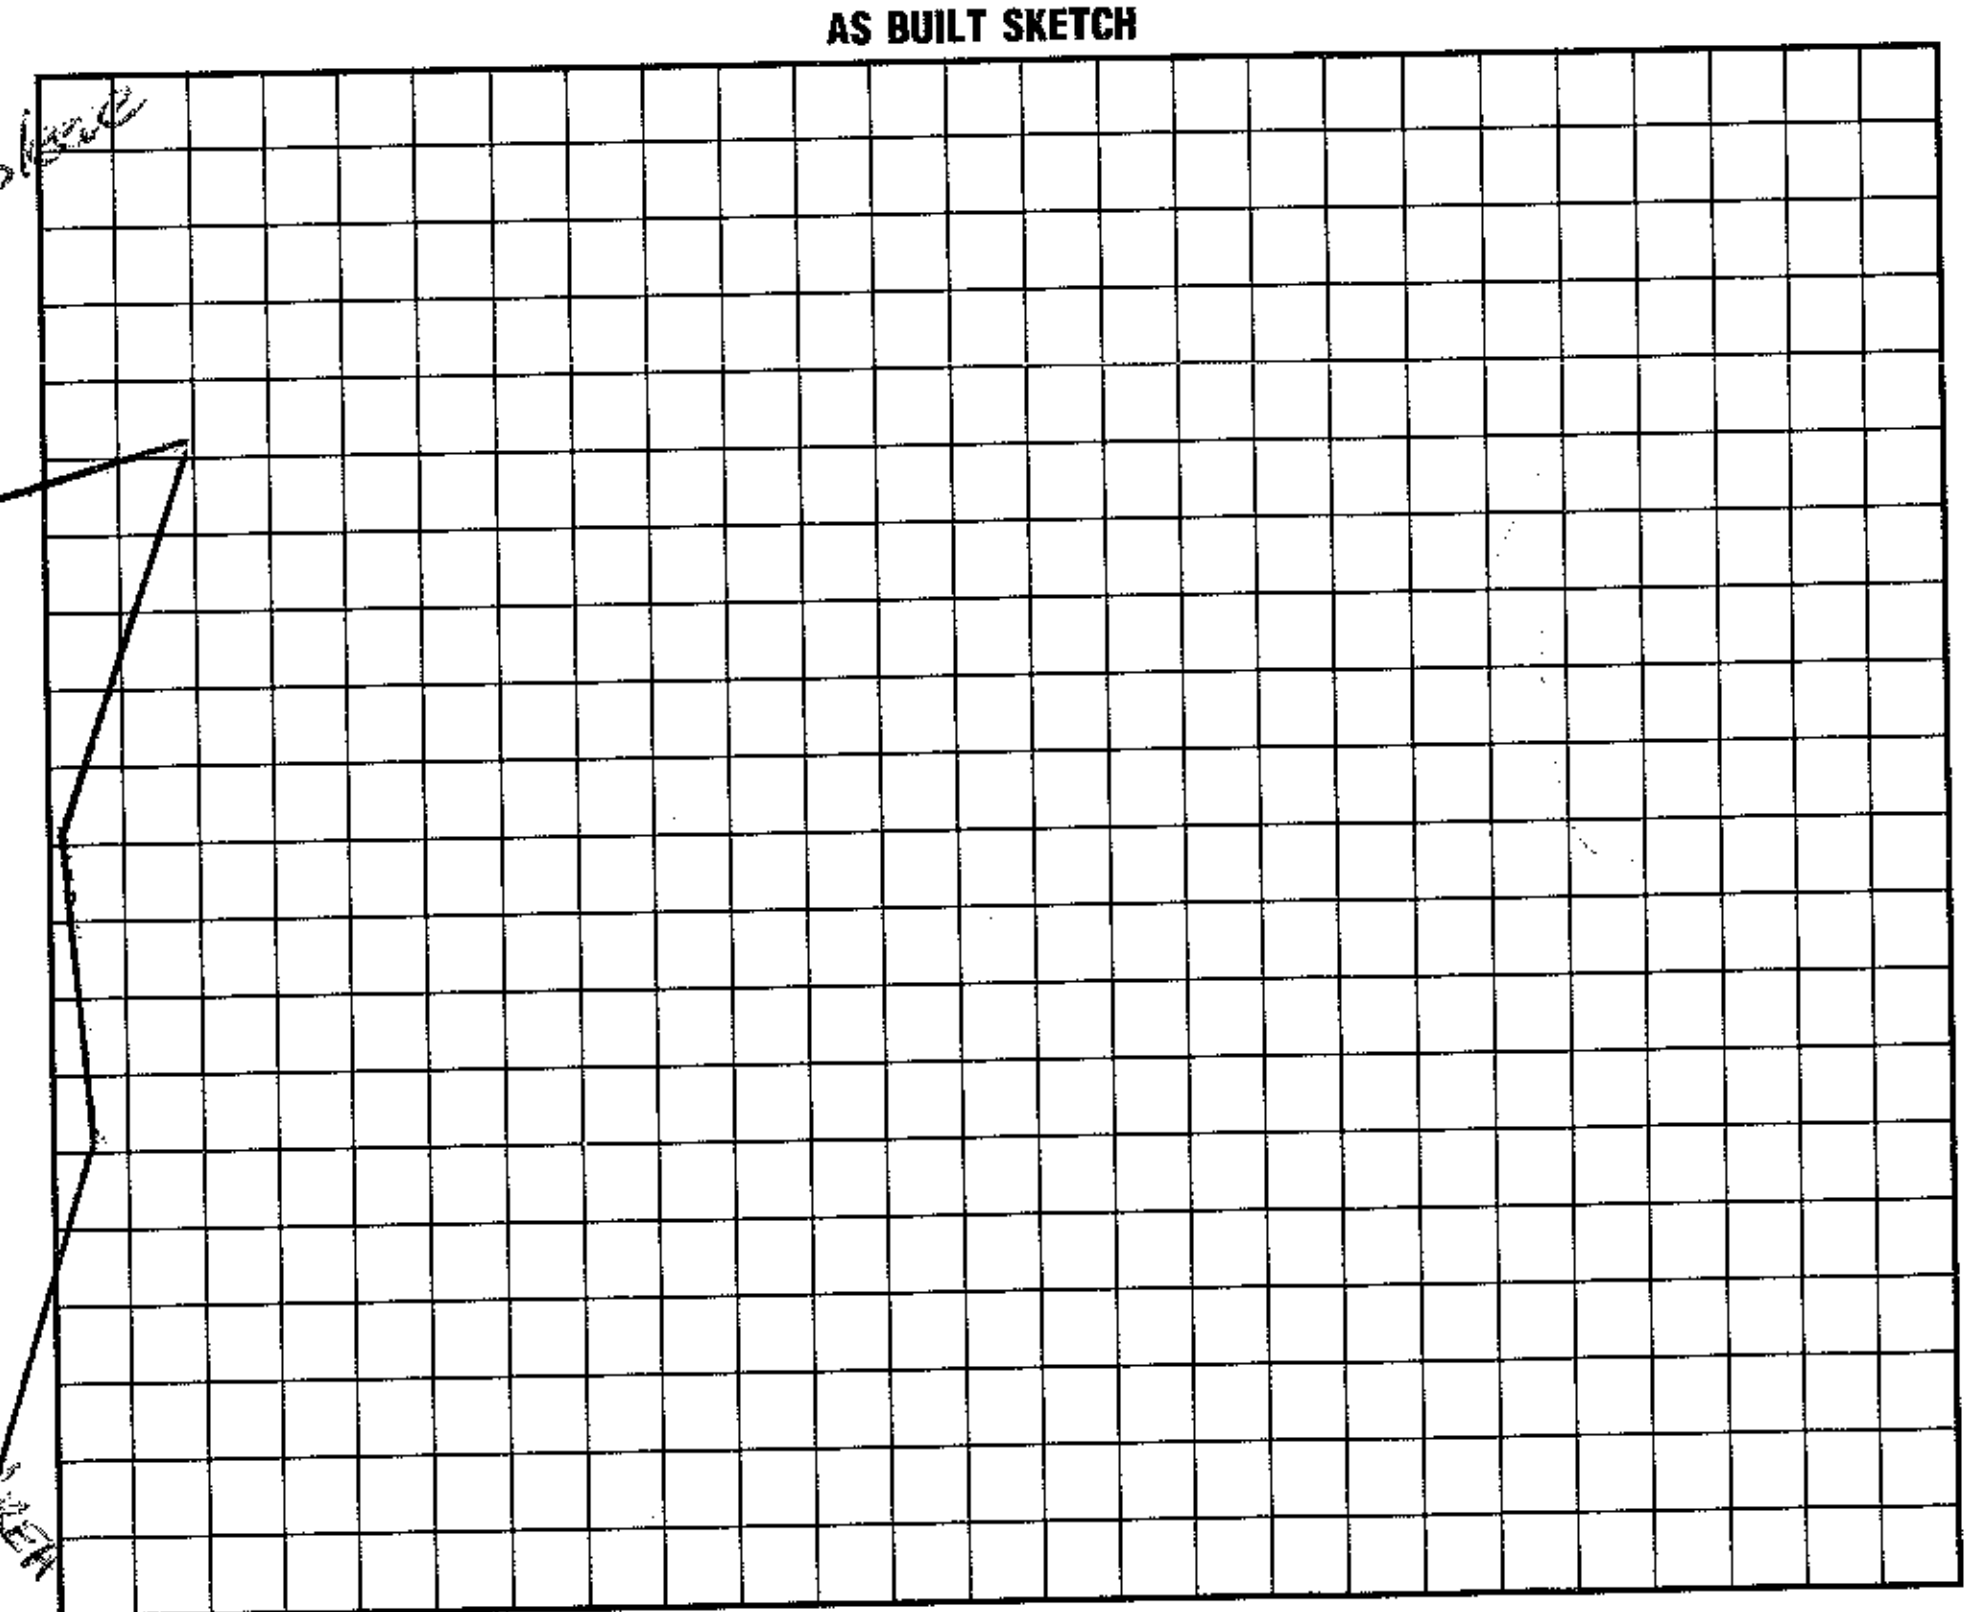

I understand that this permit can be suspended or revoked if any false information is supplied toward securing the permit/any unauthorized changes are made to the site/any unauthorized changes are made in the installation of the system. Improvement Permit is valid for 60 months from date of issuance.

Signed: X Mark ...

Improvement Permit by: ..., RS date 4/13/95

Existing System Inspection by: ______ date ______

Installed by: ...

Certificate of Completion by: ______ date ______

Operation Permit by: ..., RS date 10/23/95

HEALTH DEPT. COPY: WHITE INSPECTION COPY (FINAL): GREEN OWNER COPY (FINAL): YELLOW INSPECTION COPY (INITIAL): PINK OWNER COPY (INITIAL): GOLD