IREDELL COUNTY HEALTH DEPARTMENT

Statesville Office (704) 878-5305 Mooresville Office (704) 660-3625 PERMIT # 208239

IMPROVEMENT PERMIT / AUTHORIZATION TO CONSTRUCT / OPERATION PERMIT / EXISTING SYSTEM

PIN # 4636-23-5003

APPLICANT: TROE HOMES APPLICANT ADDRESS: 2649 BRECKONRIDGE CENTER DR. MONROE

SITE ADDRESS: 111 WHEATON LN. PHONE: 704-238-1229 ALT. PHONE:

SITE DIRECTIONS: BSR, TR ISLE OF PINES, TR INTO ROCK RIDGE POINT

SUBDIVISION: ROCK RIDGE POINT SECTION: LOT # 2 LOT AREA: .69 AC DESIGN FLOW: 480 L.T.A.R.: .25

Septic Tank 1500 (gal) STB 338 Date 4/14/15
Pump Tank 1500 (gal) PT 477 Date 3/27/15
Pump Make Model Serial #
Nitrification Fields 1 # Lines 5 Linear Ft: 340'
Trench Width 24" Max. Trench Bottom Depth 36" Gravel Depth

☒ New System ☐ Repair ☐ Expansion System Type: I II III IV V VI
System Description: LP PANEL BLOCK
Repair System Description: SAME
Maintenance Agreement Required: ☒ YES ☐ NO
☐ GRAVITY ☒ PRESSURE

☒ Residence No. Bedrooms 4
☐ Business No. Persons
☐ Other No. Employees
☐ Slab ☒ Crawl Space
☐ Basement w/plumbing ☐ Basement w/o plumbing

Water Supply
☐ Private
☐ Public
☒ Community

Comments / Conditions:

INITIAL SITE SKETCH

SEE PLAN FROM SEPTIC ENVIRONMENTAL SOLUTIONS

AS BUILT SKETCH

TANKS OK 5/14/15 JK

CHECKED LINES 5-20-15 BA

CHECKED ELEC. SET 3 PH 5-21-15 BA

GOULDS WATER TECHNOLOGY

PE51M
SUBMERSIBLE PUMP
.5HP 1/60/115 9.5MA

Permit can be suspended or revoked if any false information is supplied toward securing the permit / any unauthorized changes are made to the site / any unauthorized changes are made in the installation of the system. **CONTACT A LOCATOR SERVICE PRIOR TO ANY EXCAVATION**

☐ **IMPROVEMENT PERMIT** *with plat valid without expiration.* ☒ **IMPROVEMENT PERMIT** *with site plan valid for 60 mos.* ☐ **AUTHORIZATION TO CONSTRUCT** *valid for period equal to IMPROVEMENT PERMIT--not to exceed 60 mo.*

Owner / Applicant Signature: Date: 3-16-15

IMPROVEMENT PERMIT by: APPROVED MAR 13 2015 Date:


AUTHORIZATION TO CONSTRUCT by: APPROVED MAR 16 2015 Date:

Installed by: SID GASKINS

OPERATION PERMIT by: APPROVED Date: JUN 03 2015

Existing System Inspected by: Date:

Health Dept. Copy - WHITE Applicant (Final Approval) - YELLOW Applicant (Conditional Approval) - PINK

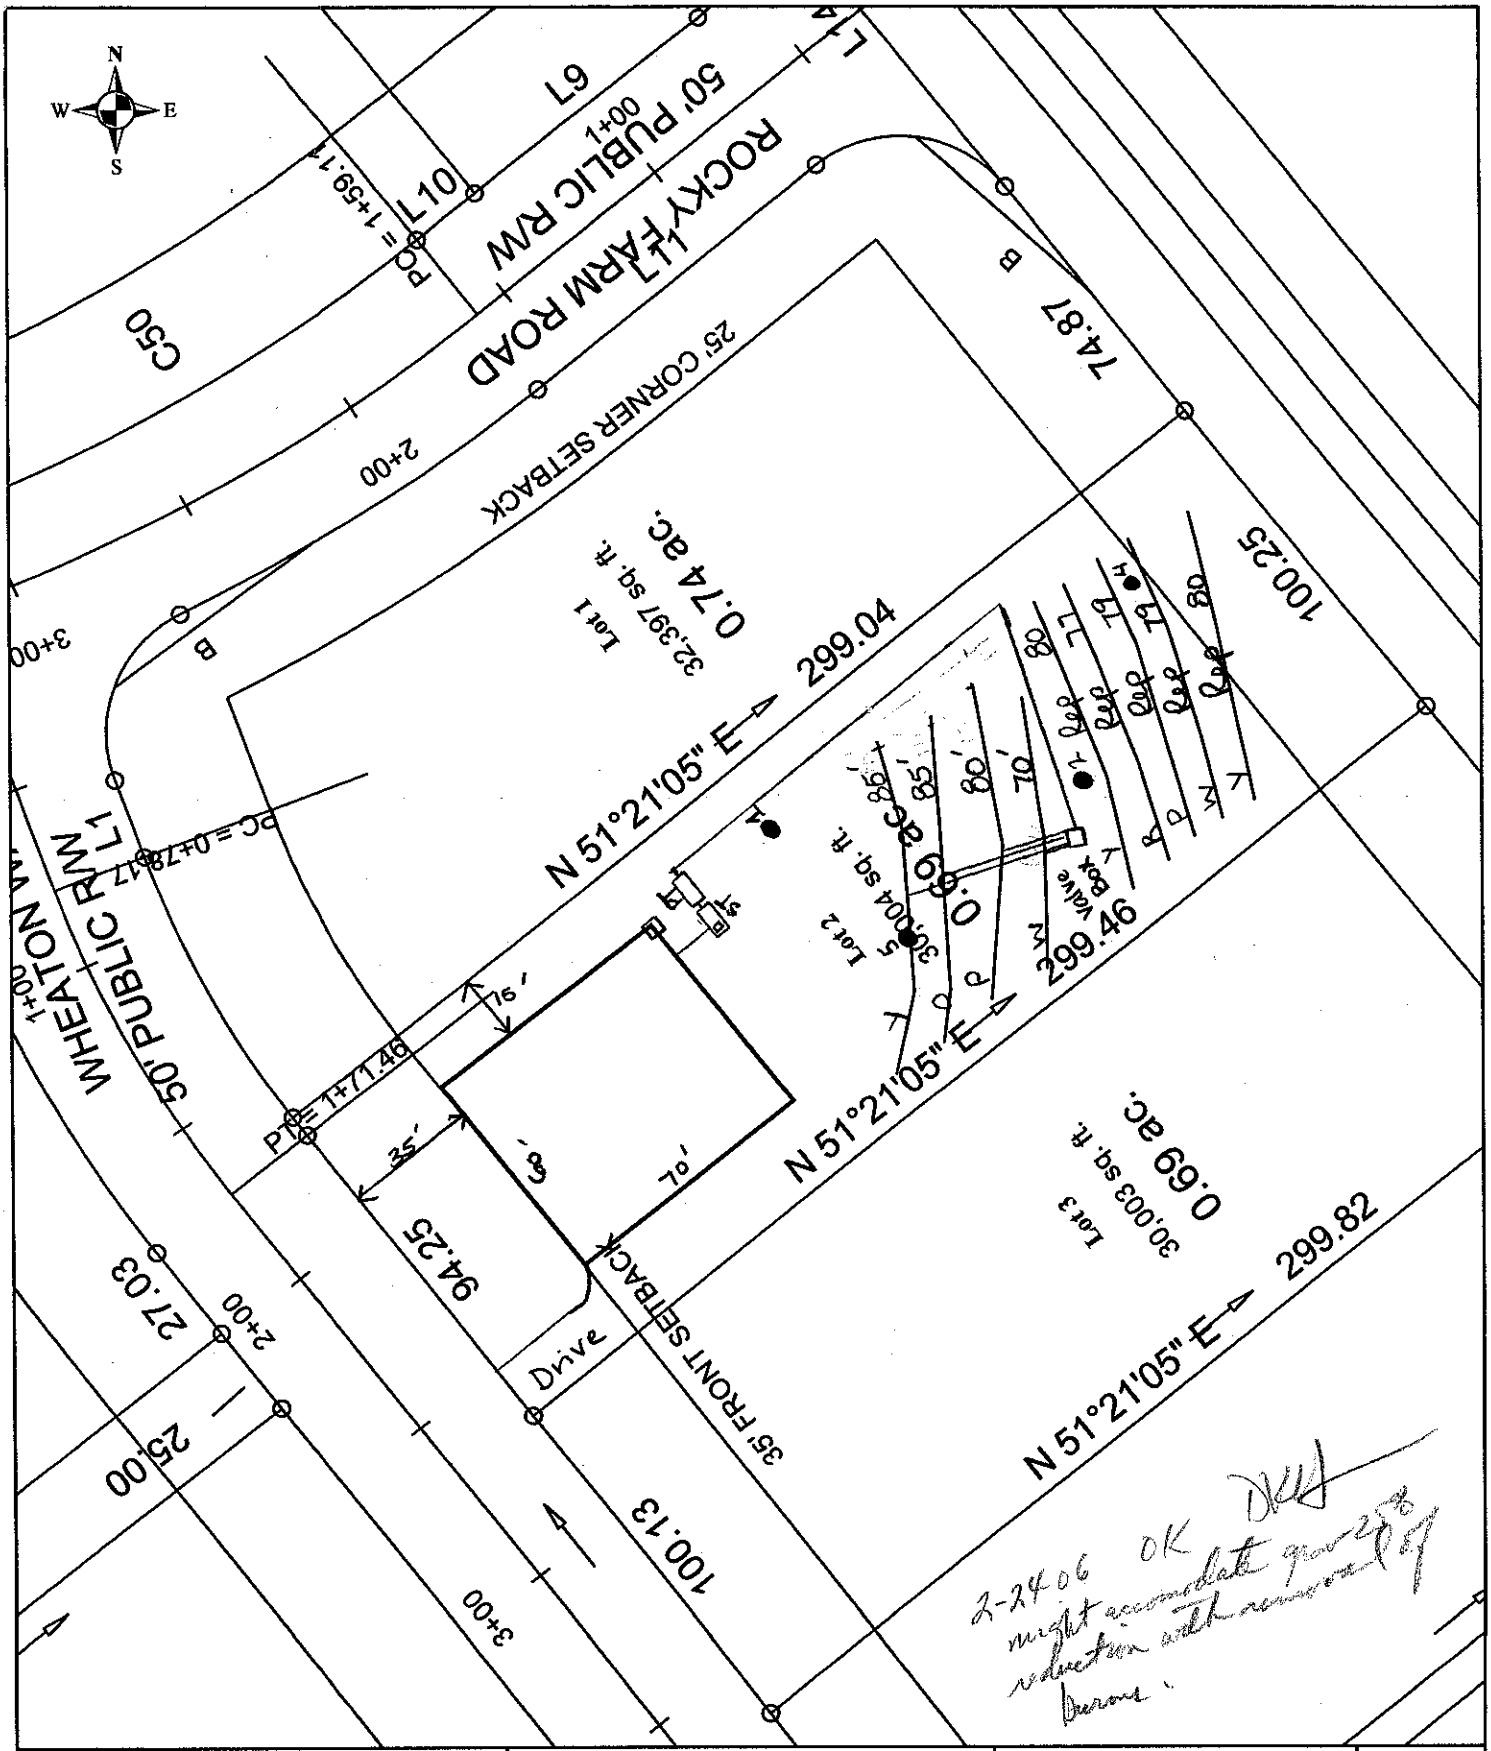

Scale: 1 inch equals 50 feet	S&ME ENVIRONMENTAL SERVICES • ENGINEERING • TESTING	Rocky Ridge - Lot 2	FIGURE
Drawn by: JBP		Scaled, Detailed Site Plan	1
Reviewed by: PGP		Iredell County, NC	
Date: January, 2006		S&ME Project #1588-05-081	