(3rd)

# IREDELL COUNTY HEALTH DEPARTMENT

STATESVILLE 704-878-5305 MOORESVILLE 704-664-5281

## IMPROVEMENT PERMIT / AUTHORIZATION TO CONSTRUCT / OPERATION PERMIT / EXISTING SYSTEM INSPECTION

PERMIT# 124942 PIN# 4636 353208 4636235423 DATE 4-9-07

OWNER OR APPLICANT Bonanza Development Co PHONE: Business _____ Home _____

ADDRESS 816 G Brawley Sch Rd Mooresville NC 28117

LOCATION Brawley Sch Rd, @ Isle of Pines, @ Meadow Creat Ln, @ Vista View, on Left R and

SUBDIVISION Villages @ Isle of Pines BLOCK / SECTION _____ LOT 2 LOT AREA _____ SITE CLASS. PS DESIGN FLOW 360 L.T.A.R. .25

Septic Tank: 1000 Gallons; STB 3 1/2 Date 3/2/07

Pump Tank: _____ Gallons; PT _____ Date _____

Pump Make: _____ Model _____ Serial No. _____

Nitrification Field: No Fields ___ Square Feet 1080 Linear Feet 360'

No Lines 5 (3+2) Trench Width 36" Max Trench Bottom Depth 36" Gravel Depth _____

☒ New System ☐ Repair ☐ Expansion System Type: I (II) III IV V VI

System Description: 25% Reduced

Repair System Description: LP Pump

Maintenance Agreement Required: ☐ Yes ☒ No

☒ Gravity ☐ Pressure ☐ Slab ☒ Crawl Space ☐ Basement w/plumbing ☐ Basement wo/plumbing

☒ House/Mod. Home No. Bedrooms 3

☐ Mobile Home No. Persons ___

☐ Business No. Employees ___

☐ Other _____

Water Supply: ☐ Individual ☒ Public ☒ Community


Comments/Conditions:

#5 lines total - from septic tank go into flow splitter, from splitter into (2) d-boxes; 1 d-box with 3 outlets (180') and 1 d-box for 3 outlets (140')


Pe

Comments/Conditions:

INITIAL SITE SKETCH

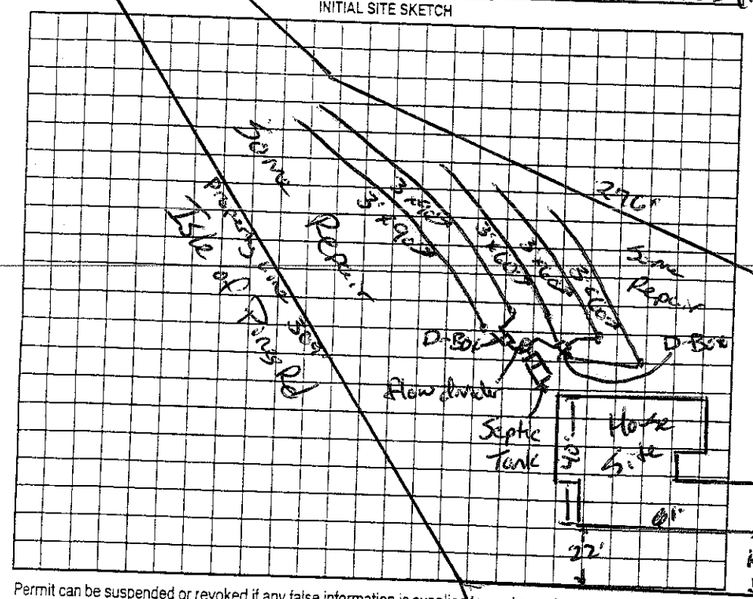


AS BUILT SKETCH

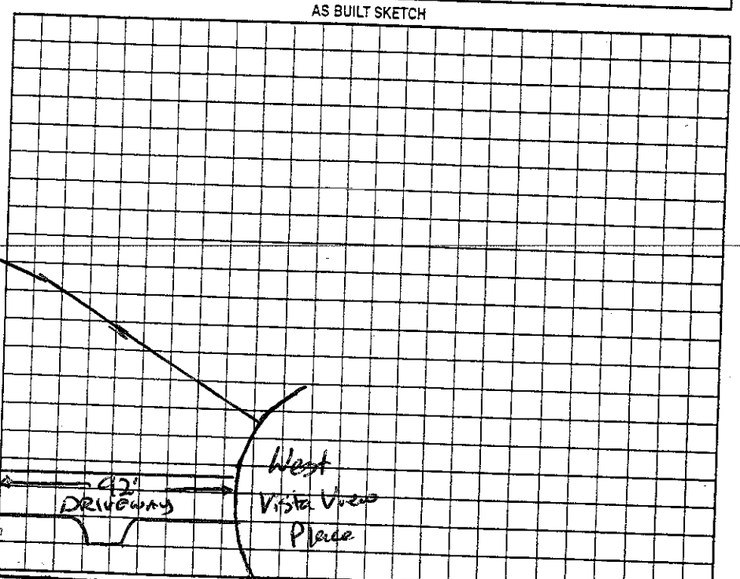


Permit can be suspended or revoked if any false information is supplied toward securing the permit/any unauthorized changes are made to the site/any unauthorized changes are made in the installation of the system. Improvement Permit with plat valid without expiration ☐ Improvement Permit with site plan valid for sixty months ☒ Authorization to Construct is valid for a period equal to that of Improvement Permit – not to exceed sixty months.

Signed: Bonanza Development Co. Inc by Scott R Needham date 4/12/07

Improvement Permit by: Josh E Alred date 4-11-07

Authorization to Construct by: Josh E Alred date 4-11-07

Installed by: F&T Excavation

Operation Permit by: Wesley Sparks RS date 9/25/07

Existing System Inspection by: _____ date _____

HEALTH DEPT. COPY: WHITE OWNER COPY (FINAL): YELLOW OWNER COPY (INITIAL): PINK