IREDELL COUNTY HEALTH DEPARTMENT

Statesville Office (704) 878-5305 BF Mooresville Office (704) 660-3625 4636237189 PERMIT # 1289444

IMPROVEMENT PERMIT / AUTHORIZATION TO CONSTRUCT / OPERATION PERMIT / EXISTING SYSTEM

PIN # 4636353208

APPLICANT: Bonanza Dev. Company APPLICANT ADDRESS: 8166 Brawley School Rd M'ville, NC 28115

SITE ADDRESS: 111 West Vista View Place Mooresville, NC PHONE: 704 363-9942 ALT. PHONE: 704 662-0105

SITE DIRECTIONS: Brawley School Rd TL Isle of Pines TL Meadow Crest Ln TL W. Vista View Property on left


SUBDIVISION: Villages at Isle of Pines SECTION: LOT # 4 LOT AREA: DESIGN FLOW: 360gpd L.T.A.R.: .3

Septic Tank	1000 (gal)	STB	794	Date	1-21-14	[X] New System [ ] Repair [ ] Expansion	System Type: I II (III) IV V VI	[X] Residence	No. Bedrooms 3
Pump Tank	(gal)	PT		Date		System Description:	Gravity-25% Reduction	[ ] Business	No. Persons
Pump Make		Model		Serial #		Repair System Description:	Pump PM-25% Reduction	[ ] Other	No. Employees
# Nitrification Fields	1	# Lines	4	Linear Ft:	300ft	Maintenance Agreement Required:	[ ] YES [X] NO	[ ] Slab	[ ] Crawl Space
Trench Width	36"	Max. Trench Bottom Depth	36"	Gravel Depth	N/A	[X] GRAVITY	[ ] PRESSURE	[ ] Basement w/plumbing	[ ] Basement w/o plumbing


Water Supply: [ ] Private [ ] Public [X] Community

Comments / Conditions: Note: Okay to install Initial Drainfield in 5 lines, if needed. Use Serial Distribution

INITIAL SITE SKETCH

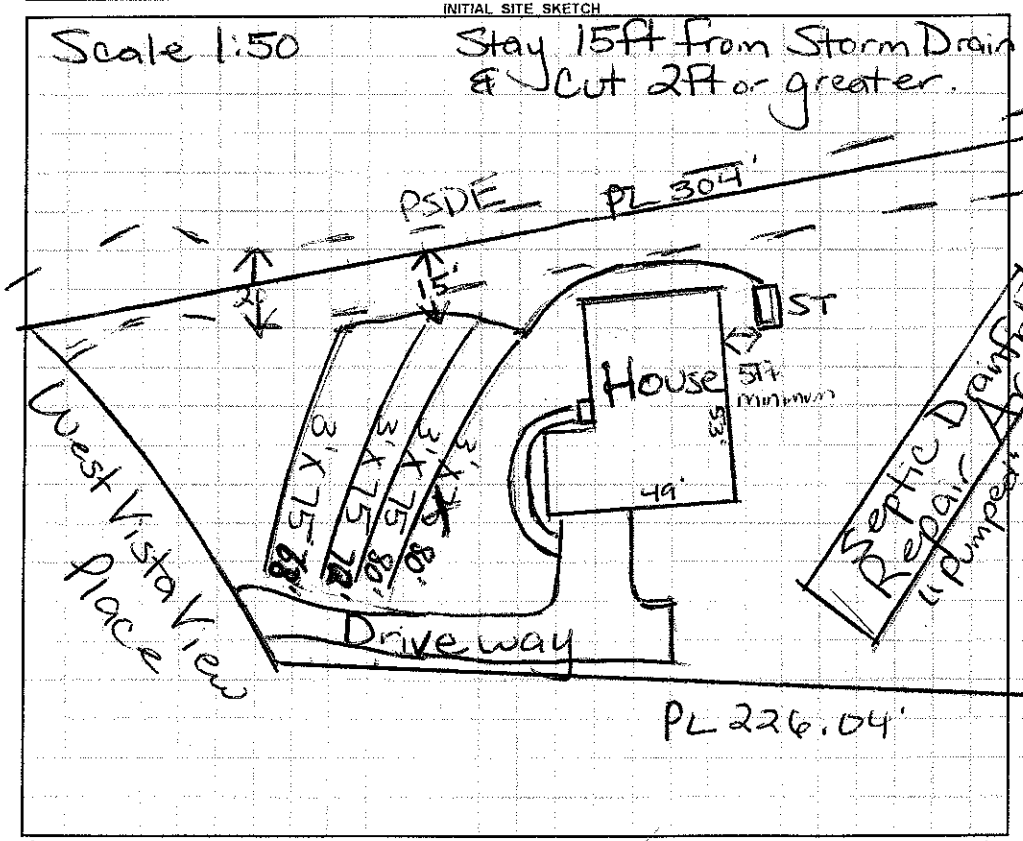

AS BUILT SKETCH

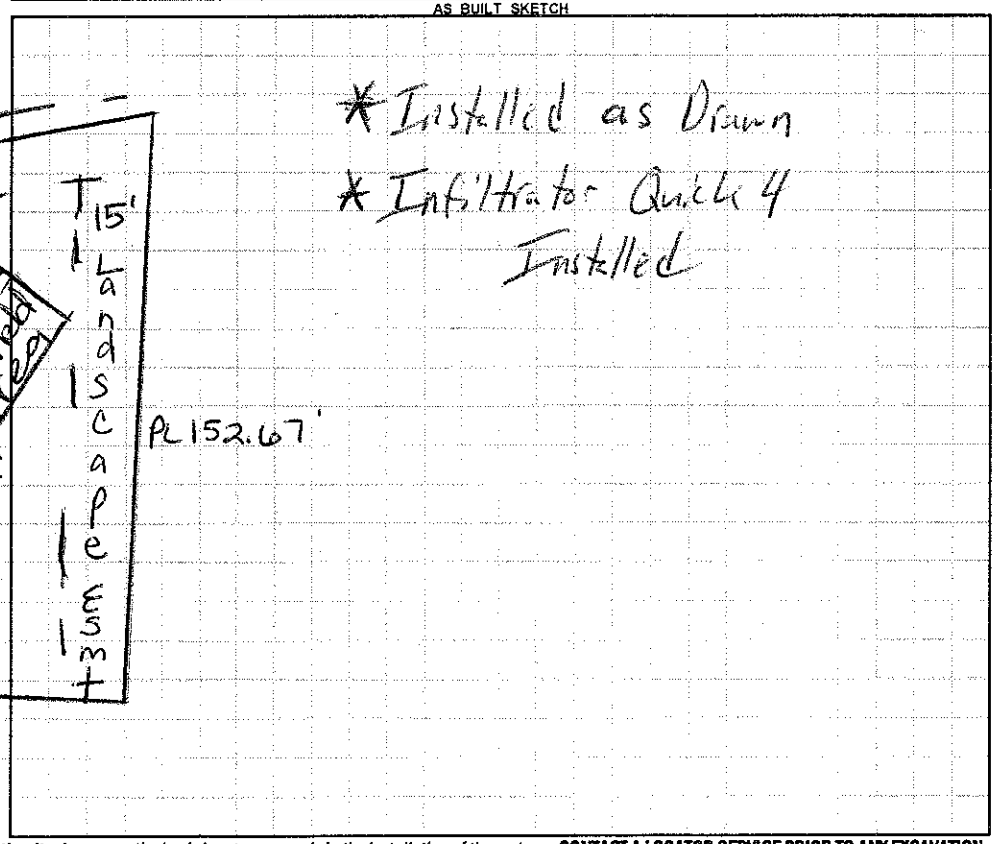

Permit can be suspended or revoked if any false information is supplied toward securing the permit / any unauthorized changes are made to the site / any unauthorized changes are made in the installation of the system. **CONTACT A LOCATOR SERVICE PRIOR TO ANY EXCAVATION**

[ ] **IMPROVEMENT PERMIT** *with plat valid without expiration.* [ ] **IMPROVEMENT PERMIT** *with site plan valid for 60 mos.* [ ] **AUTHORIZATION TO CONSTRUCT** *valid for period equal to IMPROVEMENT PERMIT--not to exceed 60 mo.*

Owner / Applicant Signature: Bonanza Dev. Co. Inc. by Scott L. Needham RS Date: 9/12/13 Installed by: R & H

IMPROVEMENT PERMIT by: Maine H. Dixon RS Date: 9/10/13 OPERATION PERMIT by: [signature] Date: 3-6-14

AUTHORIZATION TO CONSTRUCT by: Maine H. Dixon RS Date: 9/10/13 Existing System Inspected by: Date:

Health Dept. Copy - WHITE Applicant (Final Approval) - YELLOW Applicant (Conditional Approval) - PINK