IREDELL COUNTY HEALTH DEPARTMENT

STATESVILLE 704-878-5305 MOORESVILLE 704-664-5281

IMPROVEMENT PERMIT / AUTHORIZATION TO CONSTRUCT / OPERATION PERMIT / EXISTING SYSTEM INSPECTION

PERMIT# 128949

OWNER OR APPLICANT Bonanza Dev. Co. PIN# 4636 33 3208.008 9636237516 DATE 3/20/06

ADDRESS 816 G Brawley Sch. Rd. Mooresville, NC. 28117 PHONE: Business _____ Home _____

LOCATION 1100 TL Hall of Pines L Meadowcrest Ln L Vista View Pl. on (R) off Cul de sac

SUBDIVISION Village of Hall of Pines SECTION _____ LOT 8 LOT AREA .689 SITE CLASS. P3 DESIGN FLOW 360 L.T.A.R. .25

Septic Tank: 1000 Gallons: STB 1194 Date 7-21-05

Pump Tank: _____ Gallons: PT _____ Date _____

Pump Make: _____ Model _____ Serial No. _____

Nitrification Field: No Fields 1 Square Feet 1080 Linear Feet 360

No Lines 4 Trench Width 3' Max Trench Bottom Depth 3'

[X] New System [ ] Repair [ ] Expansion System Type: I II III IV V VI

System Description: GRAV - 25% Reduced

Repair System Description: LA - PPBPS 16"

Maintenance Agreement Required: [ ] Yes [X] No

Gravel Depth N/A [ ] Gravity [ ] Pressure [ ] Slab [X] Crawl Space [ ] Basement w/plumbing [ ] Basement wo/plumbing

[X] House/Mod. Home No. Bedrooms 3

[ ] Mobile Home No. Persons 3

[ ] Business No. Employees ____

[ ] Other


Water Supply: [ ] Individual [ ] Public [X] Community

Comments:/Conditions:


Comments:/Conditions: Red Poly 10K filter Quick 4 installed ac per site sketch 4@ 88, 90

#493

INITIAL SITE SKETCH

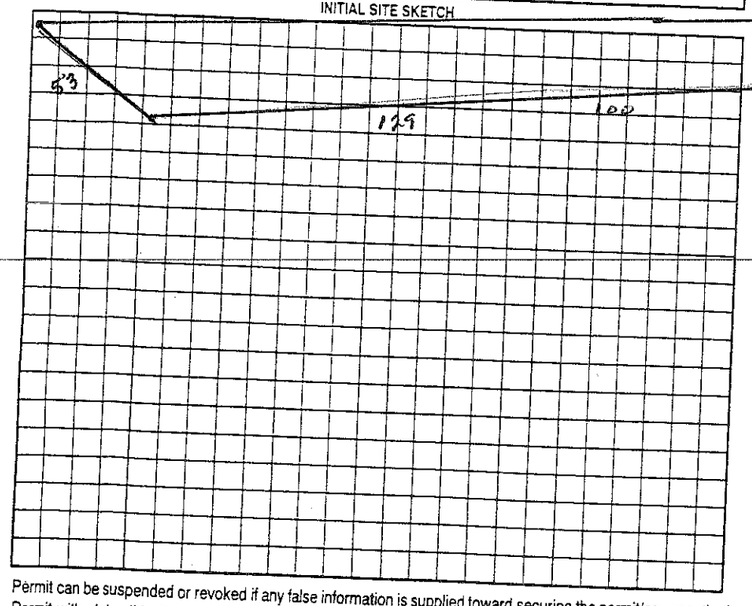

AS BUILT SKETCH

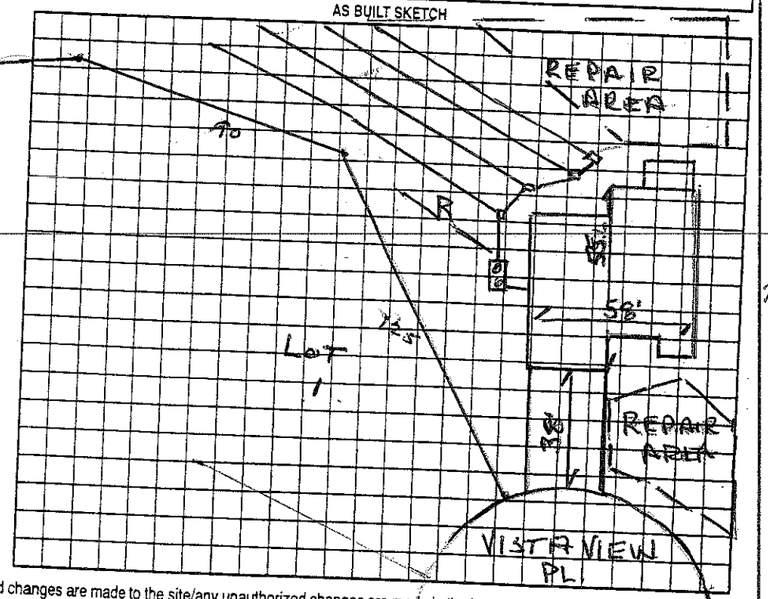

Permit can be suspended or revoked if any false information is supplied toward securing the permit/any unauthorized changes are made to the site/any unauthorized changes are made in the installation of the system. Improvement Permit with plat valid without expiration. ☐ Improvement Permit with site plan valid for sixty months ☐ Authorization to Construct is valid for a period equal to that of Improvement Permit – not to exceed sixty months.

Signed: * Joyce P Meadows date 5/22/06

Improvement Permit by: Wesley Sparks RS date 3/20/06

Authorization to Construct by: Wesley Sparks RS date 3/20/06

Installed by: EJ Ervin

Operation Permit by: Jimmy Melville date 8-14-06

Existing System Inspection by: _____ date _____

HEALTH DEPT. COPY: WHITE OWNER COPY (FINAL): YELLOW OWNER COPY (INITIAL): PINK