IREDELL COUNTY HEALTH DEPARTMENT

STATESVILLE 704-878-5305 MOORESVILLE 704-664-5281

IMPROVEMENT PERMIT / AUTHORIZATION TO CONSTRUCT / OPERATION PERMIT / EXISTING SYSTEM INSPECTION

PERMIT# 128950 PIN# 4636333208.009 4636-23-8458 DATE 2-21-07

OWNER OR APPLICANT Bonanza Development Co. PHONE: Business 704-662-0105 Home 704-363-9942

ADDRESS 816-G Brawley Sch Rd Mooresville 28117

LOCATION Brawley school Rd TL Isle of Pines TL Meadow Crest Ln TL Vista View on right

SUBDIVISION Villages @ Isle of Pines BLOCK / SECTION ____ LOT 9 LOT AREA .689 Ac. SITE CLASS. PS DESIGN FLOW 360gpd L.T.A.R. .225 gpd/ft²

Septic Tank: 1000 Gallons: STB 794 Date 2-19-07

Pump Tank: 1000 Gallons: PT 27 Date 10-27-07

Pump Make: Goulds Model WE0712H Serial No. ____

Nitrification Field: No Fields 1 Square Feet 1600 Linear Feet 270

No Lines 6 @ 45' Trench Width 24" Max Trench Bottom Depth 36" Gravel Depth NA ☐ Gravity ☒ Pressure

☒ New System ☐ Repair ☐ Expansion System Type: I II (III) IV V VI

System Description: PPBPS pump pm

Repair System Description: LP PPBPS

Maintenance Agreement Required: ☐ Yes ☒ No

☒ House/Mod. Home No. Bedrooms 3

☐ Mobile Home No. Persons 6

☐ Business No. Employees ____

☐ Other ____

Water Supply: ☐ Individual ☒ Public ☒ Community

☐ Slab ☒ Crawl Space ☐ Basement w/plumbing ☐ Basement wo/plumbing


Comments:/Conditions:

Precise grading needed to put lines on contour


Comments:/Conditions:

1" = 50'

INITIAL SITE SKETCH

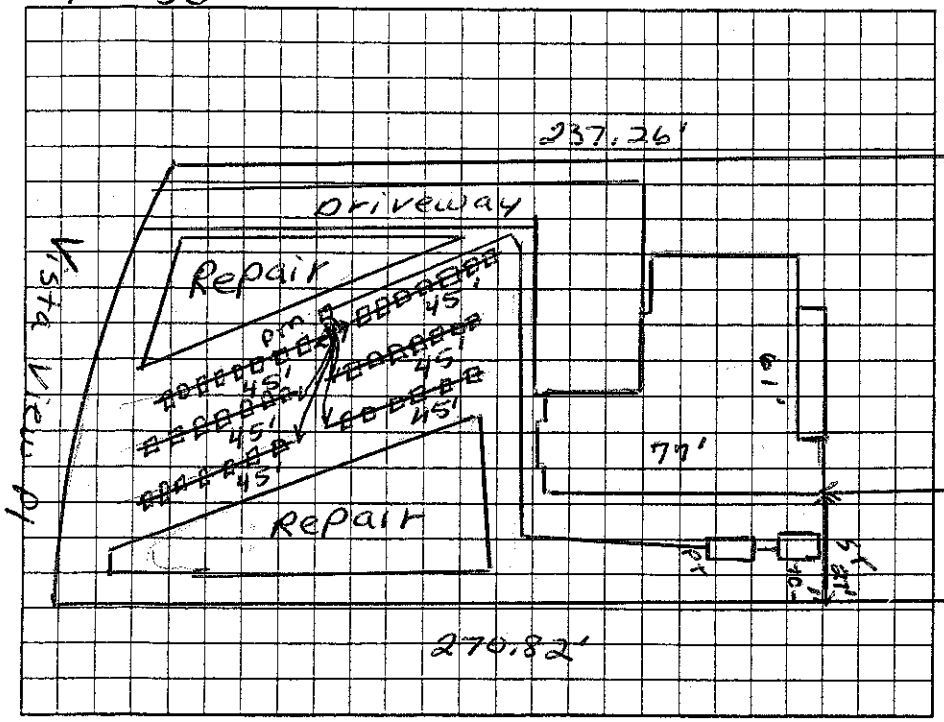

AS BUILT SKETCH

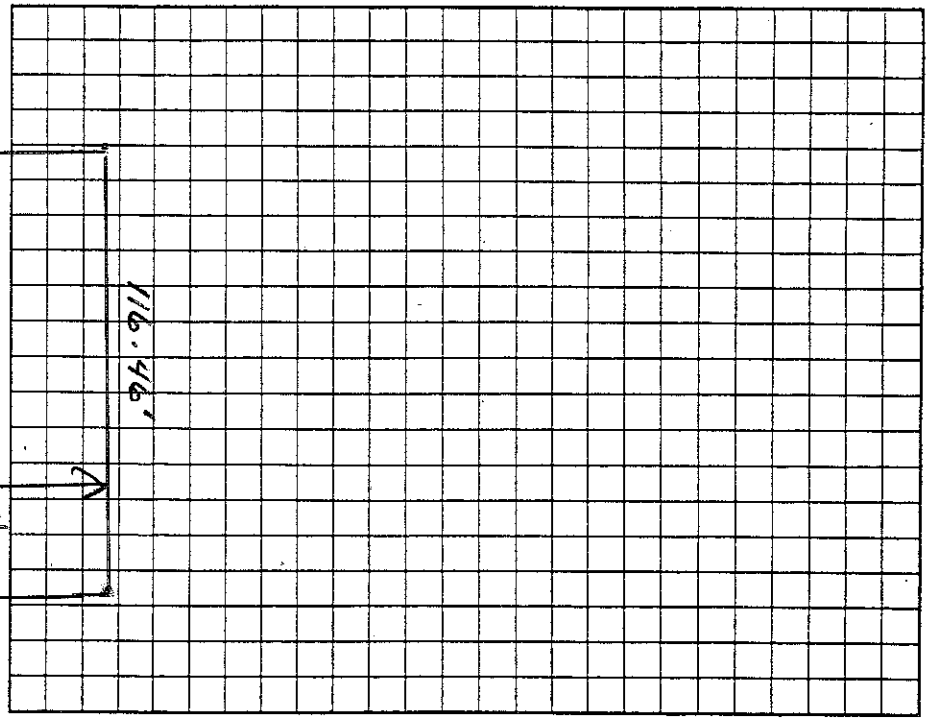

Permit can be suspended or revoked if any false information is supplied toward securing the permit/any unauthorized changes are made to the site/any unauthorized changes are made in the installation of the system. Improvement Permit with plat valid without expiration ☐ Improvement Permit with site plan valid for sixty months ☒ Authorization to Construct is valid for a period equal to that of Improvement Permit – not to exceed sixty months.

Signed: Joyce P Needham date 3-1-07 Installed by: FJ Ewin

Improvement Permit by: Judy Melville date 2-22-07 Operation Permit by: Wesley Sparks RS date 1/24/08

Authorization to Construct by: Judy Melville date 2-22-07 Existing System Inspection by: ____ date ____

HEALTH DEPT. COPY: WHITE OWNER COPY (FINAL): YELLOW OWNER COPY (INITIAL): PINK