IREDELL COUNTY HEALTH DEPARTMENT

STATESVILLE 704-878-5305 MOORESVILLE 704-664-5281

IMPROVEMENT PERMIT / AUTHORIZATION TO CONSTRUCT / OPERATION PERMIT / EXISTING SYSTEM INSPECTION

PERMIT# 128947 PIN# 4636 33 3208.000 4636239142 DATE 8/2/06

OWNER OR APPLICANT Bonanza Dev. Corp Inc. PHONE: Business 704-662-0105 Home

ADDRESS 816 G Brawley School Rd. Mooresville, NC. 28117

LOCATION 1100 TL Isle of Pines TL Meadow Crest, 2nd lot on (L)

SUBDIVISION Village of Isle of Pines SECTION LOT 6 LOT AREA > 30,000 FT² SITE CLASS PS DESIGN FLOW 360 L.T.A.R. .3

Septic Tank: 1000 Gallons; STB 799 Date 2-28-07

Pump Tank: Gallons; PT Date

Pump Make: Model Serial No.

Nitrification Field: No Fields 1 Square Feet 900 Linear Feet 300

No Lines 3@100' Trench Width 3' Max Trench Bottom Depth 3'

[X] New System [ ] Repair [ ] Expansion System Type: I II (III) IV V VI

System Description: Drop Box - 25% Reduced

Repair System Description: PM - 25% Reduced

Maintenance Agreement Required: [ ] Yes [X] No

[X] House/Mod. Home [ ] Mobile Home [ ] Business [ ] Other

No. Bedrooms 3 No. Persons 2.6 No. Employees

Water Supply: [ ] Individual [ ] Public [X] Community


Gravel Depth No [X] Gravity [ ] Pressure [ ] Slab [X] Crawl Space [ ] Basement w/plumbing [ ] Basement wo/plumbing

Comments:/Conditions:


Comments:/Conditions:

1" = 50'

INITIAL SITE SKETCH

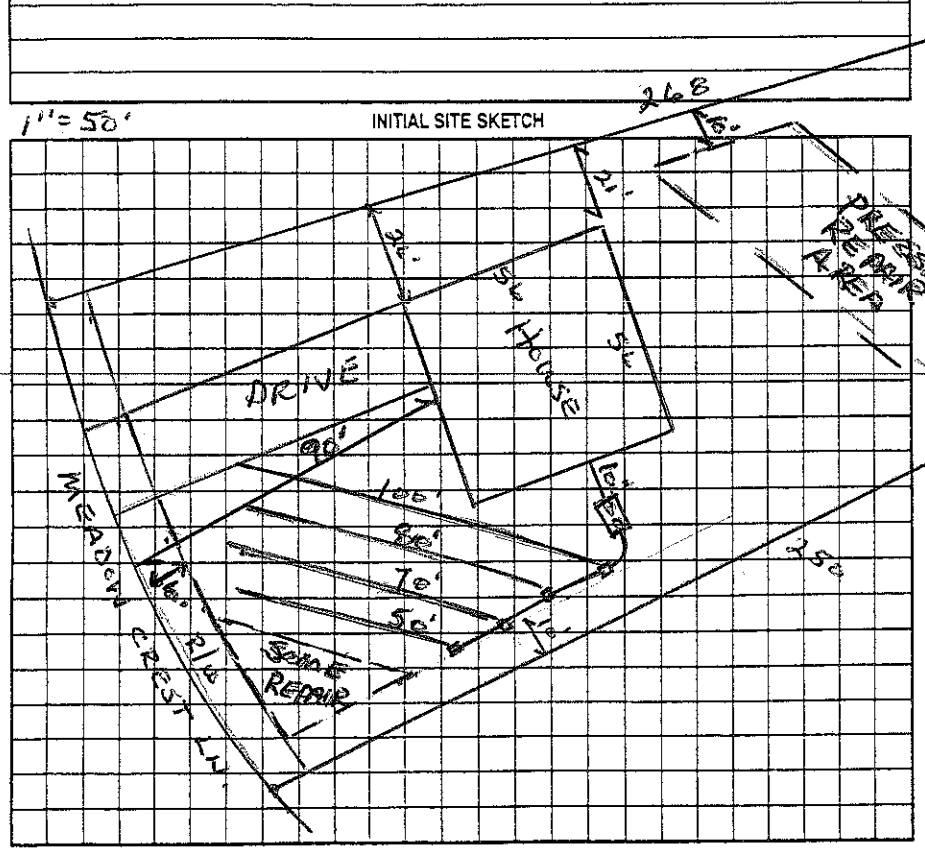

AS BUILT SKETCH

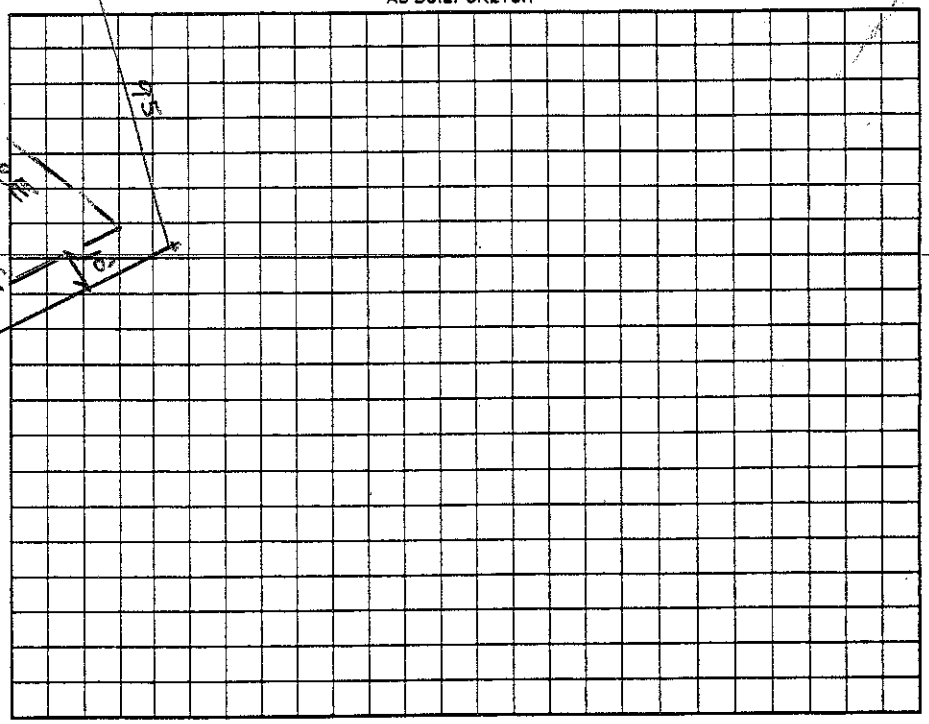

Permit can be suspended or revoked if any false information is supplied toward securing the permit/any unauthorized changes are made to the site/any unauthorized changes are made in the installation of the system. Improvement Permit with plat valid without expiration ☐ Improvement Permit with site plan valid for sixty months ☐ Authorization to Construct is valid for a period equal to that of Improvement Permit – not to exceed sixty months.

Signed: [signature] date 8/4/06

Improvement Permit by: Wesley Sparks R.S. date 8/2/06

Authorization to Construct by: Wesley Sparks R.S. date 8/2/06

Installed by: F J Ervin

Operation Permit by: John E Alph date 4-13-07

Existing System Inspection by: date

HEALTH DEPT. COPY: WHITE OWNER COPY (FINAL): YELLOW OWNER COPY (INITIAL): PINK

IREDELL COUNTY HEALTH DEPARTMENT

STATESVILLE 704-878-5305 MOORESVILLE 704-664-5281

IMPROVEMENT PERMIT / AUTHORIZATION TO CONSTRUCT / OPERATION PERMIT / EXISTING SYSTEM INSPECTION

PERMIT# 128947 PIN# 4636 33 3208.000 4636239142 DATE 8/2/06

OWNER OR APPLICANT Bonanza Dept. Centers PHONE: Business 704-662-0105 Home

ADDRESS 816 G Brawley School Rd. Mooresville, NC. 28117

LOCATION 1100 TL Block of Point TL Meadowcrest, 2nd lot on (L)

SUBDIVISION V. Plan (L) Block of Point BLOCK/SECTION LOT 1a LOT AREA > 30,000 FT² SITE CLASS. PS DESIGN FLOW 360 L.T.A.R. .3

Septic Tank: 1000 Gallons; STB 194 Date 2-28-07
Pump Tank: Gallons; PT Date
Pump Make: Model Serial No.
Nitrification Field: No Fields 1 Square Feet 900 Linear Feet 300
No Lines 3@100' Trench Width 3' Max Trench Bottom Depth 3'

☒ New System ☐ Repair ☐ Expansion System Type: I (II) III IV V VI
System Description: Dual Bed - 25% Reduced
Repair System Description: PM - 25% Reduced
Maintenance Agreement Required: ☐ Yes ☒ No

☒ House/Mod. Home ☐ Mobile Home ☐ Business ☐ Other
No. Bedrooms 3 No. Persons 2.5 No. Employees

Water Supply: ☐ Individual ☐ Public ☒ Community


Gravel Depth No ☒ Gravity ☐ Pressure ☐ Slab ☒ Crawl Space ☐ Basement w/plumbing ☐ Basement wo/plumbing

Comments:/Conditions:


Comments:/Conditions:

1" = 50'

INITIAL SITE SKETCH

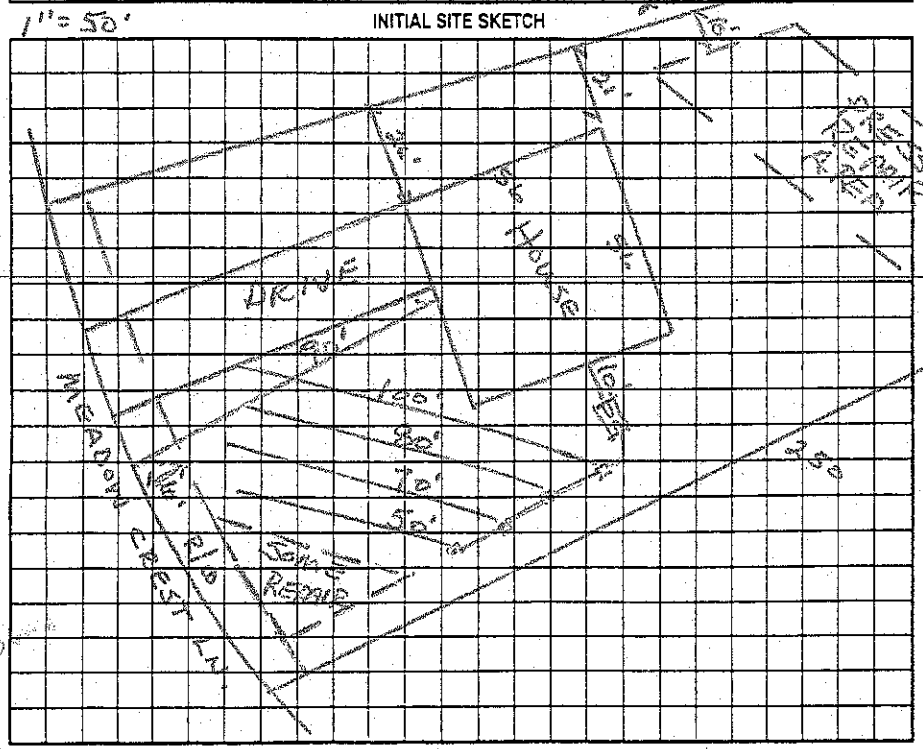

AS BUILT SKETCH

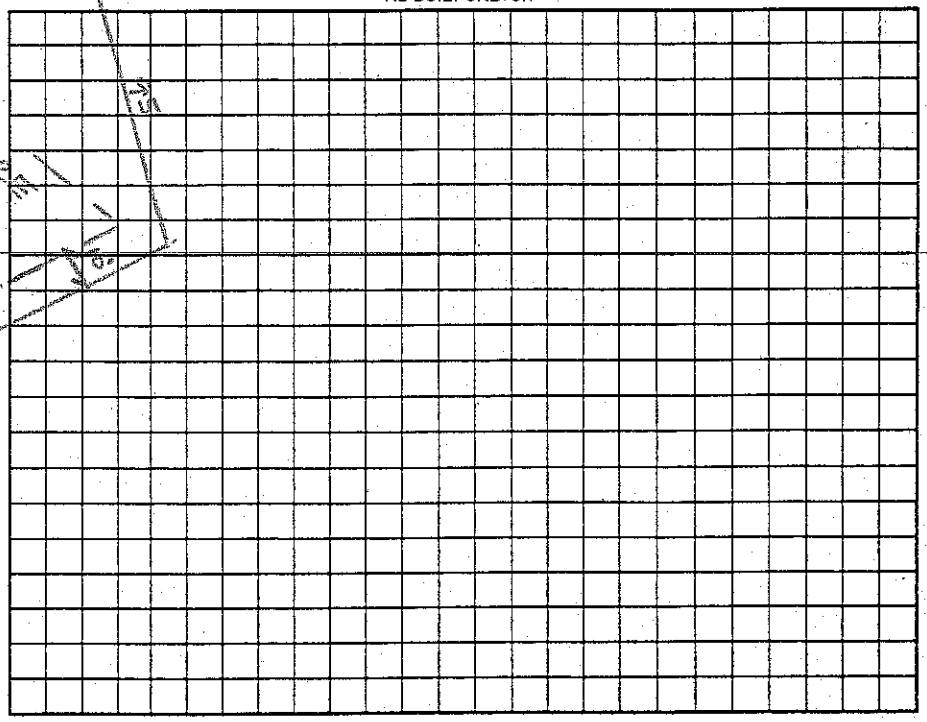

Permit can be suspended or revoked if any false information is supplied toward securing the permit/any unauthorized changes are made to the site/any unauthorized changes are made in the installation of the system. Improvement Permit with plat valid without expiration ☐ Improvement Permit with site plan valid for sixty months ☐ Authorization to Construct is valid for a period equal to that of Improvement Permit – not to exceed sixty months.

Signed: date 8/4/06

Improvement Permit by: Wendy Sparks R.S. date 8/2/06

Authorization to Construct by: Wendy Sparks R.S. date 8/2/06

Installed by: F J Ervin

Operation Permit by: date 4-13-07

Existing System Inspection by: date

HEALTH DEPT. COPY: WHITE OWNER COPY (FINAL): YELLOW OWNER COPY (INITIAL): PINK