2:00

IREDELL COUNTY HEALTH DEPARTMENT

STATESVILLE 704-878-5305 MOORESVILLE 704-664-5281

IMPROVEMENT PERMIT / CERTIFICATE OF COMPLETION / OPERATION PERMIT / EXISTING SYSTEM INSPECTION

PROPERTY DESCRIPTION NO. 17409 DATE Nov. 21, '94 TAX MAP NO. part of 2KB45 Watershed: ☐ Yes ☐ No

OWNER OR CONTRACTOR BONANZA Development Co. PHONE: Business 663-6487 Home

ADDRESS PO Box 1186 MOORESVILLE, NC 28115 4636-24-2070

LOCATION 1100 TL 1113 ~½ mile on left

SUBDIVISION MALLARD Pines BLOCK / SECTION LOT 3A LOT AREA SITE CLASS. DESIGN FLOW 480 gpd L.T.A.R. .03

Septic Tank: 1500 Gallons; STB 797 Date 2-25-95 ☑ New System ☐ Repair System Type: I, II, III, IV, V, VI

Pump Tank: Gallons; PT Date System Description: gravity CONVENTIONAL

Pump Make: Model Serial No. Repair System Description: offsite LPPBPS

Nitrification Field: No Fields 2 Square Feet 1600 Linear Feet 534 Maintenance Agreement Required: ☐ Yes ☑ No Initial sys.

No Lines 4+4 Trench Width 36" Max Trench Bottom Depth 24" Gravel Depth 12"

☐ House/Mod. Home No. Bedrooms 4

☐ Mobile Home No. Bathrooms 4

☐ Business No. Employees

☑ Other Duplex Apt.


☐ Slab ☑ Crawl Space ☐ Basement w/plumbing ☐ Basement wo/plumbing

Water Supply: ☑ Individual ☐ Community ☐ Public

Comments: This lot has been revised due to soil/site problems. Repair AREA is off site & Cooper graded easement to be provided prior to issuance of CO's. 267' Each Subfield, Keep trenches shallow.

Comments:

INITIAL SITE SKETCH

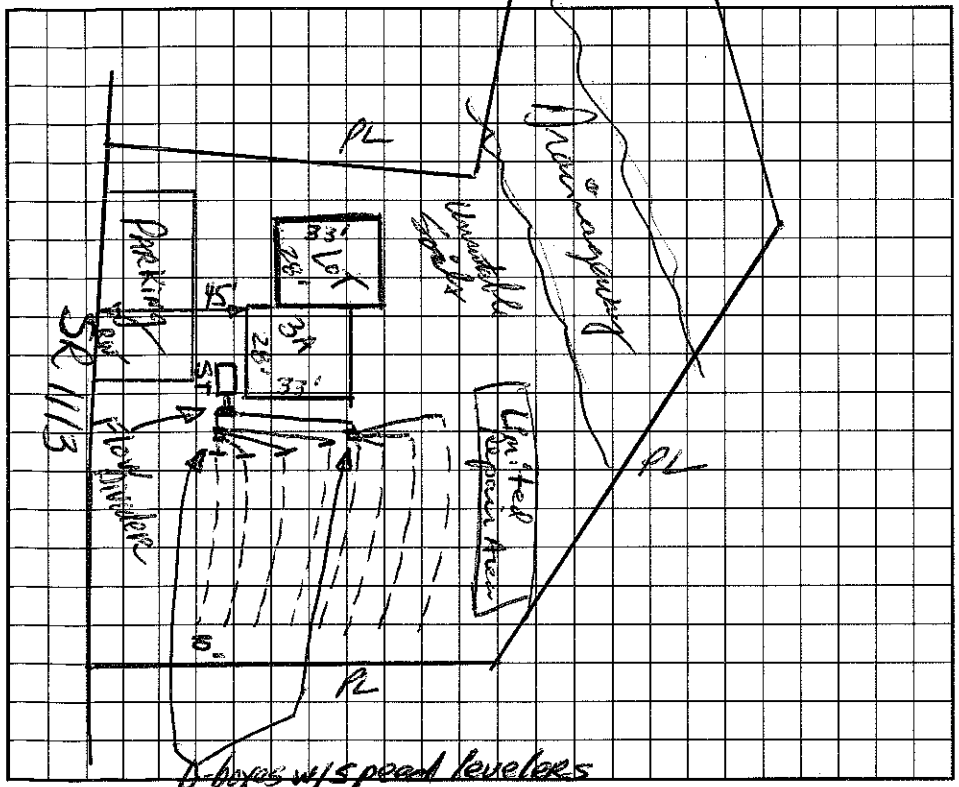

AS BUILT SKETCH

Same as initial sketch

I understand that this permit can be suspended or revoked if any false information is supplied toward securing the permit/any unauthorized changes are made to the site/any unauthorized changes are made in the installation of the system. Improvement Permit is valid for 60 months from date of issuance.

Signed: Mark T. Bradley

Improvement Permit by: Jack R. Hinson, RS date 11/21/94

Existing System Inspection by: date

Installed by: F. J. Ervin

Certificate of Completion by: J. C. Moore date 4-17-95

Operation Permit by: date

HEALTH DEPT. COPY: WHITE INSPECTION COPY (FINAL): GREEN OWNER COPY (FINAL): YELLOW INSPECTION COPY (INITIAL): PINK OWNER COPY (INITIAL): GOLD