IREDELL COUNTY HEALTH DEPARTMENT

Statesville Office (704) 878-5305 Mooresville Office (704) 660-3625

2:30

IMPROVEMENT PERMIT / AUTHORIZATION TO CONSTRUCT / OPERATION PERMIT / EXISTING SYSTEM

PERMIT # 176306

PIN # 4636-24-2926

APPLICANT: CALEB HILL

APPLICANT ADDRESS: 15506 CARRINGTON RIDGE DR. HUNTERSVILLE

SITE ADDRESS: 155 ISLE OF PINES RD

PHONE: 704-302-6676 ALT. PHONE:

SITE DIRECTIONS: BSR, TL ISLE OF PINES, ON L


SUBDIVISION: WHISPERING OAKS SECTION: LOT # 30 LOT AREA: .74 AC DESIGN FLOW: 480 L.T.A.R.: .25

Septic Tank	1000	(gal)	STB	825	Date	1-28-13	☒ New System	☐ Repair	☐ Expansion	System Type: I II (III) IV V VI	
Pump Tank		(gal)	PT		Date		System Description:	25% REDUCTION			
Pump Make			Model		Serial #		Repair System Description:	PANEL BLOCK			
# Nitrification Fields	1		# Lines	4@120'	Linear Ft:	480	Maintenance Agreement Required:	☐ YES	☒ NO		
Trench Width	36"		Max. Trench Bottom Depth	36"	Gravel Depth	—		☒ GRAVITY	☐ PRESSURE		

☒ Residence	No. Bedrooms	4	Water Supply
☐ Business	No. Persons		☒ Private
☐ Other	No. Employees		☐ Public
☒ Slab	☐ Crawl Space		☐ Community
☐ Basement w/plumbing			☐ Basement w/o plumbing

Comments / Conditions:

INITIAL SITE SKETCH

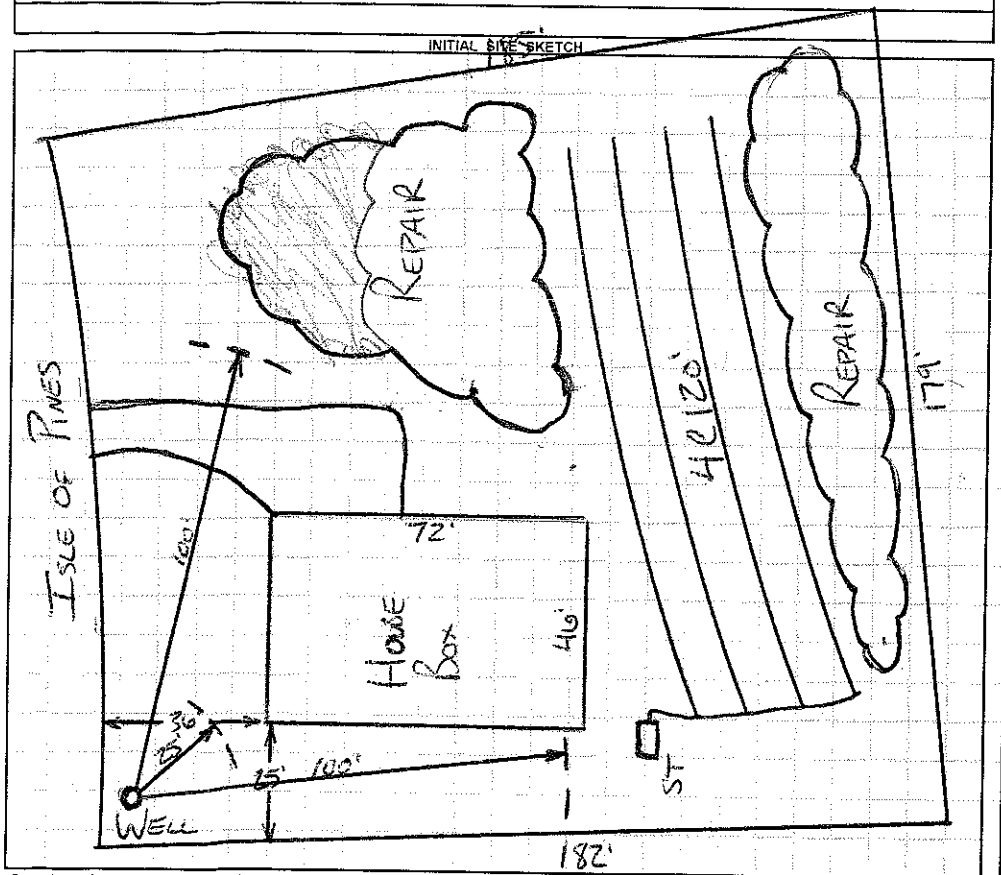

AS BUILT SKETCH

INSTALLED AS SHOWN

Permit can be suspended or revoked if any false information is supplied toward securing the permit / any unauthorized changes are made to the site / any unauthorized changes are made in the installation of the system. **CONTACT A LOCATOR SERVICE PRIOR TO ANY EXCAVATION**

☐ **IMPROVEMENT PERMIT** ***with plat*** *valid without expiration.*

☒ **IMPROVEMENT PERMIT** ***with site plan*** *valid for 60 mos.*

☒ **AUTHORIZATION TO CONSTRUCT** *valid for period equal to IMPROVEMENT PERMIT--not to exceed 60 mo.*

Owner / Applicant Signature: Date: 1-30-13 Installed by: ROWAN SEPTIC

IMPROVEMENT PERMIT by: Date: 1-24-13 OPERATION PERMIT by: Date: 4-24-13

AUTHORIZATION TO CONSTRUCT by: Date: 1-24-13 Existing System Inspected by: Date:

Health Dept. Copy - WHITE Applicant (Final Approval) - YELLOW Applicant (Conditional Approval) - PINK