IREDELL COUNTY HEALTH DEPARTMENT

STATESVILLE 704-878-5305 MOORESVILLE 704-664-5281

IMPROVEMENT PERMIT / AUTHORIZATION TO CONSTRUCT / OPERATION PERMIT / EXISTING SYSTEM INSPECTION

PERMIT# 15R170 PIN# 4636 24 4914 DATE 8/14/08

OWNER OR APPLICANT KRALOVIC CONSTRUCTION INC. PHONE: Business 704-662-9888 Home

ADDRESS 202 DIGH CIRCLE MOORESVILLE, NC. 28115

LOCATION 114 MISTY MEADOWS CT.

SUBDIVISION WHISPERING OAKS BLOCK / SECTION LOT 22 LOT AREA ~.82AC SITE CLASS. PS DESIGN FLOW 450 L.T.A.R. .25

Septic Tank: Gallons: STB Date

Pump Tank: EXISTING Gallons: PT Date

Pump Make: Model Serial No.

Nitrification Field: No Fields Square Feet Linear Feet

No Lines 3 Trench Width 3' Max Trench Bottom Depth 3' Gravel Depth ☐ Gravity ☒ Pressure

☒ New System ☐ Repair ☐ Expansion System Type: I II (III) IV V VI

System Description: PM - 25% REDUCTION

Repair System Description: LO-PBPS

Maintenance Agreement Required: ☐ Yes ☒ No

☒ House/Mod. Home ☐ Mobile Home ☐ Business ☐ Other

No. Bedrooms 4 No. Persons No. Employees


Water Supply: ☒ Individual ☐ Public ☐ Community

☐ Slab ☒ Crawl Space ☐ Basement w/plumbing ☐ Basement wo/plumbing


Comments/Conditions:

Comments/Conditions:

INITIAL SITE SKETCH

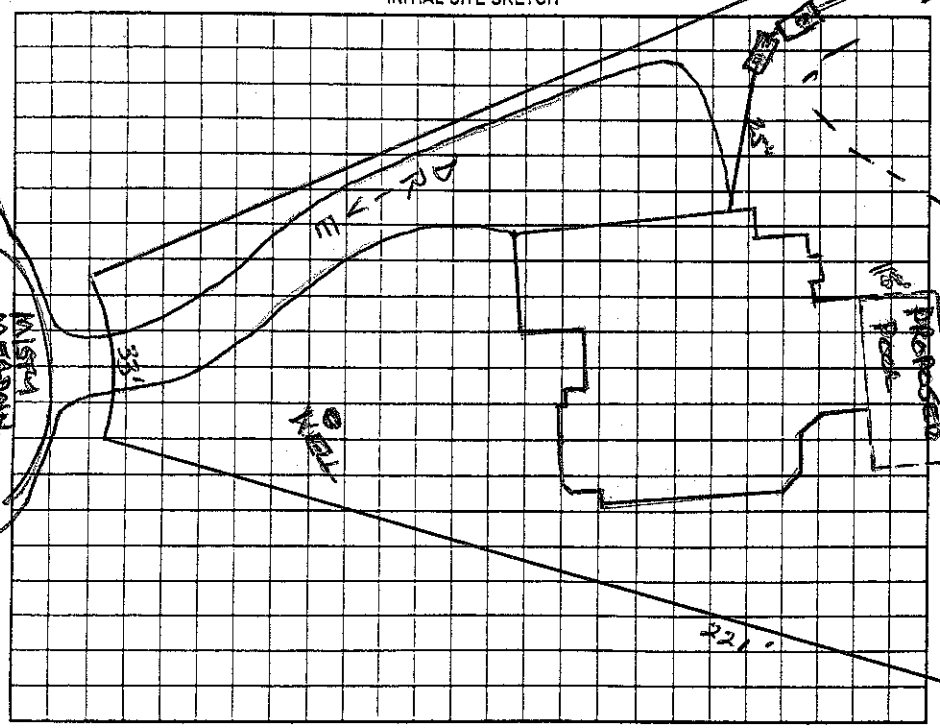

AS-BUILT SKETCH

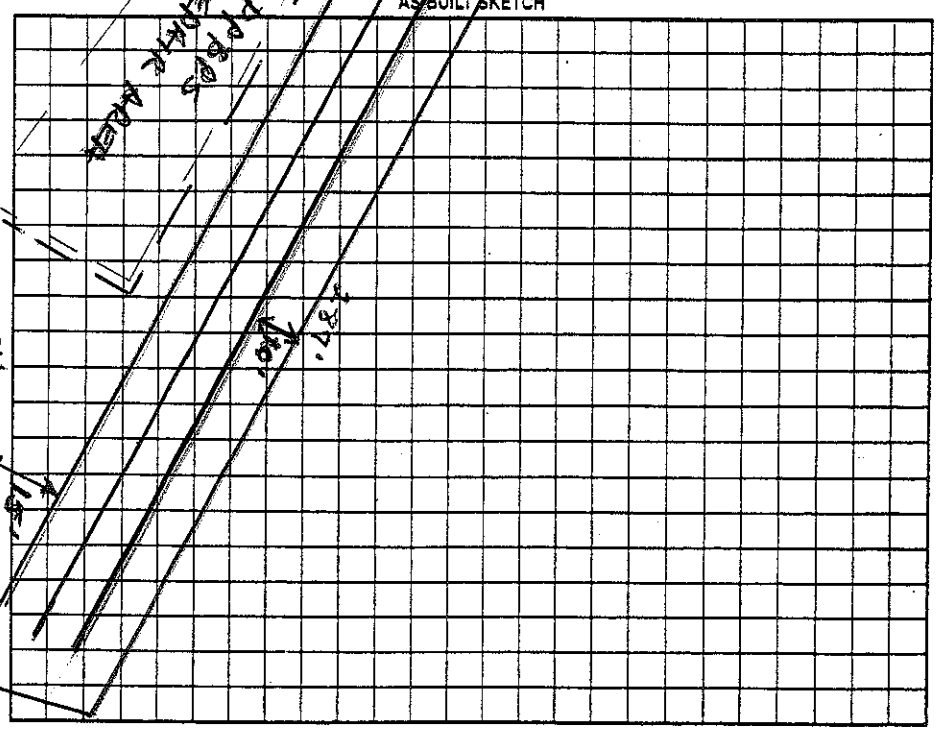

Permit can be suspended or revoked if any false information is supplied toward securing the permit/any unauthorized changes are made to the site/any unauthorized changes are made in the installation of the system. Improvement Permit with plat valid without expiration ☐ Improvement Permit with site plan valid for sixty months ☐ Authorization to Construct is valid for a period equal to that of Improvement Permit – not to exceed sixty months.

Signed: Terry Kasone date 8/15/08 Installed by: R. Abernathy

Improvement Permit by: date Operation Permit by: date

Authorization to Construct by: date Existing System Inspection by: Wesley Sparks RS. date 8/14/08

HEALTH DEPT. COPY: WHITE OWNER COPY (FINAL): YELLOW OWNER COPY (INITIAL): PINK