IREDELL COUNTY HEALTH DEPARTMENT

STATESVILLE 704-878-5305 MOORESVILLE 704-664-5281

IMPROVEMENT PERMIT / CERTIFICATE OF COMPLETION / OPERATION PERMIT / EXISTING SYSTEM INSPECTION

PROPERTY DESCRIPTION NO. 22002 DATE Nov. 15, '95 TAX MAP NO. part of 2K-B-45 Watershed: ☑ Yes ☐ No

OWNER OR CONTRACTOR BONANZA Dev. Co. PHONE: Business 4636-24-5355 Home W5404A

ADDRESS PO Box 1186, Mooresville

LOCATION Brawley Fork Rd. TL Isle of Pines TL 1st STREET on Right 480 AWS

SUBDIVISION Mallard Pines BLOCK / SECTION III LOT 19 LOT AREA N 30,000 ft² SITE CLASS. PS DESIGN FLOW 720 gpd L.T.A.R. .3 4 AWS

Septic Tank: 1500 Gallons; STB 799 Date 11/9/96

Pump Tank: _____ Gallons; PT _____ Date _____

Pump Make: _____ Model 1600 AWS Serial No. 400 AWS

Nitrification Field: No Fields 2 Square Feet 1000 Linear Feet 600

No Lines 3+4 Trench Width 36" Max Trench Bottom Depth 36" Gravel Depth N/A

☑ New System ☐ Repair System Type: I, II, (III) IV, V, VI

System Description: gravity INFILTRATOR

Repair System Description: LP Panel Block

Maintenance Agreement Required: ☐ Yes ☑ No initially

☑ Slab ☐ Crawl Space ☐ Basement w/plumbing ☐ Basement wo/plumbing

☐ House/Mod. Home No. Bedrooms 6

☐ Mobile Home No. Bathrooms 4-5

☐ Business No. Employees _____

☑ Other Duplex Apt


Water Supply: ☑ Individual ☐ Community ☐ Public

Comments: 1 well per 2 duplexes
12/10/96 - Reduced to 4 Bedroom building - AWS.

Comments:

INITIAL SITE SKETCH

1" = 100'

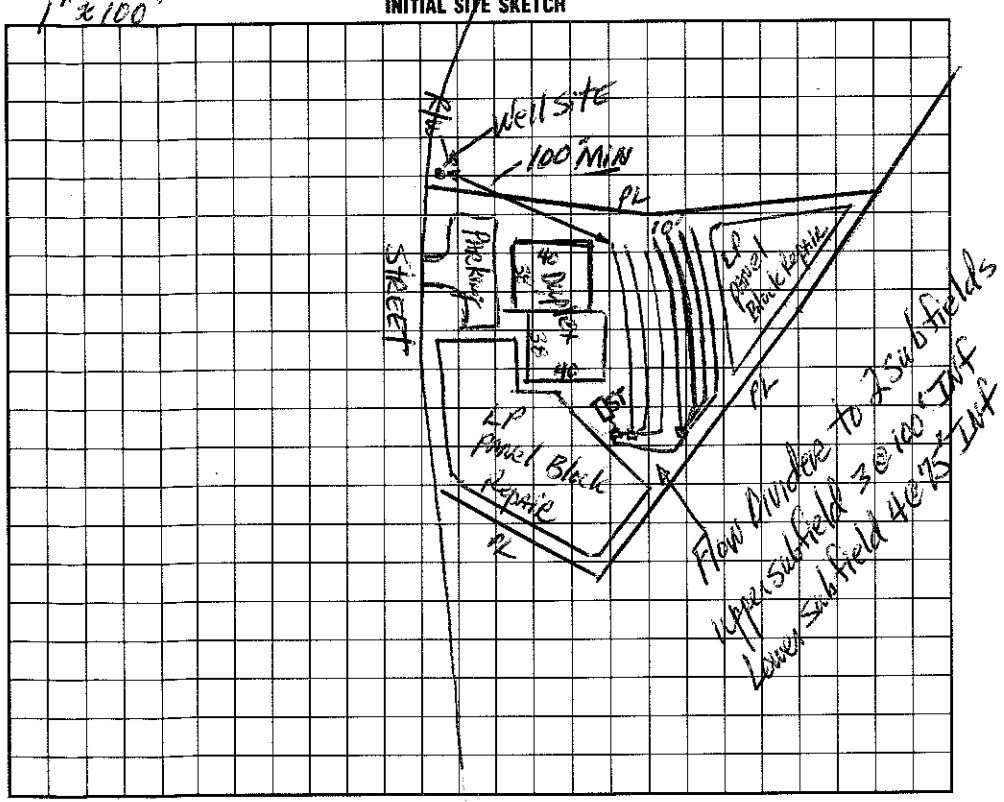

AS BUILT SKETCH

I understand that this permit can be suspended or revoked if any false information is supplied toward securing the permit/any unauthorized changes are made to the site/any unauthorized changes are made in the installation of the system.

Signed: X Maud Z Medlin

Improvement Permit by: Harold R Hinson, RS date 11-15-95

Existing System Inspection by: D R Hinson, RS date 8-28-96

Installed by: F J Ennis

Certificate of Completion by: _____ date _____

Operation Permit by: Wesley Sparks RS. date 12/13 FK

Bonanza Dev Co to construct

HEALTH DEPT. COPY: WHITE INSPECTION COPY (FINAL): GREEN OWNER COPY (FINAL): YELLOW INSPECTION COPY (INITIAL): PINK OWNER COPY (INITIAL): GOLD