IREDELL COUNTY HEALTH DEPARTMENT

STATESVILLE 704-878-5305 MOORESVILLE 704-664-5281

IMPROVEMENT PERMIT / CERTIFICATE OF COMPLETION / OPERATION PERMIT / EXISTING SYSTEM INSPECTION

PROPERTY DESCRIPTION NO. 2116 DATE July 31, '95 TAX MAP NO. part of 2KB45 Watershed: ☑ Yes ☐ No

OWNER OR CONTRACTOR Bonanza Dev. Co. / Mark Nadland PHONE: Business ~~Home~~ 463e-24-5743

ADDRESS PO Box 1186 Mooresville

LOCATION Brawley School Rd. TR Isle of Pines TL Double Eagle Dr. TL Birdie Ct. 1st Lot on Left

SUBDIVISION Hallbrook Manor BLOCK / SECTION A 2 LOT 8 LOT AREA .726 AC SITE CLASS. 15 per 1956 DESIGN FLOW 480 gpd L.T.A.R. .3

Septic Tank: 1500 Gallons; STB 799 Date 6/9/96

Pump Tank: _____ Gallons; PT _____ Date _____

Pump Make: _____ Model _____ Serial No. _____

Nitrification Field: No Fields 2 Square Feet 1200 Linear Feet 400

No Lines 2+3 Trench Width 36" Max Trench Bottom Depth 36" Gravel Depth N/A

☑ New System ☐ Repair System Type: I, II, III, IV, V, VI

System Description: gravity Infiltrator

Repair System Description: pumped Infiltrator

Maintenance Agreement Required: ☐ Yes ☑ No

☐ House/Mod. Home No. Bedrooms 4

☐ Mobile Home No. Bathrooms 4

☐ Business No. Employees _____

☑ Other Duplex


☐ Slab ☑ Crawl Space ☐ Basement w/plumbing ☐ Basement wo/plumbing

Water Supply: ☑ Individual ☐ Community ☐ Public

Comments: Use flow divider to create 2 subfields; Use Dpay w/speed leveler for each subfield.

Comments: 2@100 3@67

INITIAL SITE SKETCH

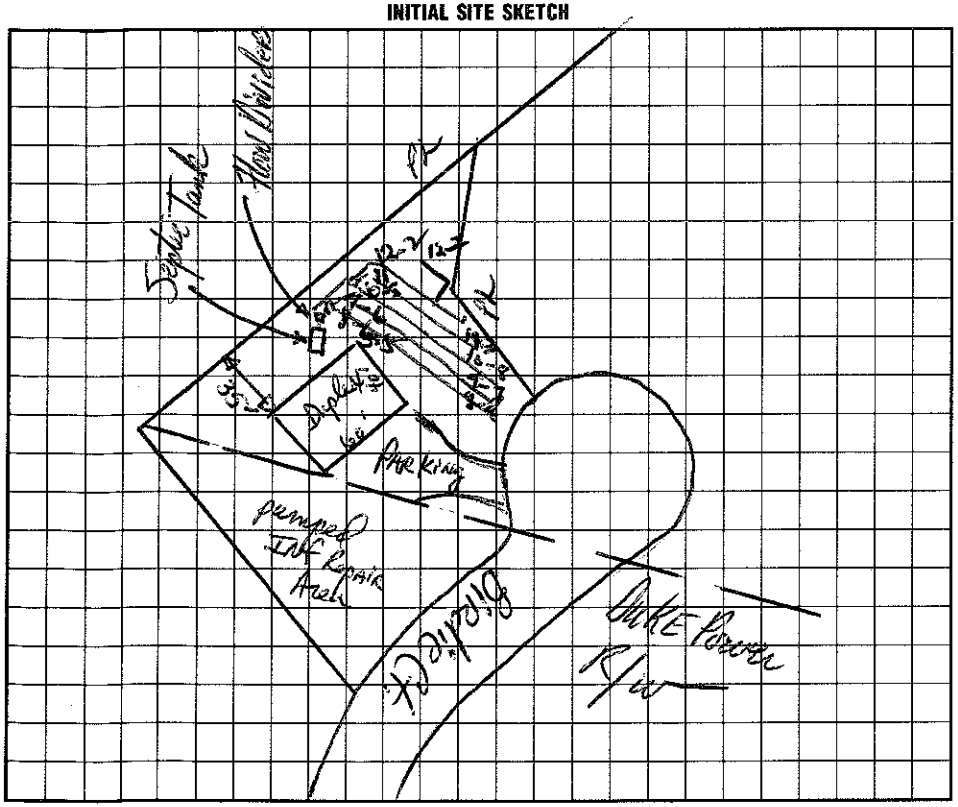

AS BUILT SKETCH

I understand that this permit can be suspended or revoked if any false information is supplied toward securing the permit/any unauthorized changes are made to the site/any unauthorized changes are made in the installation of the system.

Signed: X Mark Nadland

Improvement Permit by: Jesse L. Hamm, RS date 7-31-95

Existing System Inspection by: _____ date _____

Installed by: F J Erwin

Certificate of Completion by: _____ date _____

Operation Permit by: Wesley Sparks R.S. date 7/17/96

HEALTH DEPT. COPY: WHITE INSPECTION COPY (FINAL): GREEN OWNER COPY (FINAL): YELLOW INSPECTION COPY (INITIAL): PINK OWNER COPY (INITIAL): GOLD