IREDELL COUNTY HEALTH DEPARTMENT

Statesville Office (704) 878-5305 Mooresville Office (704) 660-3625 ALD PERMIT # 129815

IMPROVEMENT PERMIT / AUTHORIZATION TO CONSTRUCT / OPERATION PERMIT / EXISTING SYSTEM

PIN # 4636-24-5953 Y 000 167460

APPLICANT: Angelo Perrino APPLICANT ADDRESS: 115 Misty Meadow Ct.

SITE ADDRESS: 115 Misty Meadows Ct Mooresville NC PHONE: ALT. PHONE:

SITE DIRECTIONS: BSR, TL Isle of Pines, TL Whispering Oaks, TR Misty Meadow Ct, site at end.


SUBDIVISION: Whispering Oaks SECTION: LOT # 21/21A LOT AREA: .87 Acre + SFE DESIGN FLOW: 360 GPD L.T.A.R.: .3 SFE 21A

Septic Tank	1000	(gal)	STB	710	Date	12/9	☑ New System	☐ Repair	☐ Expansion	System Type: I II III IV V VI	
Pump Tank	1000	(gal)	PT	363	Date	4/9	System Description:	LP PPBDS			
Pump Make	Goulds	Model	WE05H		Serial #		Repair System Description:	LP PPBDS			
# Nitrification Fields	1	# Lines	2 @ 100'		Linear Ft:	200'	Maintenance Agreement Required:	☑ YES	☐ NO		
Trench Width	24"	Max. Trench Bottom Depth	36"		Gravel Depth	N/A		☐ GRAVITY	☒ PRESSURE		


☑ Residence	No. Bedrooms	3	Water Supply
☐ Business	No. Persons	6	☑ Private
☐ Other	No. Employees		☐ Public
☐ Slab	☑ Crawl Space		☐ Community
☐ Basement w/plumbing		☐ Basement w/o plumbing	

Comments / Conditions:

INITIAL SITE SKETCH

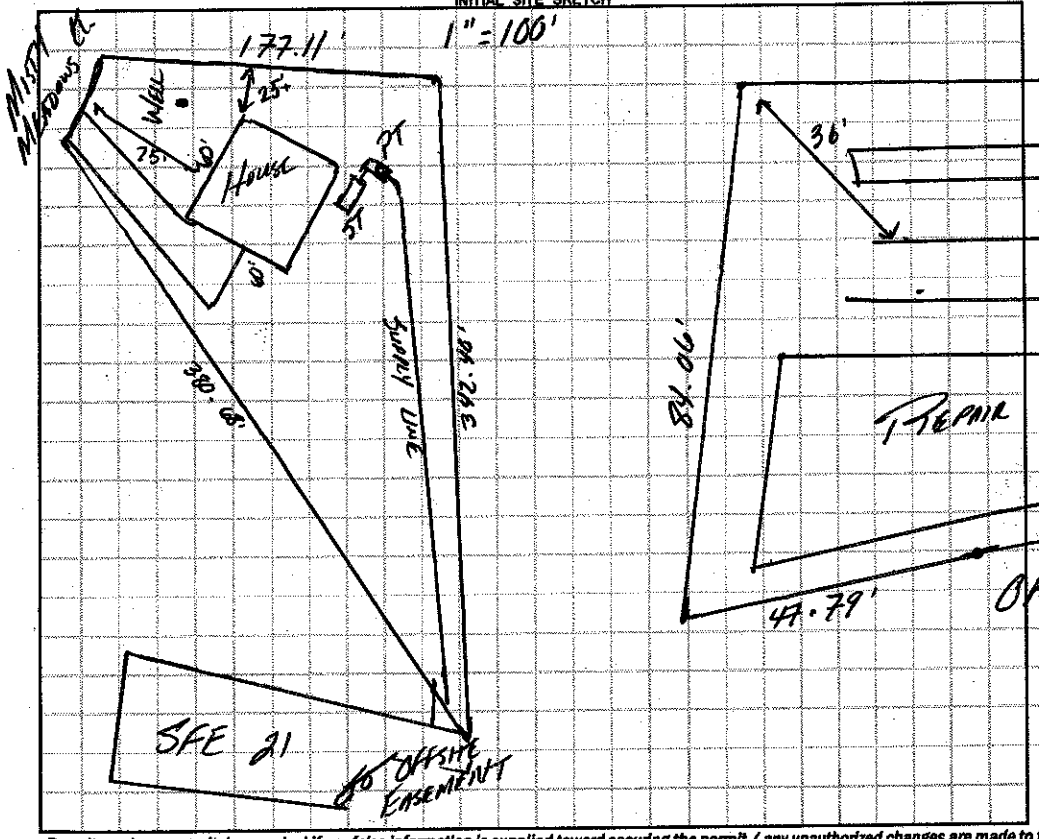

AS BUILT SKETCH

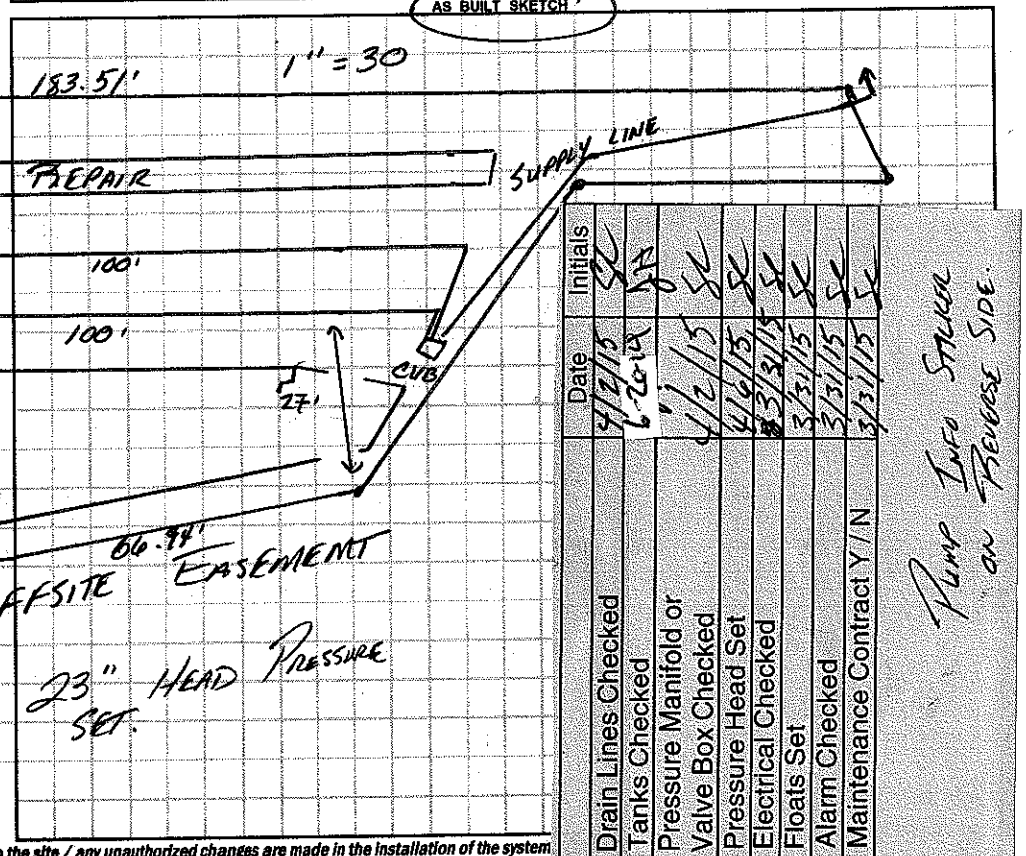


Permit can be suspended or revoked if any false information is supplied toward securing the permit / any unauthorized changes are made to the site / any unauthorized changes are made in the installation of the system

☐ **IMPROVEMENT PERMIT** *with plat valid without expiration.* ☒ **IMPROVEMENT PERMIT** *with site plan valid for 60 mos.* ☑ **AUTHORIZATION TO CONSTRUCT** *valid for period equal to IMPROVEMENT PERMIT--not to exceed 60 mo.*

Owner / Applicant Signature: Date:

Installed by: Gunter's Grading

IMPROVEMENT PERMIT by: APPROVED Date: APR 06 2015

OPERATION PERMIT by: APPROVED Date: APR 06 2015

AUTHORIZATION TO CONSTRUCT by: APPROVED Date: APR 06 2015

Existing System Inspected by: Date:

Health Dept. Copy - WHITE Applicant (Final Approval) - YELLOW Applicant (Conditional Approval) - PINK

	Date	Initials
Drain Lines Checked	4/2/15	SC
Tanks Checked	6-2014	JH
Pressure Manifold or Valve Box Checked	4/2/15	SC
Pressure Head Set	4/6/15	SC
Electrical Checked	3/31/15	SC
Floats Set	3/31/15	SC
Alarm Checked	3/31/15	SC
Maintenance Contract Y / N	3/31/15	SC

Pump Info Sticker on Reverse Side

