IREDELL COUNTY HEALTH DEPARTMENT

STATESVILLE 704-878-5305 MOORESVILLE 704-664-5281

IMPROVEMENT PERMIT / CERTIFICATE OF COMPLETION / OPERATION PERMIT / EXISTING SYSTEM INSPECTION

PROPERTY DESCRIPTION NO. 22001 DATE Dec 29, '95 TAX MAP NO. part of 2K845 Watershed: ☑ Yes ☐ No

OWNER OR CONTRACTOR Bonanza Development Co. PHONE: Business 4636-24-6265 Home

ADDRESS PO Box 1186 / Mooresville WS4CA

LOCATION Brawley Sch Rd. TR Isle of Pines ~1/4 mile TL on Right

SUBDIVISION Maitland Pines BLOCK / SECTION III LOT 18 LOT AREA ± 30,000 ft² SITE CLASS PS pre.1956 DESIGN FLOW 720 gpd L.T.A.R. .3

Septic Tank: 1500 Gallons; STB 794 Date 1/6/97

Pump Tank: Gallons; PT Date

Pump Make: Model Serial No.

Nitrification Field: No Fields 2 Square Feet 1800 Linear Feet 600

No Lines 4+4 Trench Width 36" Max Trench Bottom Depth 36" Gravel Depth NA

☑ New System ☐ Repair System Type: I II ☑ III IV V VI

System Description: gravity Infiltrator

Repair System Description: LP PPBPS

Maintenance Agreement Required: ☐ Yes ☑ No

☐ House/Mod. Home No. Bedrooms 6

☐ Mobile Home No. Bathrooms 5

☐ Business No. Employees

☑ Other Apartment


☐ Slab ☐ Crawl Space ☐ Basement w/plumbing ☐ Basement wo/plumbing

Water Supply: ☑ Individual ☐ Community ☐ Public

Comments:

Comments:

INITIAL SITE SKETCH 1"=100'

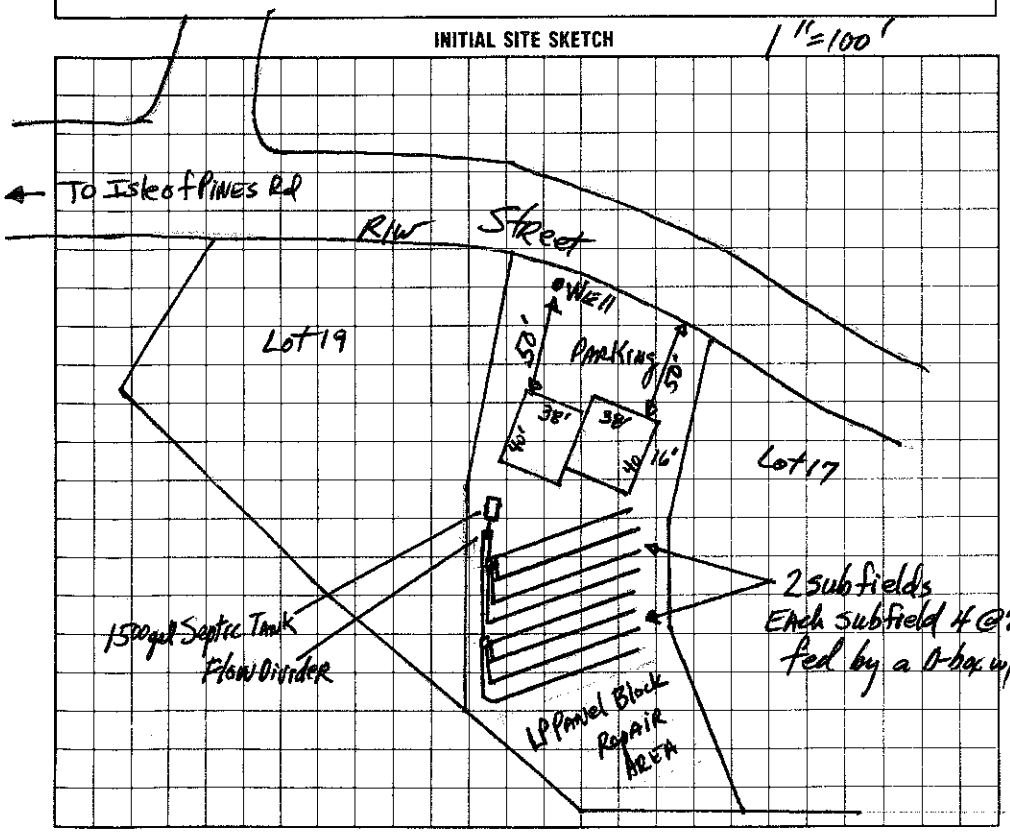

AS BUILT SKETCH

I understand that this permit can be suspended or revoked if any false information is supplied toward securing the permit/any unauthorized changes are made to the site/any unauthorized changes are made in the installation of the system.

Signed: Mark Reedy

Improvement Permit by: Jerry R. Hinson, IRS date 12-29-95

Existing System Inspection by: D R Hinson, IRS date 8-28-96

Authorization to reconstruct

Installed by: F J Erwin

Certificate of Completion by: date

Operation Permit by: Wesley Sparks RS date 2/12/97

HEALTH DEPT. COPY: WHITE INSPECTION COPY (FINAL): GREEN OWNER COPY (FINAL): YELLOW INSPECTION COPY (INITIAL): PINK OWNER COPY (INITIAL): GOLD