IREDELL COUNTY HEALTH DEPARTMENT

STATESVILLE 704-878-5305 MOORESVILLE 704-664-5281

IMPROVEMENT PERMIT / CERTIFICATE OF COMPLETION / OPERATION PERMIT / EXISTING SYSTEM INSPECTION

PROPERTY DESCRIPTION NO. 2165 DATE July 31, '95 TAX MAP NO. part of 2K B95 Watershed: ☑ Yes ☐ No

OWNER OR CONTRACTOR Bonanza Dev. Co. / Mark Needham PHONE: Business ~~Home~~ 4636-24-6856

ADDRESS PO Box 186, Mooresville

LOCATION Brawley Sch. Rd. TL Isle of Pines TL Double Eagle Dr. TL Birdie Ct. 2nd lot on left

SUBDIVISION Mallard Pines BLOCK / SECTION II LOT 9 LOT AREA .762 Ac SITE CLASS. RS per 1956 DESIGN FLOW 480gpd L.T.A.R. .3

Septic Tank: 1500 Gallons; STB 797 Date 5/28/96 ☑ New System ☐ Repair System Type: I, II, III, IV, V, VI

Pump Tank: _____ Gallons; PT _____ Date _____ System Description: gravity INFILTRATOR

Pump Make: _____ Model _____ Serial No. _____ Repair System Description: gravity RIBBS

Nitrification Field: No Fields 2 Square Feet 1200 Linear Feet 400 Maintenance Agreement Required: ☐ Yes ☑ No

No Lines 4+4 Trench Width 36" Max Trench Bottom Depth 36" Gravel Depth N/A

☐ House/Mod. Home No. Bedrooms 4
☐ Mobile Home No. Bathrooms 4
☐ Business No. Employees _____
☑ Other Duplex
☐ Slab ☑ Crawl Space ☐ Basement w/plumbing ☐ Basement wo/plumbing


Water Supply:
☑ Individual
☐ Community
☐ Public

Comments: Split flow w/ flow divider to 2 subfields, each having 200' of Infiltrator Laterals


Comments:

1" = 100'

INITIAL SITE SKETCH

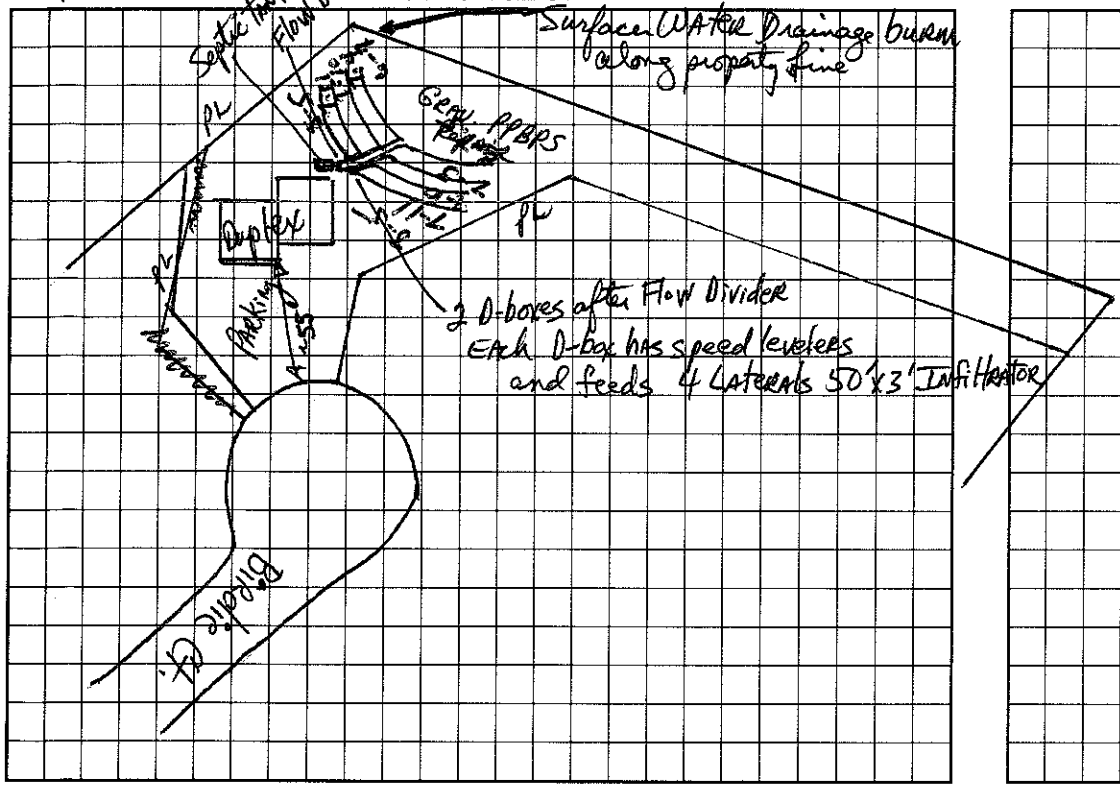

AS BUILT SKETCH

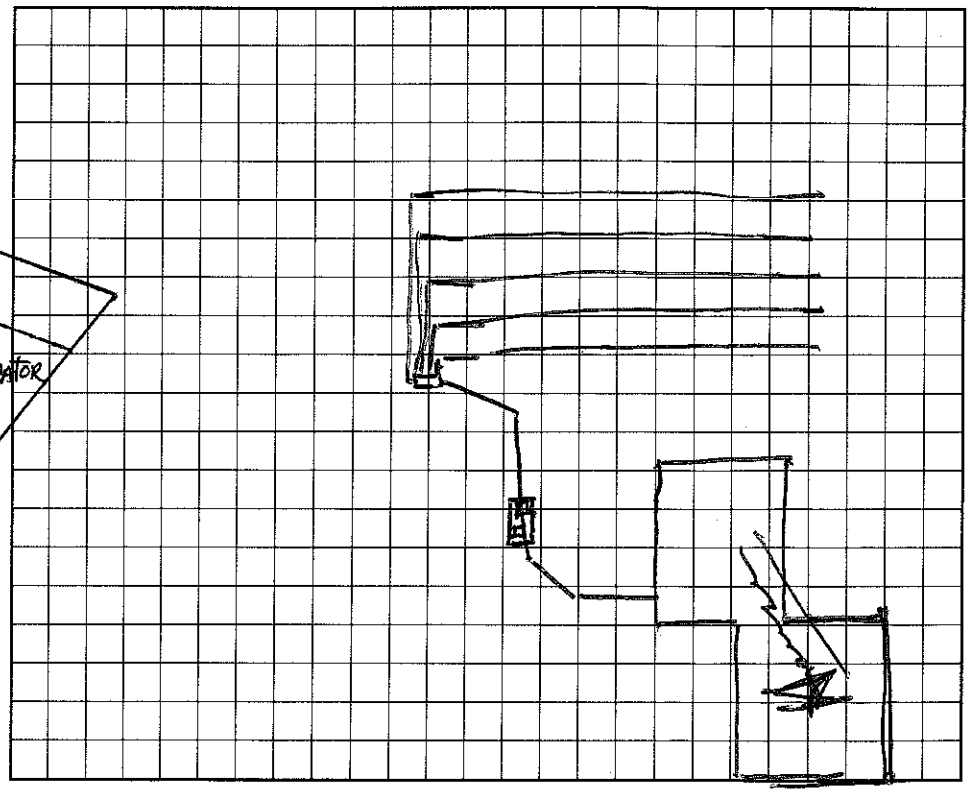

I understand that this permit can be suspended or revoked if any false information is supplied toward securing the permit/any unauthorized changes are made to the site/any unauthorized changes are made in the installation of the system.

Signed: _____

Improvement Permit by: _____ date 7-31-95

Existing System Inspection by: _____ date _____

Installed by: FJ Sawyer

Certificate of Completion by: _____ date _____

Operation Permit by: Wesley Sparks RS. date 7/18/96

HEALTH DEPT. COPY: WHITE INSPECTION COPY (FINAL): GREEN OWNER COPY (FINAL): YELLOW INSPECTION COPY (INITIAL): PINK OWNER COPY (INITIAL): GOLD