IREDELL COUNTY HEALTH DEPARTMENT

STATESVILLE 704-878-5305 MOORESVILLE 704-664-5281

IMPROVEMENT PERMIT / CERTIFICATE OF COMPLETION / OPERATION PERMIT / EXISTING SYSTEM INSPECTION

PROPERTY DESCRIPTION NO. 22000 DATE May 17, '96 TAX MAP NO. part of 2K B45 Watershed: ☑ Yes ☐ No

OWNER OR CONTRACTOR Bonanza Dev. Co. PHONE: Business ~~Home~~ 4636-24-7169

ADDRESS PO Box 1186, Mooresville

LOCATION Brawley Sch Rd. TL Isle of Pines TL Double Eagle Dr. on Right near end

SUBDIVISION Mallard Pines BLOCK / SECTION III LOT 17 LOT AREA 30,000 ft² SITE CLASS. PS on file DESIGN FLOW 720gpd L.T.A.R. .3

Septic Tank: 1500 Gallons; STB 338 Date 10/22/99

Pump Tank: _____ Gallons; PT _____ Date _____

Pump Make: _____ Model _____ Serial No. _____

Nitrification Field: No Fields 2 Square Feet 1800 Linear Feet 600

No Lines 5+3 Trench Width 36" Max Trench Bottom Depth ≈ 24" Gravel Depth N/A

☑ New System ☐ Repair System Type: I, II, III, IV, V, VI

System Description: gravity chambered

Repair System Description: LPP BPS - off site

Maintenance Agreement Required: ☐ Yes ☑ No

☐ House/Mod. Home No. Bedrooms 6

☐ Mobile Home No. Bathrooms 5

☐ Business No. Employees _____

☑ Other Duplex Apt.


☑ Slab ☐ Crawl Space ☐ Basement w/plumbing ☐ Basement wo/plumbing

Water Supply: ☑ Individual ☐ Community ☐ Public

Comments:

Comments: 12/17 - Inspected Flow Dividers and 4 - 50'x3' LINES

INITIAL SITE SKETCH

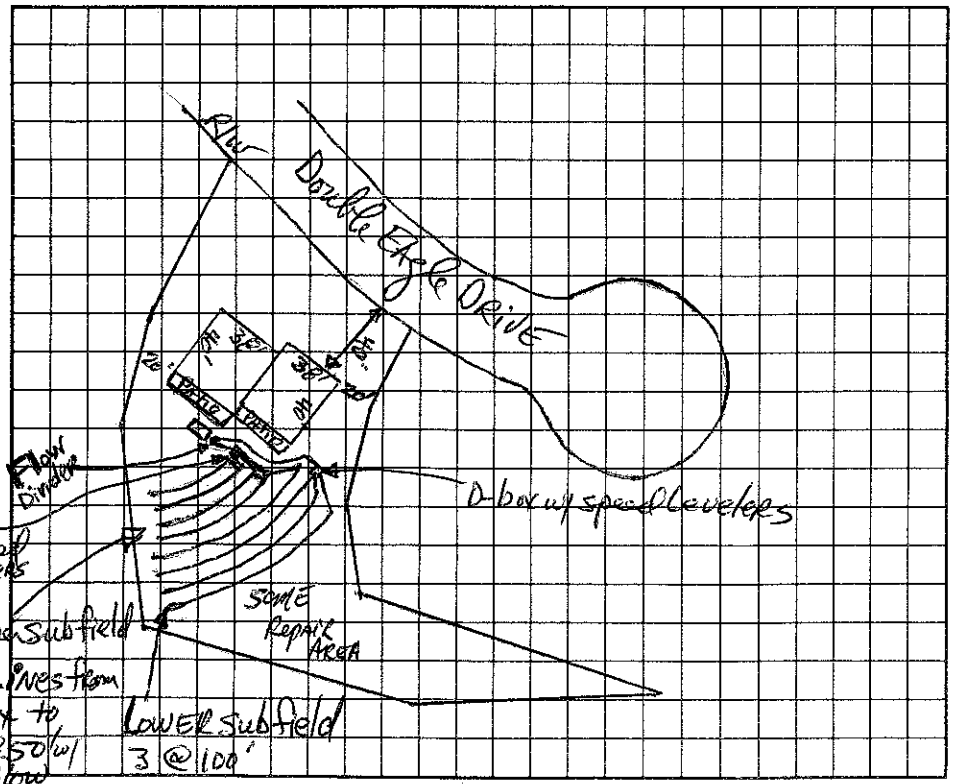

D-box w/spreaderlevelers

Upper Subfield 3 Lines from D-box to 4@50'w/ 2 flow Dividers & 1@100'

AS BUILT SKETCH

I understand that this permit can be suspended or revoked if any false information is supplied toward securing the permit/any unauthorized changes are made to the site/any unauthorized changes are made in the installation of the system.

Signed: Mark Meeks

Improvement Permit by: Marc Simpson, RS date 5-17-96

~~Existing System Inspection by:~~ Construction Authorization by: Marc Simpson RS date 8-28-96

Installed by: F J Erwin

Certificate of Completion by: _____ date _____

Operation Permit by: _____ RS date 12/23/99

HEALTH DEPT. COPY: WHITE INSPECTION COPY (FINAL): GREEN OWNER COPY (FINAL): YELLOW INSPECTION COPY (INITIAL): PINK OWNER COPY (INITIAL): GOLD