IREDELL COUNTY HEALTH DEPARTMENT

STATESVILLE 704-878-5305 MOORESVILLE 704-664-5281

IMPROVEMENT PERMIT / CERTIFICATE OF COMPLETION / OPERATION PERMIT / EXISTING SYSTEM INSPECTION

PROPERTY DESCRIPTION NO. 21999 DATE May 17, '96 TAX MAP NO. part of 2KB45 Watershed: ☑ Yes ☐ No

OWNER OR CONTRACTOR Bonanza Dev. Co PHONE: Business ~~Home~~ 463-24-8195

ADDRESS PO Box 186 Mooresville

LOCATION Buffalo Sch Rd. TL Isle of Pines TL Double Eagle Dr at End

SUBDIVISION Mallard Pines BLOCK / SECTION III LOT 16 LOT AREA 30,000 SF SITE CLASS. I Apr. 1996 DESIGN FLOW 480gpd L.T.A.R. .03

Septic Tank: 1500 Gallons; STB 797 Date 7-12-97
Pump Tank: ____ Gallons; PT ____ Date ____
Pump Make: ____ Model ____ Serial No. ____
Nitrification Field: No Fields 2 Square Feet 1200 Linear Feet 400
No Lines 4+5 Trench Width 36" Max Trench Bottom Depth ± 24" Gravel Depth NA

☑ New System ☐ Repair System Type: I. II. (III) IV. V. VI
System Description: gravity chambered
Repair System Description: LP PPBPS
Maintenance Agreement Required: ☐ Yes ☑ No initially

☐ House/Mod. Home No. Bedrooms 4
☐ Mobile Home No. Bathrooms 4
☐ Business No. Employees ____
☑ Other Duplex Apt
☑ Slab ☐ Crawl Space ☐ Basement w/plumbing ☐ Basement wo/plumbing


Water Supply: ☑ Individual ☐ Community ☐ Public (off site)

Comments: OK to use Drop Boxes on subfields if installer desires.

Comments:

1" = 100'

INITIAL SITE SKETCH

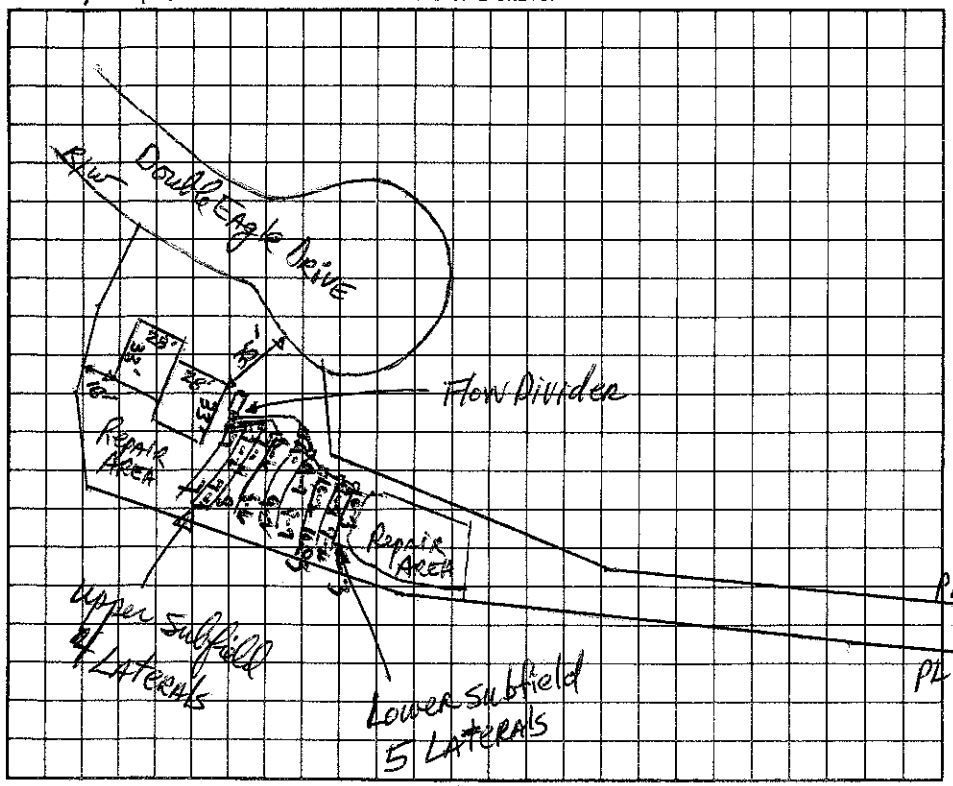

AS BUILT SKETCH

I understand that this permit can be suspended or revoked if any false information is supplied toward securing the permit/any unauthorized changes are made to the site/any unauthorized changes are made in the installation of the system.

Signed: [signature]

Improvement Permit by: [signature] date 5-17-96

~~Existing System Inspection by:~~ Construction Authorization by: [signature] date 8-28-96

Installed by: F.J Ervin

Certificate of Completion by: Wesley Sparks RS date 11/10/97

Operation Permit by: Wesley Sparks RS date 11/10/97

HEALTH DEPT. COPY: WHITE INSPECTION COPY (FINAL): GREEN OWNER COPY (FINAL): YELLOW INSPECTION COPY (INITIAL): PINK OWNER COPY (INITIAL): GOLD