IREDELL COUNTY HEALTH DEPARTMENT

STATESVILLE 704-878-5305 MOORESVILLE 704-664-5281

IMPROVEMENT PERMIT / CERTIFICATE OF COMPLETION / OPERATION PERMIT / EXISTING SYSTEM INSPECTION

PROPERTY DESCRIPTION NO. 21167 DATE July 31, 195 TAX MAP NO. part of 2K B45 Watershed: ☑ Yes ☐ No

OWNER OR CONTRACTOR Bonanza Dev. Co. / Mark Needham PHONE: Business / ~~Home~~ 4636-24-8679

ADDRESS PO Box 186 Mooresville

LOCATION Brawley Sch Rd. TL Isle of Pines TL Double Eagle Drive TL Birdie Ct. 1st lot on Right

SUBDIVISION Isle of Pines BLOCK / SECTION II 2D LOT 11 LOT AREA .728 AC SITE CLASS. PS per 1996 DESIGN FLOW 480 gpd L.T.A.R. .3

Septic Tank: 1500 Gallons; STB 797 Date 2/15/96

Pump Tank: _____ Gallons; PT _____ Date _____

Pump Make: _____ Model _____ Serial No. _____

Nitrification Field: No Fields 1 Square Feet 1200 Linear Feet 400

No Lines 4 @ 100' Trench Width 36" Max Trench Bottom Depth 36" Gravel Depth N/A

☑ New System ☐ Repair System Type: I, II, III, IV, V, VI

System Description: gravity Infiltrator

Repair System Description: SAME

Maintenance Agreement Required: ☐ Yes ☑ No

☑ House/Mod. Home No. Bedrooms 4

☐ Mobile Home No. Bathrooms 4

☐ Business No. Employees ____

☑ Other Duplex Apt.

☐ Slab ☑ Crawl Space ☐ Basement w/plumbing ☐ Basement wo/plumbing


Water Supply: ☑ Individual ☐ Community ☐ Public

Comments: follow contour w/ laterals


Comments:

1" = 100'

INITIAL SITE SKETCH

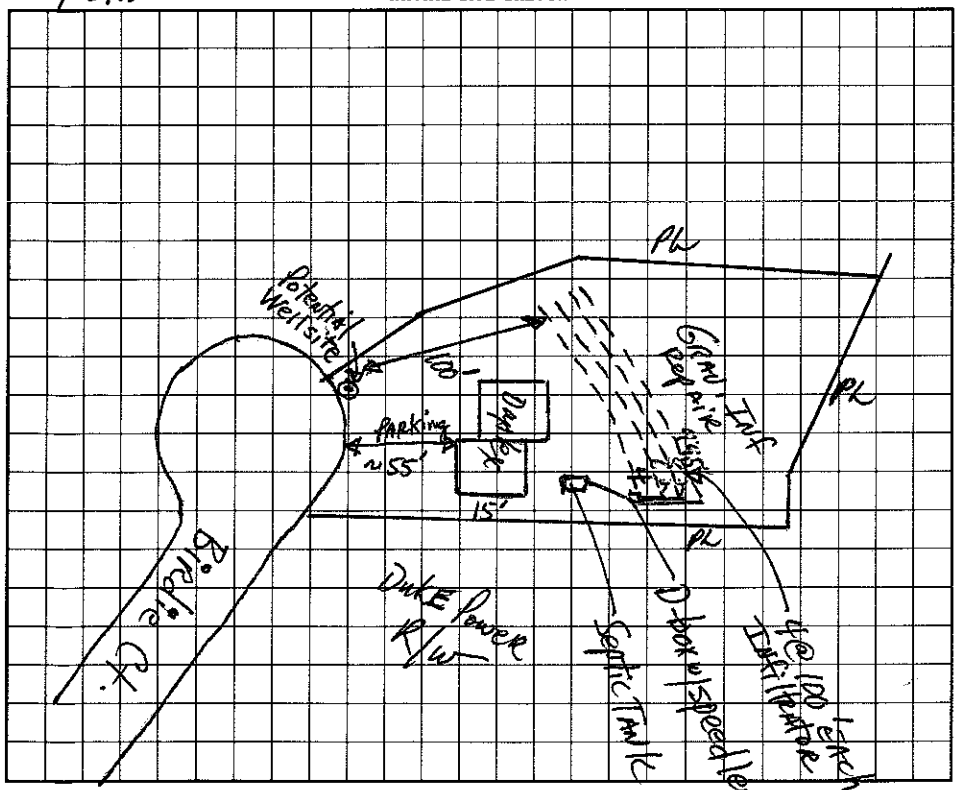

AS BUILT SKETCH

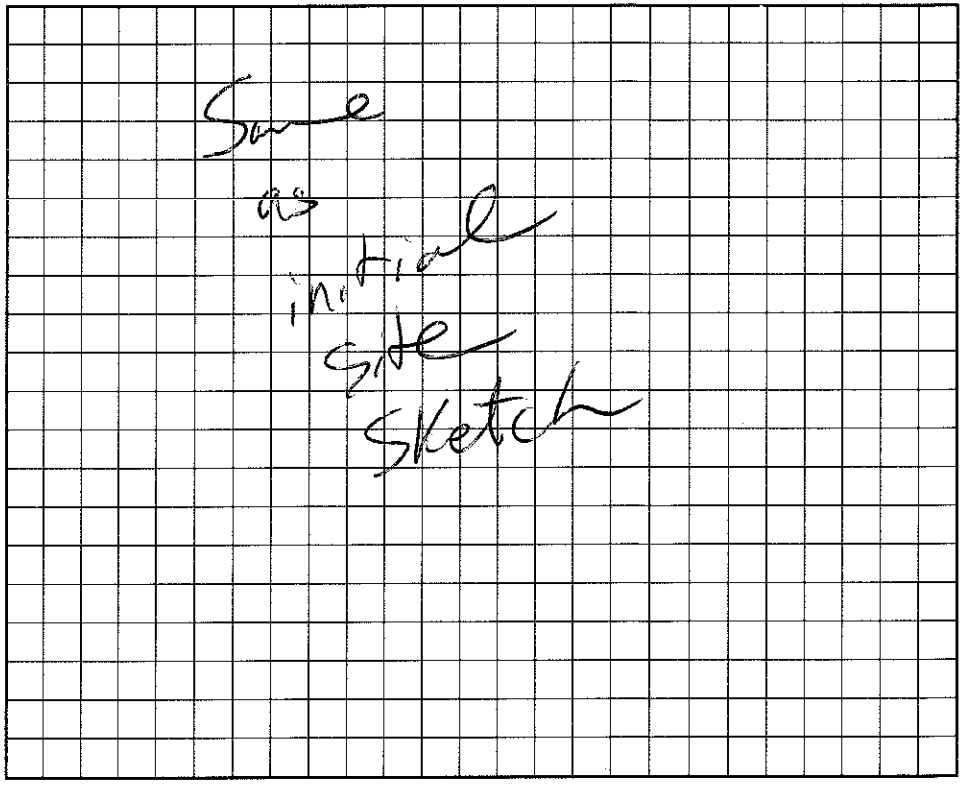

I understand that this permit can be suspended or revoked if any false information is supplied toward securing the permit/any unauthorized changes are made to the site/any unauthorized changes are made in the installation of the system.

Signed: [signature]

Improvement Permit by: [signature], RS date 7-31-95

Existing System Inspection by: _____ date _____

Installed by: FJ Ervin

Certificate of Completion by: _____ date _____

Operation Permit by: C. Brady Thomas EHSI date 4/10/96

HEALTH DEPT. COPY: WHITE INSPECTION COPY (FINAL): GREEN OWNER COPY (FINAL): YELLOW INSPECTION COPY (INITIAL): PINK OWNER COPY (INITIAL): GOLD