# IREDELL COUNTY HEALTH DEPARTMENT

STATESVILLE 704-878-5305 MOORESVILLE 704-664-5281

## IMPROVEMENT PERMIT / AUTHORIZATION TO CONSTRUCT / OPERATION PERMIT / EXISTING SYSTEM INSPECTION

PERMIT# 110008 PIN# 4636-25-5307.4 4636250622 DATE May 22, 03

OWNER OR CONTRACTOR Ron Smith PHONE: Business Home

ADDRESS 792 McKendree Rd. Mooresville, N.C. 28117

LOCATION Bemley Sch. Rd. TL Isle of Pines TL Pine Mist on left 113 Pine Mist Dr.

SUBDIVISION Wispering Oaks BLOCK / SECTION LOT 4 LOT AREA .76Ac SITE CLASS PS DESIGN FLOW 480gpd L.T.A.R. .25-.3

Septic Tank: 1000 Gallons; STB 825 Date 12/22/04

Pump Tank: 1000 Gallons; PT 367 Date 11/22/04

Pump Make: Goulds Model WE0-511 Serial No. K04K4024

Nitrification Field: No Fields 1 Square Feet 1320 Linear Feet 440

No Lines 4@110' Trench Width 36" Max Trench Bottom Depth 36" Gravel Depth NA

☑ New System ☐ Repair System Type: I II III IV V VI

System Description: pm-25% Reduction LPP8BB

Repair System Description:

Maintenance Agreement Required: ☐ Yes ☑ No (Verbally)

☑ House/Mod. Home No. Bedrooms 4

☐ Mobile Home No. Bathrooms 3

☐ Business No. Employees

☐ Other

☐ Slab ☑ Crawl Space ☐ Basement w/plumbing ☐ Basement wo/plumbing


Water Supply: ☑ Individual ☐ Public ☐ Community

Comments:/Conditions:

Remove old burms / terraces

Comments:/Conditions:

INITIAL SITE SKETCH

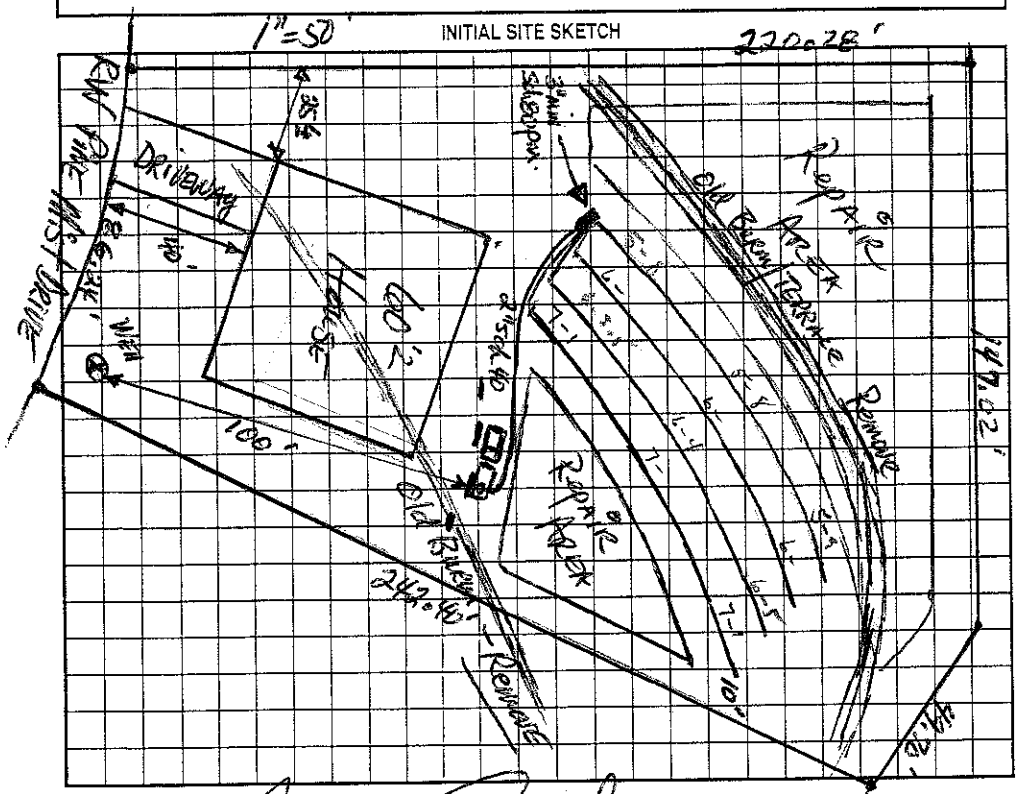


AS BUILT SKETCH

Permit can be suspended or revoked if any false information is supplied toward securing the permit/any unauthorized changes are made to the site/any unauthorized changes are made in the installation of the system. Improvement Permit with plat valid without expiration. Improvement Permit with site plan valid for sixty months. Authorization to Construct is valid for a period equal to that of Improvement Permit – not to exceed sixty months.

Signed: date 6-5-03

Improvement Permit by: date 5-22-03

Authorization to Construct by: Wesley Sparks R.S. date 8/25/04

Installed by: Joe Perkins

Operation Permit by: Wesley Sparks RS date 6.1.05

Existing System Inspection by: date

HEALTH DEPT. COPY: WHITE OWNER COPY (FINAL): YELLOW OWNER COPY (INITIAL): PINK