IREDELL COUNTY HEALTH DEPARTMENT

STATESVILLE 704-878-5305 / 130.00 MOORESVILLE 704-664-5281

IMPROVEMENT PERMIT / AUTHORIZATION TO CONSTRUCT / OPERATION PERMIT / EXISTING SYSTEM INSPECTION

PERMIT# 11050 PIN# 4636-25-5307.24 4636253285 DATE Sept 25, 03

OWNER OR CONTRACTOR Ron Smith / KRALOVIC CONST. PHONE: Business Home

ADDRESS 130 Lisa Nutt Rd. Mooresville, N.C. 28117

LOCATION Brawley School Rd TL Isle of Pines TL Pine Mist TR Misty Meadows Ct. on Right

SUBDIVISION Whispering Oaks BLOCK / SECTION LOT 24 LOT AREA .69 Ac SITE CLASS PS DESIGN FLOW 480gpd L.T.A.R. .25-.3

Septic Tank: 1000 Gallons; STB 312 Date 4-7-03
Pump Tank: 1000 Gallons; PT 253 Date 3-25-03
Pump Make: Gould's Model PES1M Serial No.
Nitrification Field: No Fields 1 Square Feet 1320 Linear Feet 440
No Lines 4 @ 110' Trench Width 36" Max Trench Bottom Depth 36" Gravel Depth NA

☑ New System ☐ Repair System Type: I, II, III, IV, V, VI
System Description: PM 25% Reduction
Repair System Description: LPP
Maintenance Agreement Required: ☐ Yes ☑ No initially

☑ House/Mod. Home No. Bedrooms 4
☐ Mobile Home No. Bathrooms 3
☐ Business No. Employees
☐ Other
☐ Slab ☑ Crawl Space ☐ Basement w/plumbing ☐ Basement wo/plumbing


Water Supply: ☑ Individual ☐ Public ☐ Community

Comments:/Conditions:

Comments:/Conditions:


1"=50'

INITIAL SITE SKETCH

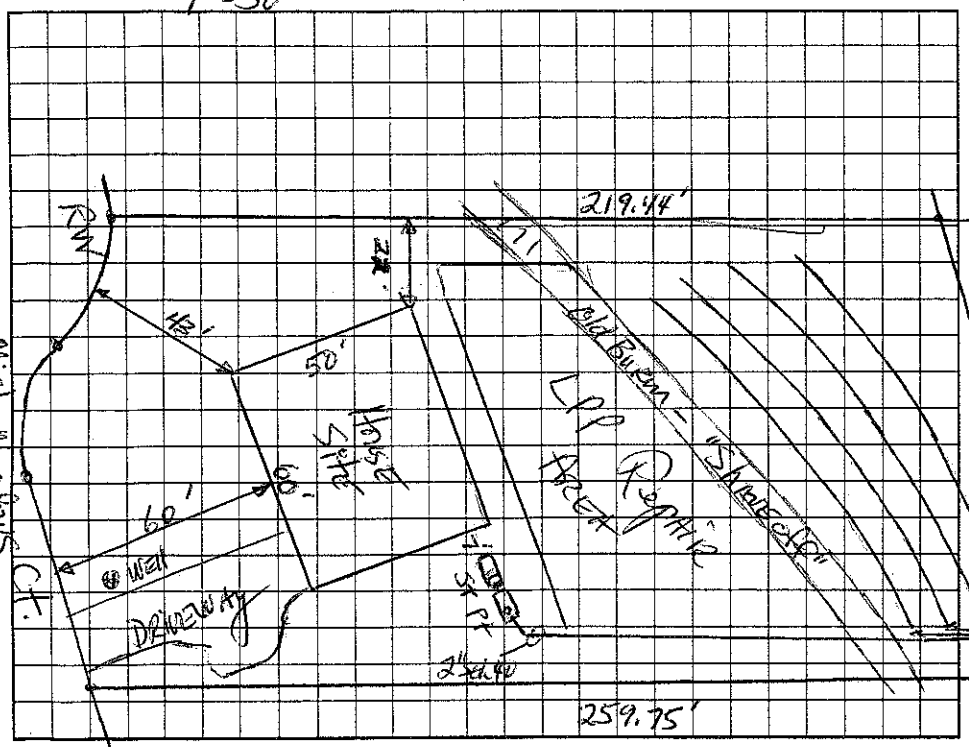

AS BUILT SKETCH

Tanks & Lines checked 5-18-07 - pressure head set ya

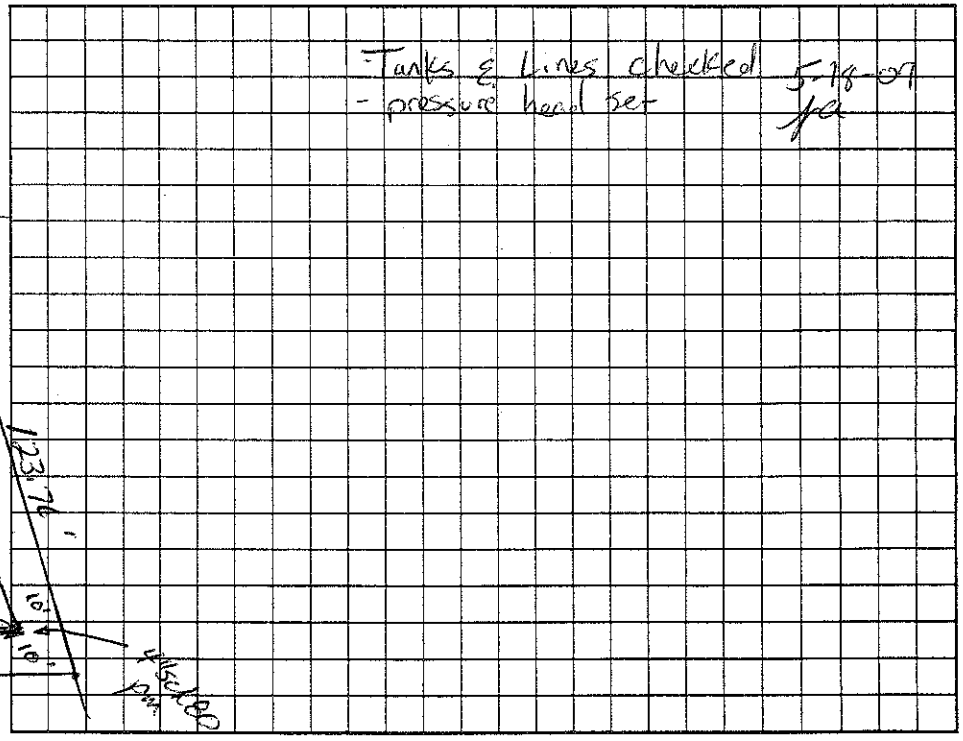

Permit can be suspended or revoked if any false information is supplied toward securing the permit/any unauthorized changes are made to the site/any unauthorized changes are made in the installation of the system. Improvement Permit with plat valid without expiration. Improvement Permit with site plan valid for sixty months. Authorization to Construct is valid for a period equal to that of Improvement Permit – not to exceed sixty months.

Signed: Ron A. Smith date 9-26-03 Installed by: Richard Abernathy

Improvement Permit by: Wesley Sparks RS date 9-25-03 Operation Permit by: Wesley Sparks RS date 11/13/07

Authorization to Construct by: Wesley Sparks RS date 6/2/06 Existing System Inspection by: date

HEALTH DEPT. COPY: WHITE OWNER COPY (FINAL): YELLOW OWNER COPY (INITIAL): PINK