# IREDELL COUNTY HEALTH DEPARTMENT

STATESVILLE 704-878-5305 130.00 Paid MOORESVILLE 704-664-5

## IMPROVEMENT PERMIT / AUTHORIZATION TO CONSTRUCT / OPERATION PERMIT / EXISTING SYSTEM INSPECTION

PERMIT# 129820 PIN# 4636 25 6169

OWNER OR CONTRACTOR Kempie Lee & Lee A. Smith / Wayne E. & Marie Y. Bozier DATE July 19, 05

ADDRESS 1185 State Rd. Mooresville, 28117 / 10413 Cineal Ct. Huntersville NC. 28078 PHONE: Business _____ Home _____

LOCATION Brawley School Rd. TL Isle of Pines TL Pine Mist Dr. TR Misty Meadows Ct. 1st lot on left

SUBDIVISION Whispering Oaks BLOCK / SECTION _____ LOT 19 | 19A LOT AREA 1.67Ac ± SFE SITE CLASS. PSSFE DESIGN FLOW 480gpd L.T.A.R. .3 Initial / .2 Repair in SFE/PA

Septic Tank: 1000 Gallons: STB 1007 Date 4-10-06

Pump Tank: 1000 Gallons: PT 274 Date 4-12-06

Pump Make Little Giant Model 16EH Serial No. _____

Nitrification Field: No Fields 1 Square Feet 600/900 Linear Feet 320

No Lines 6@50 Trench Width 24" min/6'ctr Max Trench Bottom Depth 36" Gravel Depth NA

☒ New System ☐ Repair System Type: I, II, III, IV, V, VI

System Description: PM PPBPS

Repair System Description: PM/LP 25% Reduction

Maintenance Agreement Required: ☐ Yes ☒ No

☒ House/Mod. Home ☐ Mobile Home ☐ Business ☐ Other

No. Bedrooms 4 No. Bathrooms ____ No. Employees ____


Water Supply: ☒ Individual ☐ Public ☐ Community

☐ Slab ☒ Crawl Space ☐ Basement w/plumbing ☐ Basement wo/plumbing

Comments:/Conditions: OR ≤ 36" MAX 9"oc

Comments:/Conditions: Installed Essentially As Drawn - Tanks & Lines Checked 5/26/06 & 8/3/06 Pressure Checked 9/11/06

INITIAL SITE SKETCH

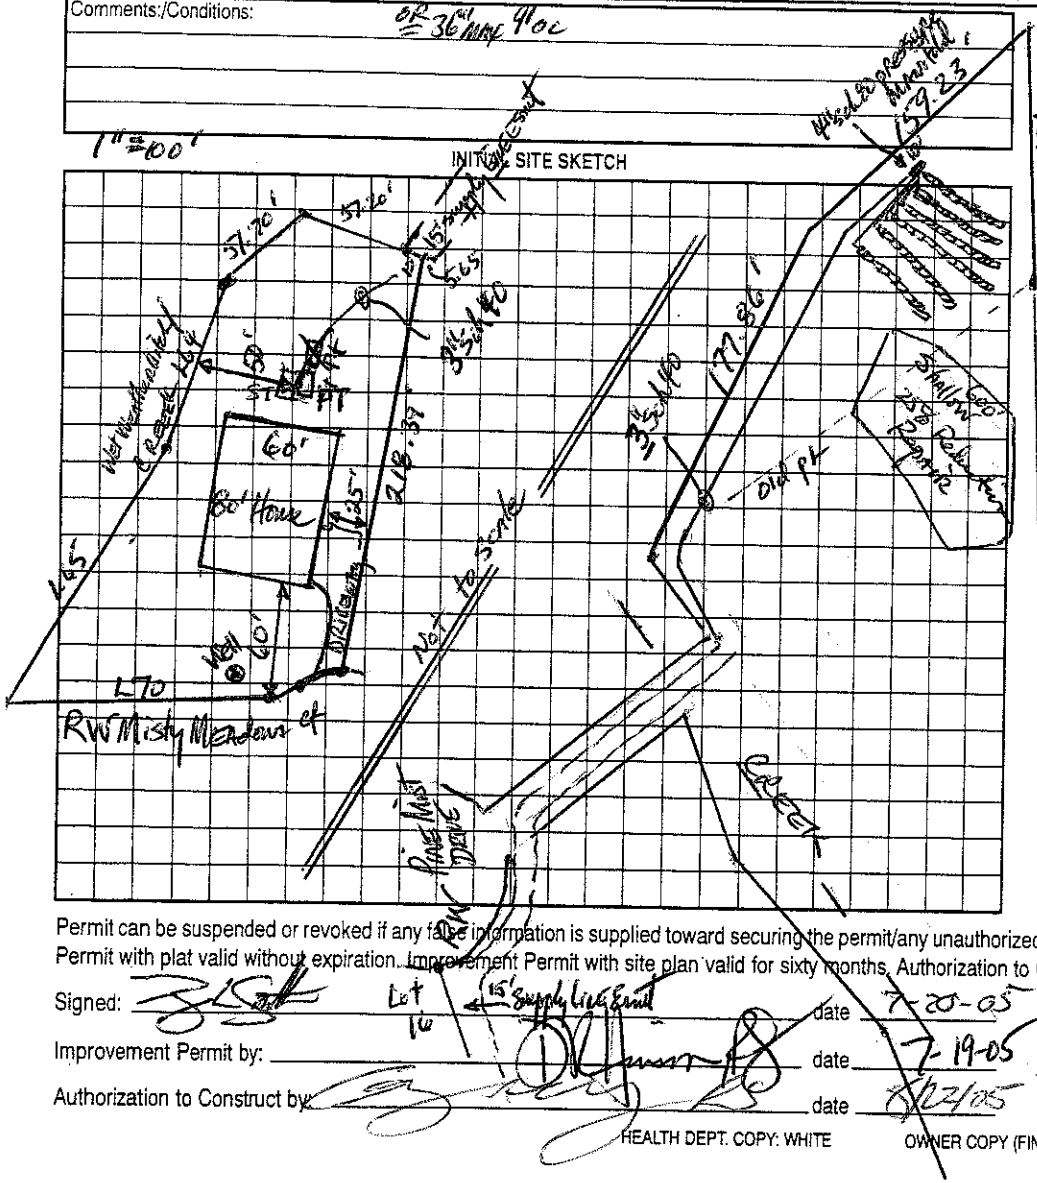


AS BUILT SKETCH

Permit can be suspended or revoked if any false information is supplied toward securing the permit/any unauthorized changes are made to the site/any unauthorized changes are made in the installation of the system. Improvement Permit with plat valid without expiration. Improvement Permit with site plan valid for sixty months. Authorization to Construct is valid for a period equal to that of Improvement Permit – not to exceed sixty months.

Signed: _____ date 7-20-05

Improvement Permit by: _____ date 7-19-05

Authorization to Construct by: _____ date 8/22/05

Installed by: Richard Hagerman

Operation Permit by: _____ date 9/18/06

Existing System Inspection by: _____ date _____

HEALTH DEPT. COPY: WHITE OWNER COPY (FINAL): YELLOW OWNER COPY (INITIAL): PINK