IREDELL COUNTY HEALTH DEPARTMENT

STATESVILLE 704-878-5305 195.00 Paid MOORESVILLE 704-664-5281

IMPROVEMENT PERMIT / AUTHORIZATION TO CONSTRUCT / OPERATION PERMIT / EXISTING SYSTEM INSPECTI

PERMIT# 11005 PIN# 4636-25-5307 4636-25-6592 DATE 4-14-05

OWNER OR CONTRACTOR Nex Homes PHONE: Business 704 902-5684 Home

ADDRESS P.O. Box 4390 Mooresville NC 28117

LOCATION Brawley School Rd TL Isle of Pines Rd TL Pine Mist Dr on left

SUBDIVISION Whispering Oaks BLOCK / SECTION LOT 8 LOT AREA .87 Acre SITE CLASS PS DESIGN FLOW 450 gpd L.T.A.R. .25-.3

Septic Tank: 1000 Gallons; STB 794 Date 11-28-04

Pump Tank: 1000 Gallons; PT 283 Date 3-22-05

Pump Make Little Giant Model 90H Serial No.

Nitrification Field: No Fields Square Feet 560' Linear Feet 280'

No Lines 4@70' Trench Width 36" Max Trench Bottom Depth 36" Gravel Depth N/A

☒ New System ☐ Repair System Type: I, II, III, IV, V

System Description: pump-LP-Panel Blk

Repair System Description: Same

Maintenance Agreement Required: ☒ Yes ☐ No

☒ House/Mod. Home ☐ Mobile Home ☐ Business ☐ Other

No. Bedrooms 4 No. Bathrooms 3.5 No. Employees


☐ Slab ☒ Crawl Space ☐ Basement w/plumbing ☐ Basement wo/plumbing

Water Supply: ☒ Individual ☐ Public ☐ Community

Comments:/Conditions:

Note: Replaces permit issued 6-4-03. House pad was over cut creating a bowl & reduced space for Drainfield. Must stay 15' from top of slope or cut >2Ft.

INITIAL SITE SKETCH

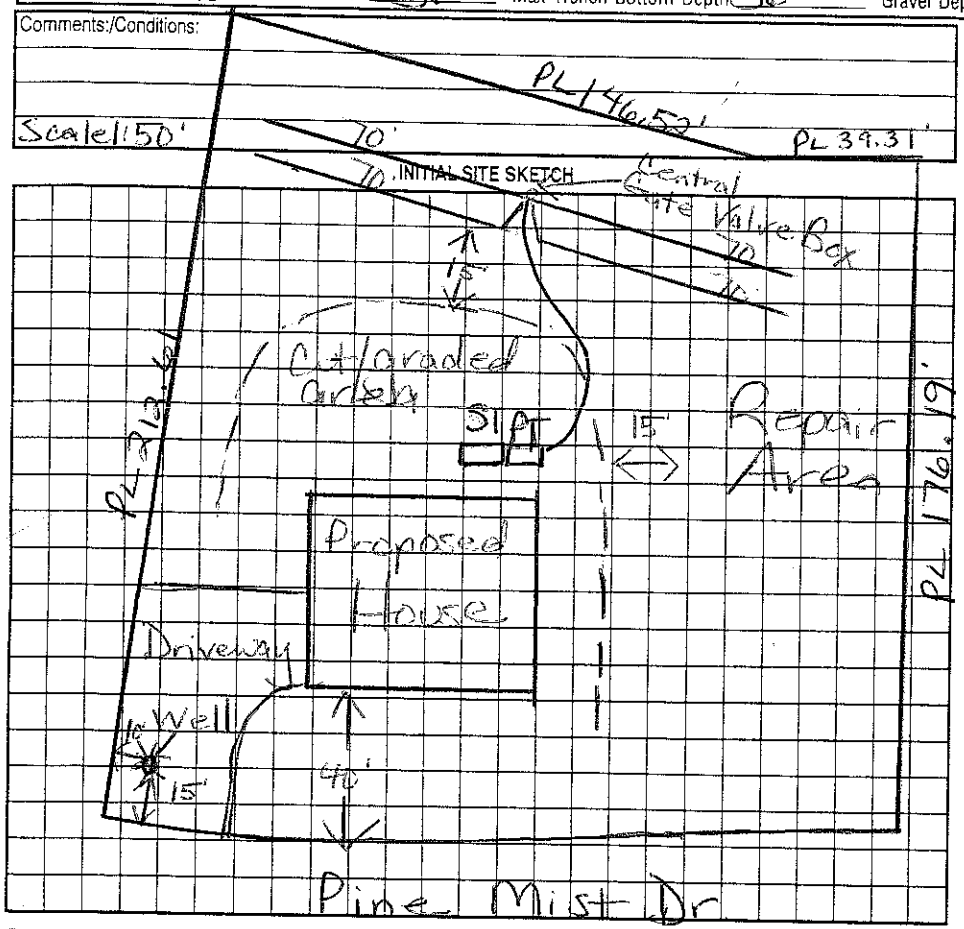

AS BUILT SKETCH

Installed Panel lines as drawn 4/29/05

Checked tanks also 4/29/05

5/32" hole drilled

Note: Builder will bring grade down so NEMA4X box is 12" above grade & riser 6" above grade

* Well Site Lot #9

Permit can be suspended or revoked if any false information is supplied toward securing the permit/any unauthorized changes are made to the site/any unauthorized changes are made in the installation of the system. Improvement Permit with plat valid without expiration. Improvement Permit with site plan valid for sixty months. Authorization to Construct is valid for a peric[illegible]rovement Permit – not to exceed sixty months.

Signed:

Improvement Permit by: Maria H. Dobson RS date 4-15-05

Authorization to Construct by: Maria H. Dobson RS date 4/14/05

Installed by:

Operation Permit by: Maria H. Dobson RS date 7/14/05

Existing System Inspection by: date

HEALTH DEPT. COPY: WHITE OWNER COPY (FINAL): YELLOW OWNER COPY (INITIAL): PINK