IREDELL COUNTY HEALTH DEPARTMENT

STATESVILLE 704-878-5305 145.00 Paid MOORESVILLE 704-664-5281

IMPROVEMENT PERMIT / AUTHORIZATION TO CONSTRUCT / OPERATION PERMIT / EXISTING SYSTEM INSPECTION

PERMIT# 110016 PIN# ~~4636-25-5307.9~~ 4636-25-8572 DATE 12/7/04

OWNER OR CONTRACTOR MKM Builders, LLC PHONE: Business 980-722-3345 Home 704-655-8590

ADDRESS 17014 Winged Thistle Davidson NC 28036

LOCATION BSR, TL Isle of Pines, TL Pine Mist, on Lt

SUBDIVISION Whispering Oaks BLOCK / SECTION ____ LOT 9 LOT AREA 0.694C SITE CLASS. PS DESIGN FLOW 480 L.T.A.R. 0.225

Septic Tank: 1000 Gallons; STB 755 Date ____
Pump Tank: 1000 Gallons; PT 32 Date ____
Pump Make: ____ Model ____ Serial No. ____
Nitrification Field: No Fields 1 Square Feet 1080 Linear Feet 360
No Lines 6@60' Trench Width 24"&FOC Max Trench Bottom Depth 36" Gravel Depth —

☒ New System ☐ Repair System Type: I, II, III, (IV), V, VI
System Description: LP Panel Block
Repair System Description: Same
Maintenance Agreement Required: ☒ Yes ☐ No


☒ House/Mod. Home No. Bedrooms 4
☐ Mobile Home No. Bathrooms ____
☐ Business No. Employees ____
☐ Other ____
☐ Slab ☒ Crawl Space ☐ Basement w/plumbing ☐ Basement wo/plumbing

Water Supply:
☒ Individual
☐ Public
☐ Community

Comments:/Conditions: 36" OR 9FOC
1" = 50'

Comments:/Conditions:

INITIAL SITE SKETCH

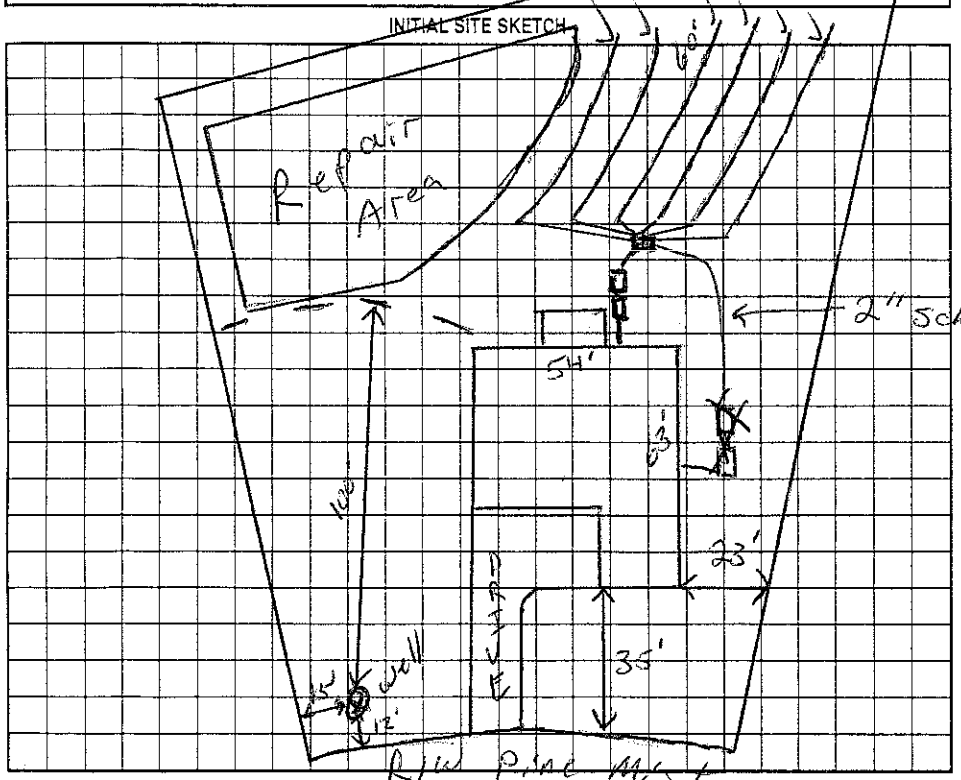

AS BUILT SKETCH

Permit can be suspended or revoked if any false information is supplied toward securing the permit/any unauthorized changes are made to the site/any unauthorized changes are made in the installation of the system. Improvement Permit with plat valid without expiration. Improvement Permit with site plan valid for sixty months. Authorization to Construct is valid for a period equal to that of Improvement Permit – not to exceed sixty months.

Signed: MK M date 12/8/04 Installed by: Corinthian

Improvement Permit by: RS date 12/7/04 Operation Permit by: Wesley Sparks R.S. date 7/27/05

Authorization to Construct by: RS date 12/7/04 Existing System Inspection by: ____ date ____

HEALTH DEPT. COPY: WHITE OWNER COPY (FINAL): YELLOW OWNER COPY (INITIAL): PINK