IREDELL COUNTY HEALTH DEPARTMENT - *ENVIRONMENTAL HEALTH* ☐ STATESVILLE OFFICE 704-[redacted] ☑ MOORESVILLE OFFICE 704-664-5281

IMPROVEMENT PERMIT / AUTHORIZATION TO CONSTRUCT / OPERATION PERMIT / EXISTING SYSTEM INSPECTION

PERMIT # 164305 PIN # 4626-86-3595 DATE 10-19-11

OWNER DAVID CONRAD APPLICANT: SAME PHONE: Home/Cell # 704-399-8729 Business #

SITE ADDRESS 212 POPLAR GROVE RD OWNER / APPLICANT ADDRESS 363 GRASSHOPPER CR

SITE DIRECTIONS BSR, TR POPLAR GROVE C END

SUBDIVISION POPLAR GROVE BLOCK / SECTION LOT # 8 LOT AREA .76AC DESIGN FLOW 360 L.T.A.R. .3

Septic Tank 1000 Gallons: STB Date

Pump Tank Gallons: P T Date

Pump Make Model Serial #

No. Nitrification Fields: 1 No. Lines 4 Linear Feet 200'

Trench Width 24-36" Max. Trench Bottom Depth 36" Gravel Depth SAND

☒ New System ☐ Repair ☐ Expansion System Type I II (III) IV V VI

System Description: GRAVITY PANEL BLOCK

Repair System Description: PUMP PANEL BLOCK

Maintenance Agreement Required ☐ YES ☒ NO

☒ GRAVITY ☐ PRESSURE

☒ Residence No. Bedrooms 3

☐ Business No. Persons

☐ Other No. Employees

☐ Slab ☐ Crawl Space

☐ Basement w/plumbing ☒ Basement w/o plumbing

Water Supply


☒ Private

☐ Public


☐ Community

Comments / Conditions

INITIAL SITE SKETCH

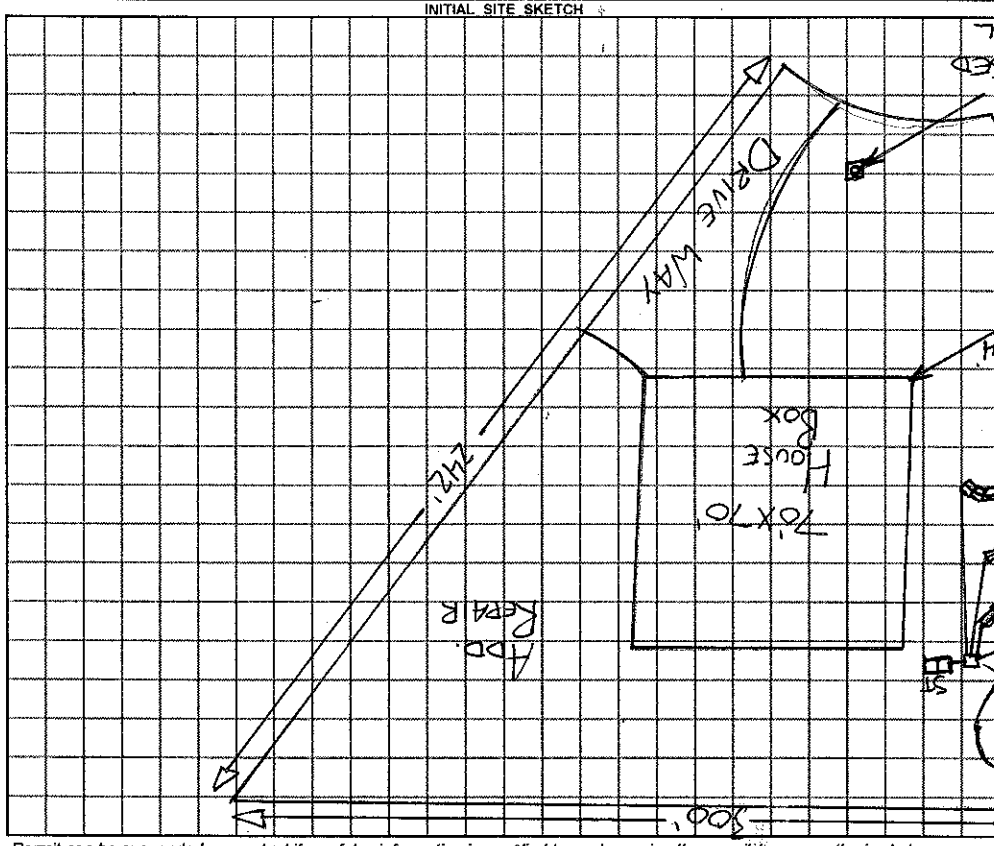

AS BUILT SKETCH

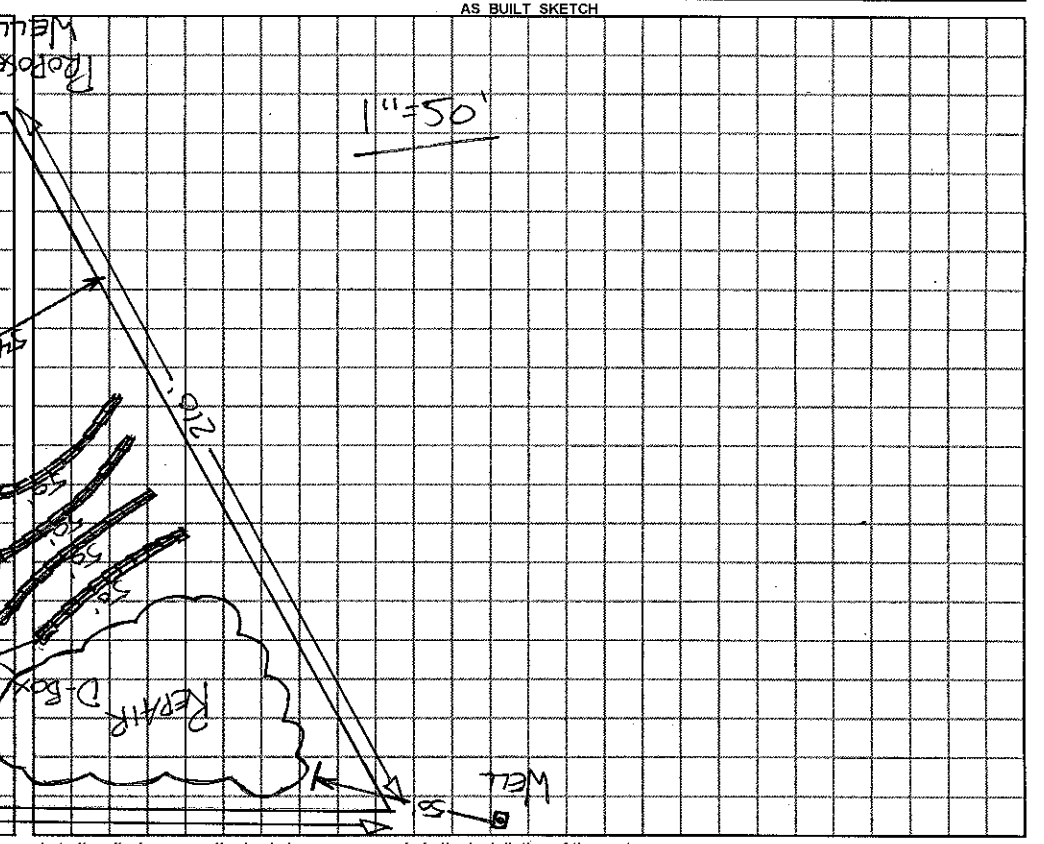

Permit can be suspended or revoked if any false information is supplied toward securing the permit / any unauthorized changes are made to the site / any unauthorized changes are made in the installation of the system.

☐ ***IMPROVEMENT PERMIT*** *with plat valid without expiration.* ☑ ***IMPROVEMENT PERMIT*** *with ~~plat valid without expiration.~~ site plan valid 60 mo.* ☐ ***AUTHORIZATION TO CONSTRUCT*** valid for period equal to IMPROVEMENT PERMIT--not to exceed 60 mo.

Owner / Applicant Signature: Date Installed by:

IMPROVEMENT PERMIT by: REHS Date 10-19-11 OPERATION PERMIT by: REHS Date

AUTHORIZATION TO CONSTRUCT by: REHS Date 11-1-11 Existing System Inspected by: REHS Date

YOU SHOULD CONTACT A LOCATOR SERVICE PRIOR TO ANY EXCAVATION

White Copy – Environmental Health YELLOW COPY (Final) Owner / Applicant PINK COPY (Initial) Owner / Applicant