IREDELL COUNTY HEALTH DEPARTMENT

Statesville Office (704) 878-5305 Mooresville Office (704) 660-3625 PERMIT # 200695

IMPROVEMENT PERMIT / AUTHORIZATION TO CONSTRUCT / OPERATION PERMIT / EXISTING SYSTEM

PIN # 4636-26-4858

APPLICANT: LEE LEVONOWSKI APPLICANT ADDRESS: 1206 BRAWLEY SCHOOL RD

SITE ADDRESS: SAME PHONE: 704-326-6167 ALT. PHONE:

SITE DIRECTIONS: BSR, PAST BLUME ON R

SUBDIVISION: SECTION: LOT # LOT AREA: 1.03AC DESIGN FLOW: 100 L.T.A.R.: .3

Septic Tank EXISTING (gal) STB Date

Pump Tank (gal) PT Date

Pump Make Model Serial #

Nitrification Fields # Lines (EXISTING) Linear Ft:

Trench Width Max. Trench Bottom Depth Gravel Depth

☐ New System ☐ Repair ☐ Expansion System Type: I (II) III IV V VI

System Description: GRAVEL BED 7½' X 50'

Repair System Description:

Maintenance Agreement Required: ☐ YES ☒ NO

☒ GRAVITY ☐ PRESSURE

☐ Residence ☒ Business ☐ Other ☐ Slab ☒ Basement w/plumbing


No. Bedrooms No. Persons 4 No. Employees 4 ☐ Crawl Space ☐ Basement w/o plumbing

Water Supply: ☒ Private ☐ Public ☐ Community

Comments / Conditions:

BOAT DEALERSHIP

INITIAL SITE SKETCH

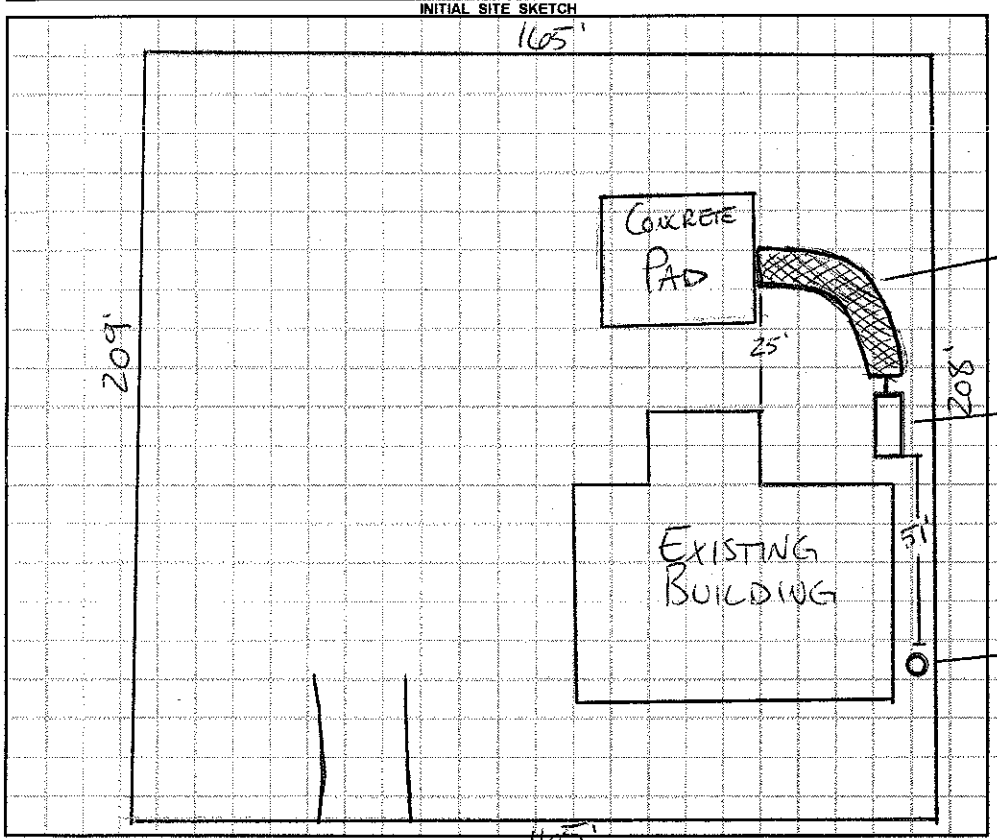

AS BUILT SKETCH

25 GPD / EMPLOYEE

4 EMPLOYEES TOTAL

=

100 GPD

Permit can be suspended or revoked if any false information is supplied toward securing the permit / any unauthorized changes are made to the site / any unauthorized changes are made in the installation of the system. **CONTACT A LOCATOR SERVICE PRIOR TO ANY EXCAVATION**

☐ **IMPROVEMENT PERMIT** *with plat valid without expiration.* ☐ **IMPROVEMENT PERMIT** *with site plan valid for 60 mos.* ☐ **AUTHORIZATION TO CONSTRUCT** *valid for period equal to IMPROVEMENT PERMIT--not to exceed 60 mo.*

Owner / Applicant Signature: Date: 4/17/14 Installed by:

IMPROVEMENT PERMIT by: Date: OPERATION PERMIT by: Date:

AUTHORIZATION TO CONSTRUCT by: Date: Existing System Inspected by: Date: APPROVED APR 17 2014

Health Dept. Copy - WHITE Applicant (Final Approval) - YELLOW Applicant (Conditional Approval) - PINK