11:00

IREDELL COUNTY HEALTH DEPARTMENT

STATESVILLE 704-878-5305 MOORESVILLE 704-664-5281

IMPROVEMENT PERMIT / AUTHORIZATION TO CONSTRUCT / OPERATION PERMIT / EXISTING SYSTEM INSPECTION

PERMIT# 19826 PIN# 2L-8-A-4 4636-27-1489 DATE 12/9/99

OWNER OR CONTRACTOR Greg Guentner PHONE: Business 634-7423 Home 896-8831

ADDRESS Ruby Rd. Mooresville, NC

LOCATION Brawley School Rd TR Blume Rd. TL Beechtree Tl Taylor Ct at end

SUBDIVISION Beechtree Forest BLOCK / SECTION ____ LOT 4 LOT AREA 1.7 Acre SITE CLASS. PS DESIGN FLOW 360 L.T.A.R. .35

Septic Tank: 1000 Gallons; STB 1012 Date 10-30-00
Pump Tank: 1000 Gallons; PT 17 Date 9-31-00
Pump Make: Myers Model ____ Serial No. ____
Nitrification Field: No. Fields 1 Square Feet 810' Linear Feet 270'
No Lines 5@55' Trench Width 36" Max Trench Bottom Depth 30-36" Gravel Depth N/A

[X] New System [ ] Repair System Type: I, II, III, IV, V, VI
System Description: Pumped - 25% Reduction
Repair System Description: Same
Maintenance Agreement Required: [ ] Yes [X] No


[X] House/Mod. Home No. Bedrooms 3
[ ] Mobile Home No. Bathrooms 2.5
[ ] Business No. Employees ____
[ ] Other ____
[ ] Slab [X] Crawl Space [ ] Basement w/plumbing [ ] Basement wo/plumbing

Water Supply: [X] Individual [ ] Public [ ] Community


Comments/Conditions: Keep Septic System 10' from PL & 5' From House (15' Sidegradient of Foundation drain & 25' upgradient of Foundation drain)

Comments/Conditions: Replaces permit issued 5/13/97 MS
Polylok Filter installed
Plastic Chamber Drainlines installed
Tanks, lines & pressure checked 3/2/2001 MS

INITIAL SITE SKETCH Scale 1:100

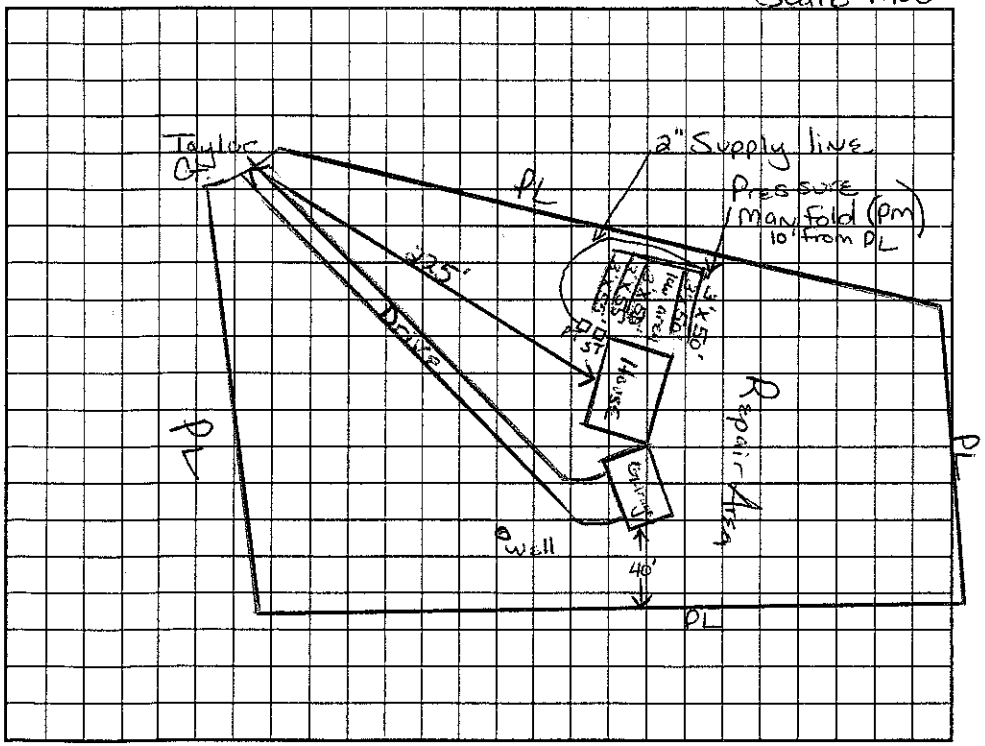

AS BUILT SKETCH

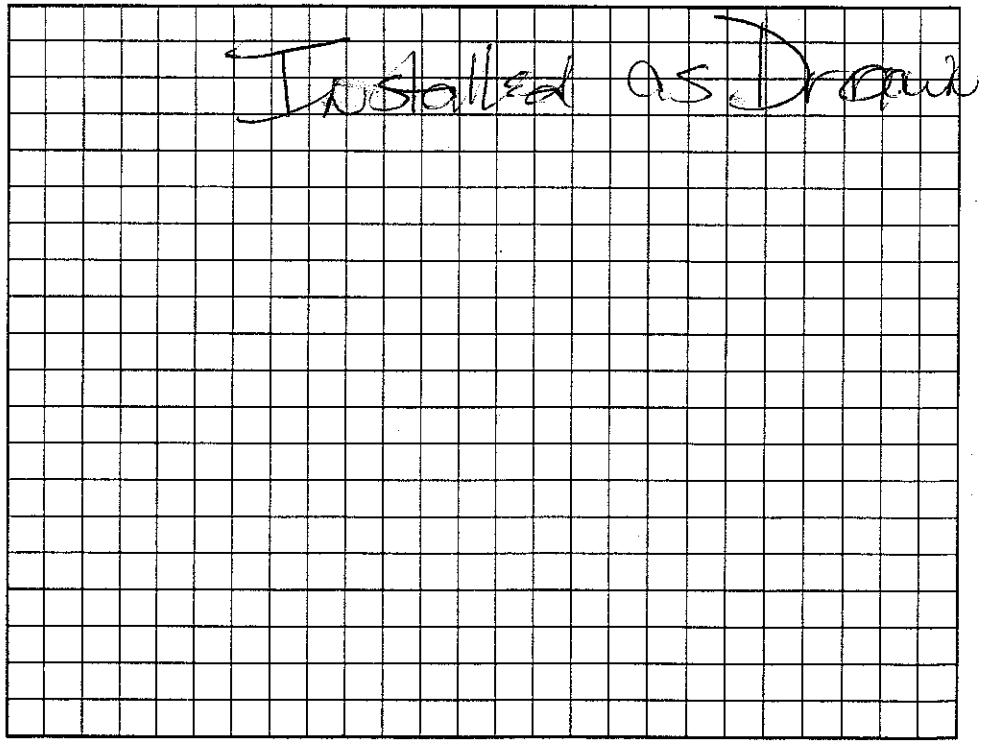

Permit can be suspended or revoked if any false information is supplied toward securing the permit/any unauthorized changes are made to the site/any unauthorized changes are made in the installation of the system. Improvement Permit with plat valid without expiration. Improvement Permit with site plan valid for sixty months. Authorization to Construct is valid for a period equal to that of Improvement Permit – not to exceed sixty months.

Signed: Linda K Guentner date 12/14/99 Installed by: Richard Abernathy

Improvement Permit by: Maint H.H. Dotson RS date 12/9/99 Operation Permit by: [signature] RS date 5/17/00

Authorization to Construct by: Maint H.H. Dotson RS date 12/9/99 Existing System Inspection by: ____ date ____

HEALTH DEPT. COPY: WHITE OWNER COPY (FINAL): YELLOW OWNER COPY (INITIAL): PINK