IREDELL COUNTY HEALTH DEPARTMENT

STATESVILLE 704-878-5305 MOORESVILLE 704-664-5281

IMPROVEMENT PERMIT / CERTIFICATE OF COMPLETION / OPERATION PERMIT / EXISTING SYSTEM INSPECTION

PROPERTY DESCRIPTION NO. 19825 DATE August 8, 95 TAX MAP NO. ~~4L 8A3~~ 4636 27 2683 Watershed: ☑ Yes ☐ No WS4

OWNER OR CONTRACTOR Moser Bros. PHONE: Business _____ Home _____

ADDRESS 119 Barber Loop, Mooresville

LOCATION Brawley Sch Rd. TR Blume, immediately TL Beechtree Rd. TL Taylor Ct. at end on left

SUBDIVISION Beechtree Forest BLOCK / SECTION _____ LOT 3 LOT AREA 1.129 Ac SITE CLASS. B DESIGN FLOW 360 gpd. L.T.A.R. N.35

Septic Tank: 1000 Gallons; STB ~~744~~ Date 9/26/96

Pump Tank: 1000 Gallons; PT 27 Date 10/21/96

Pump Make: _____ Model _____ Serial No. _____

Nitrification Field: No Fields 1 Square Feet 810 Linear Feet 270

No Lines 3@90' Trench Width 36" Max Trench Bottom Depth ≈ 30" Gravel Depth NA

☑ New System ☐ Repair System Type: I, II, III, IV, V, VI

System Description: pumped/pressure/INFILTRATOR

Repair System Description: _____

Maintenance Agreement Required: ☐ Yes ☑ No

☑ House/Mod. Home No. Bedrooms 3

☐ Mobile Home No. Bathrooms 2.5

☐ Business No. Employees _____

☐ Other _____

☐ Slab ☐ Crawl Space ☑ Basement w/plumbing ☐ Basement wo/plumbing


Water Supply: ☑ Individual ☐ Community ☐ Public

Comments: Laterals to follow contour - See me for details on pressure manifold.

Comments: UPPER 2 LINES CHECKED 11/21/96 CGF
TANKS CHECKED 12/5/96 CGF
270 (5.5" DRIP-LINE)

1" ≈ 100'

INITIAL SITE SKETCH

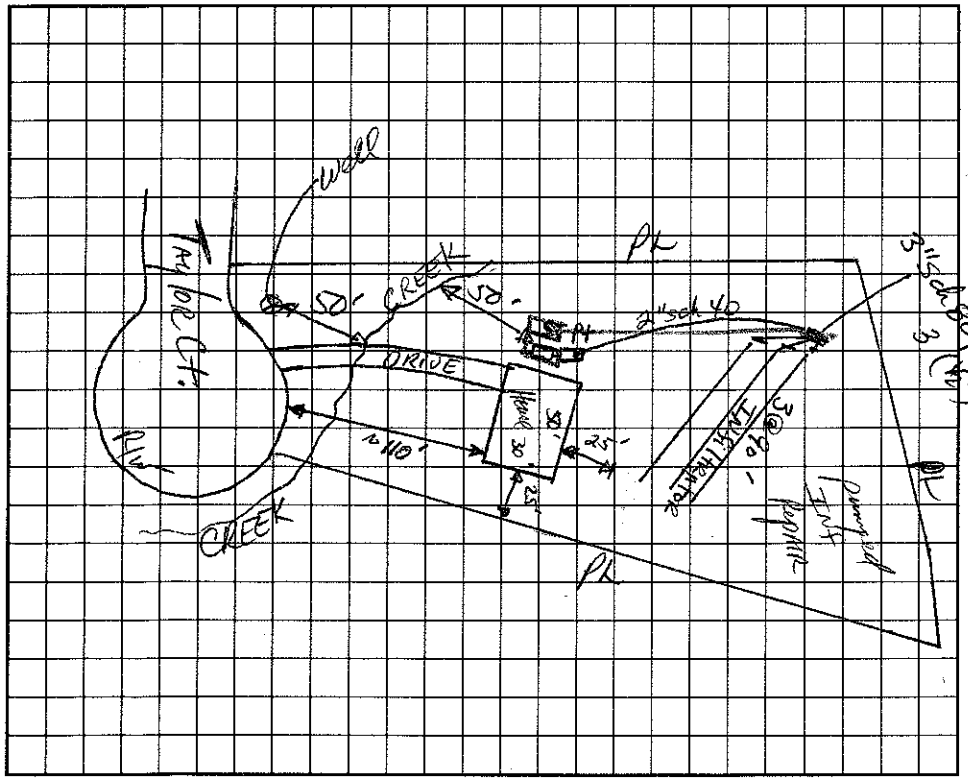

AS BUILT SKETCH

I understand that this permit can be suspended or revoked if any false information is supplied toward securing the permit/any unauthorized changes are made to the site/any unauthorized changes are made in the installation of the system.

Signed: X [illegible] Moser

Improvement Permit by: Harvey E. Hansen, RS date 8-8-95

~~Existing System Inspection by:~~ Auth to construct date 10-24-95

Installed by: BARRY THOMPSON

Certificate of Completion by: Wesley Sparks RS. date 8/4/97

Operation Permit by: Wesley Sparks RS. date 8/4/97

HEALTH DEPT. COPY: WHITE INSPECTION COPY (FINAL): GREEN OWNER COPY (FINAL): YELLOW INSPECTION COPY (INITIAL): PINK OWNER COPY (INITIAL): GOLD