IREDELL COUNTY HEALTH DEPARTMENT

STATESVILLE 704-878-5305 MOORESVILLE 704-664-5281

IMPROVEMENT PERMIT / AUTHORIZATION TO CONSTRUCT / OPERATION PERMIT / EXISTING SYSTEM INSPECTION

PERMIT# 132,695 20 PIN# 4636 27 2683 .000 ✓ DATE 12/20/05

OWNER OR CONTRACTOR Mark + Linda Roberts PHONE: Business 704 662 6119 Home

ADDRESS 115 Taylor Ct, Mooresville, NC 28117

LOCATION 1100 TR Beech Tree Rd. TR Taylor Ct. to house on (L) of cul de sac

SUBDIVISION Beech Tree Forest BLOCK / SECTION LOT 3 LOT AREA ~1.2 AC SITE CLASS. PS DESIGN FLOW 480 L.T.A.R. .3

Septic Tank: EXISTING Gallons; STB Date

Pump Tank: Gallons; PT Date

Pump Make: Model Serial No.

Nitrification Field: No Fields Square Feet Linear Feet 570

No Lines 7 Trench Width 3' Max Trench Bottom Depth 3' Gravel Depth No

☐ New System ☐ Repair System Type: I, II, (III), IV, V, VI

System Description: EXISTING

Repair System Description:

Maintenance Agreement Required: ☐ Yes ☐ No

☒ House/Mod. Home No. Bedrooms 4

☐ Mobile Home No. Bathrooms 4

☐ Business No. Employees

☐ Other


☐ Slab ☐ Crawl Space ☒ Basement w/plumbing ☐ Basement wo/plumbing

Water Supply: ☒ Individual ☐ Public ☐ Community


Comments:/Conditions:

Comments:/Conditions:

~~INITIAL SITE SKETCH~~ AS BUILT SKETCH

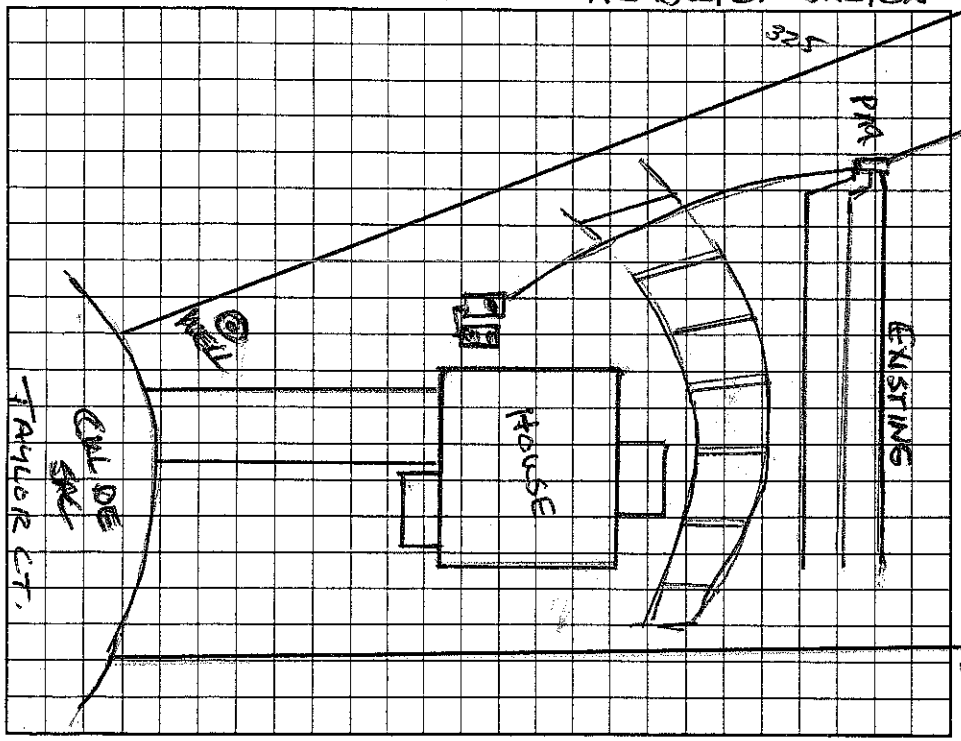

AS BUILT SKETCH

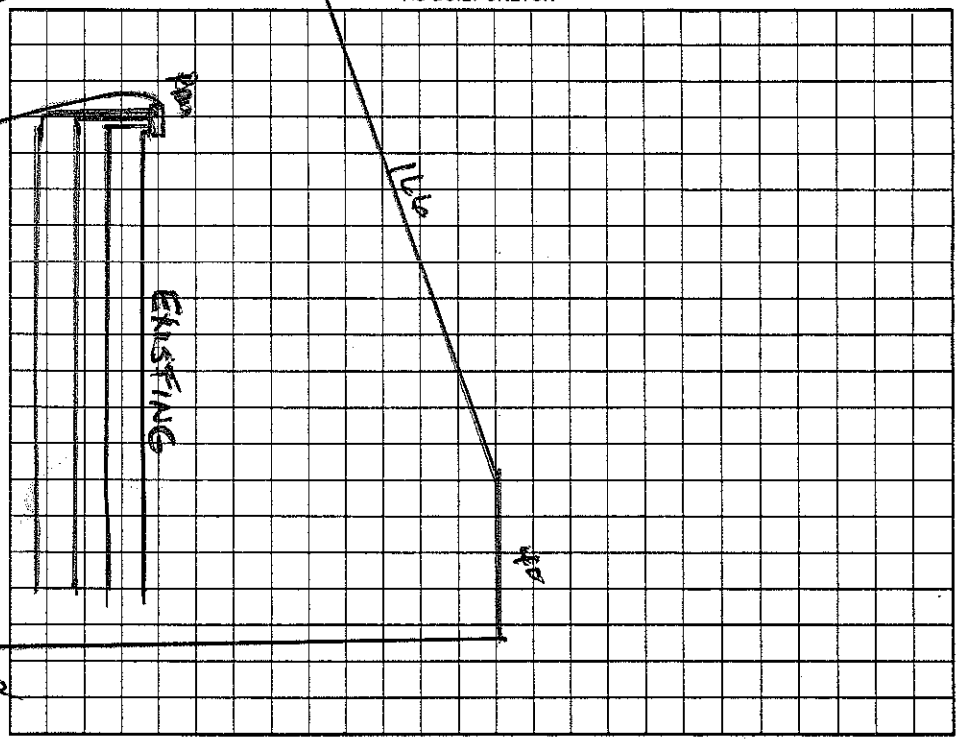

Permit can be suspended or revoked if any false information is supplied toward securing the permit/any unauthorized changes are made to the site/any unauthorized changes are made in the installation of the system. Improvement Permit with plat valid without expiration. Improvement Permit with site plan valid for sixty months. Authorization to Construct is valid for a period equal to that of Improvement Permit – not to exceed sixty months.

Signed: Alita J Mosen date 12/21/05 Installed by:

Improvement Permit by: date Operation Permit by: date

Authorization to Construct by: date Existing System Inspection by: Wesley Sparks R.S. date 12/20/05

HEALTH DEPT. COPY: WHITE OWNER COPY (FINAL): YELLOW OWNER COPY (INITIAL): PINK